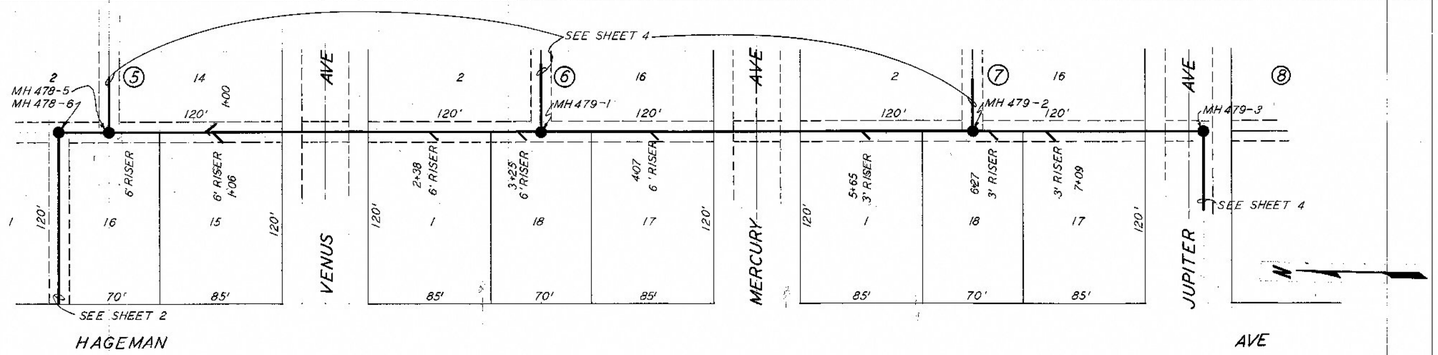

AS BUILT PLAN
BROWN & BROWN INC.
FEB. 1963

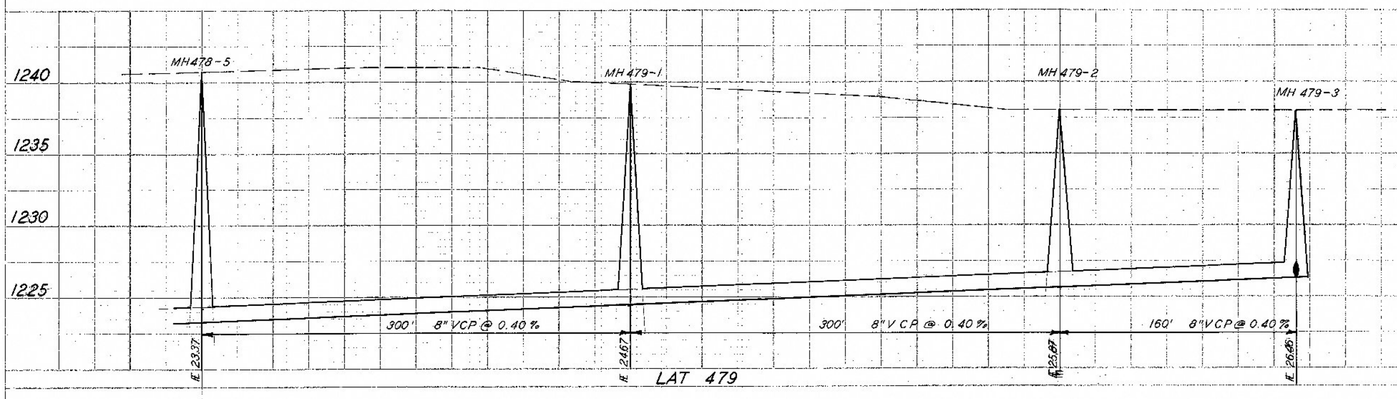

PLATE 2-PLAN-PROFILE S.T.D. & H.S. STANDARD
100% MAPPING VELLUM-MADE AND PRINTED IN U.S.A.
EUGENE DIETZGEN CO.

Sam. Sewer SHEET 3
Job 428