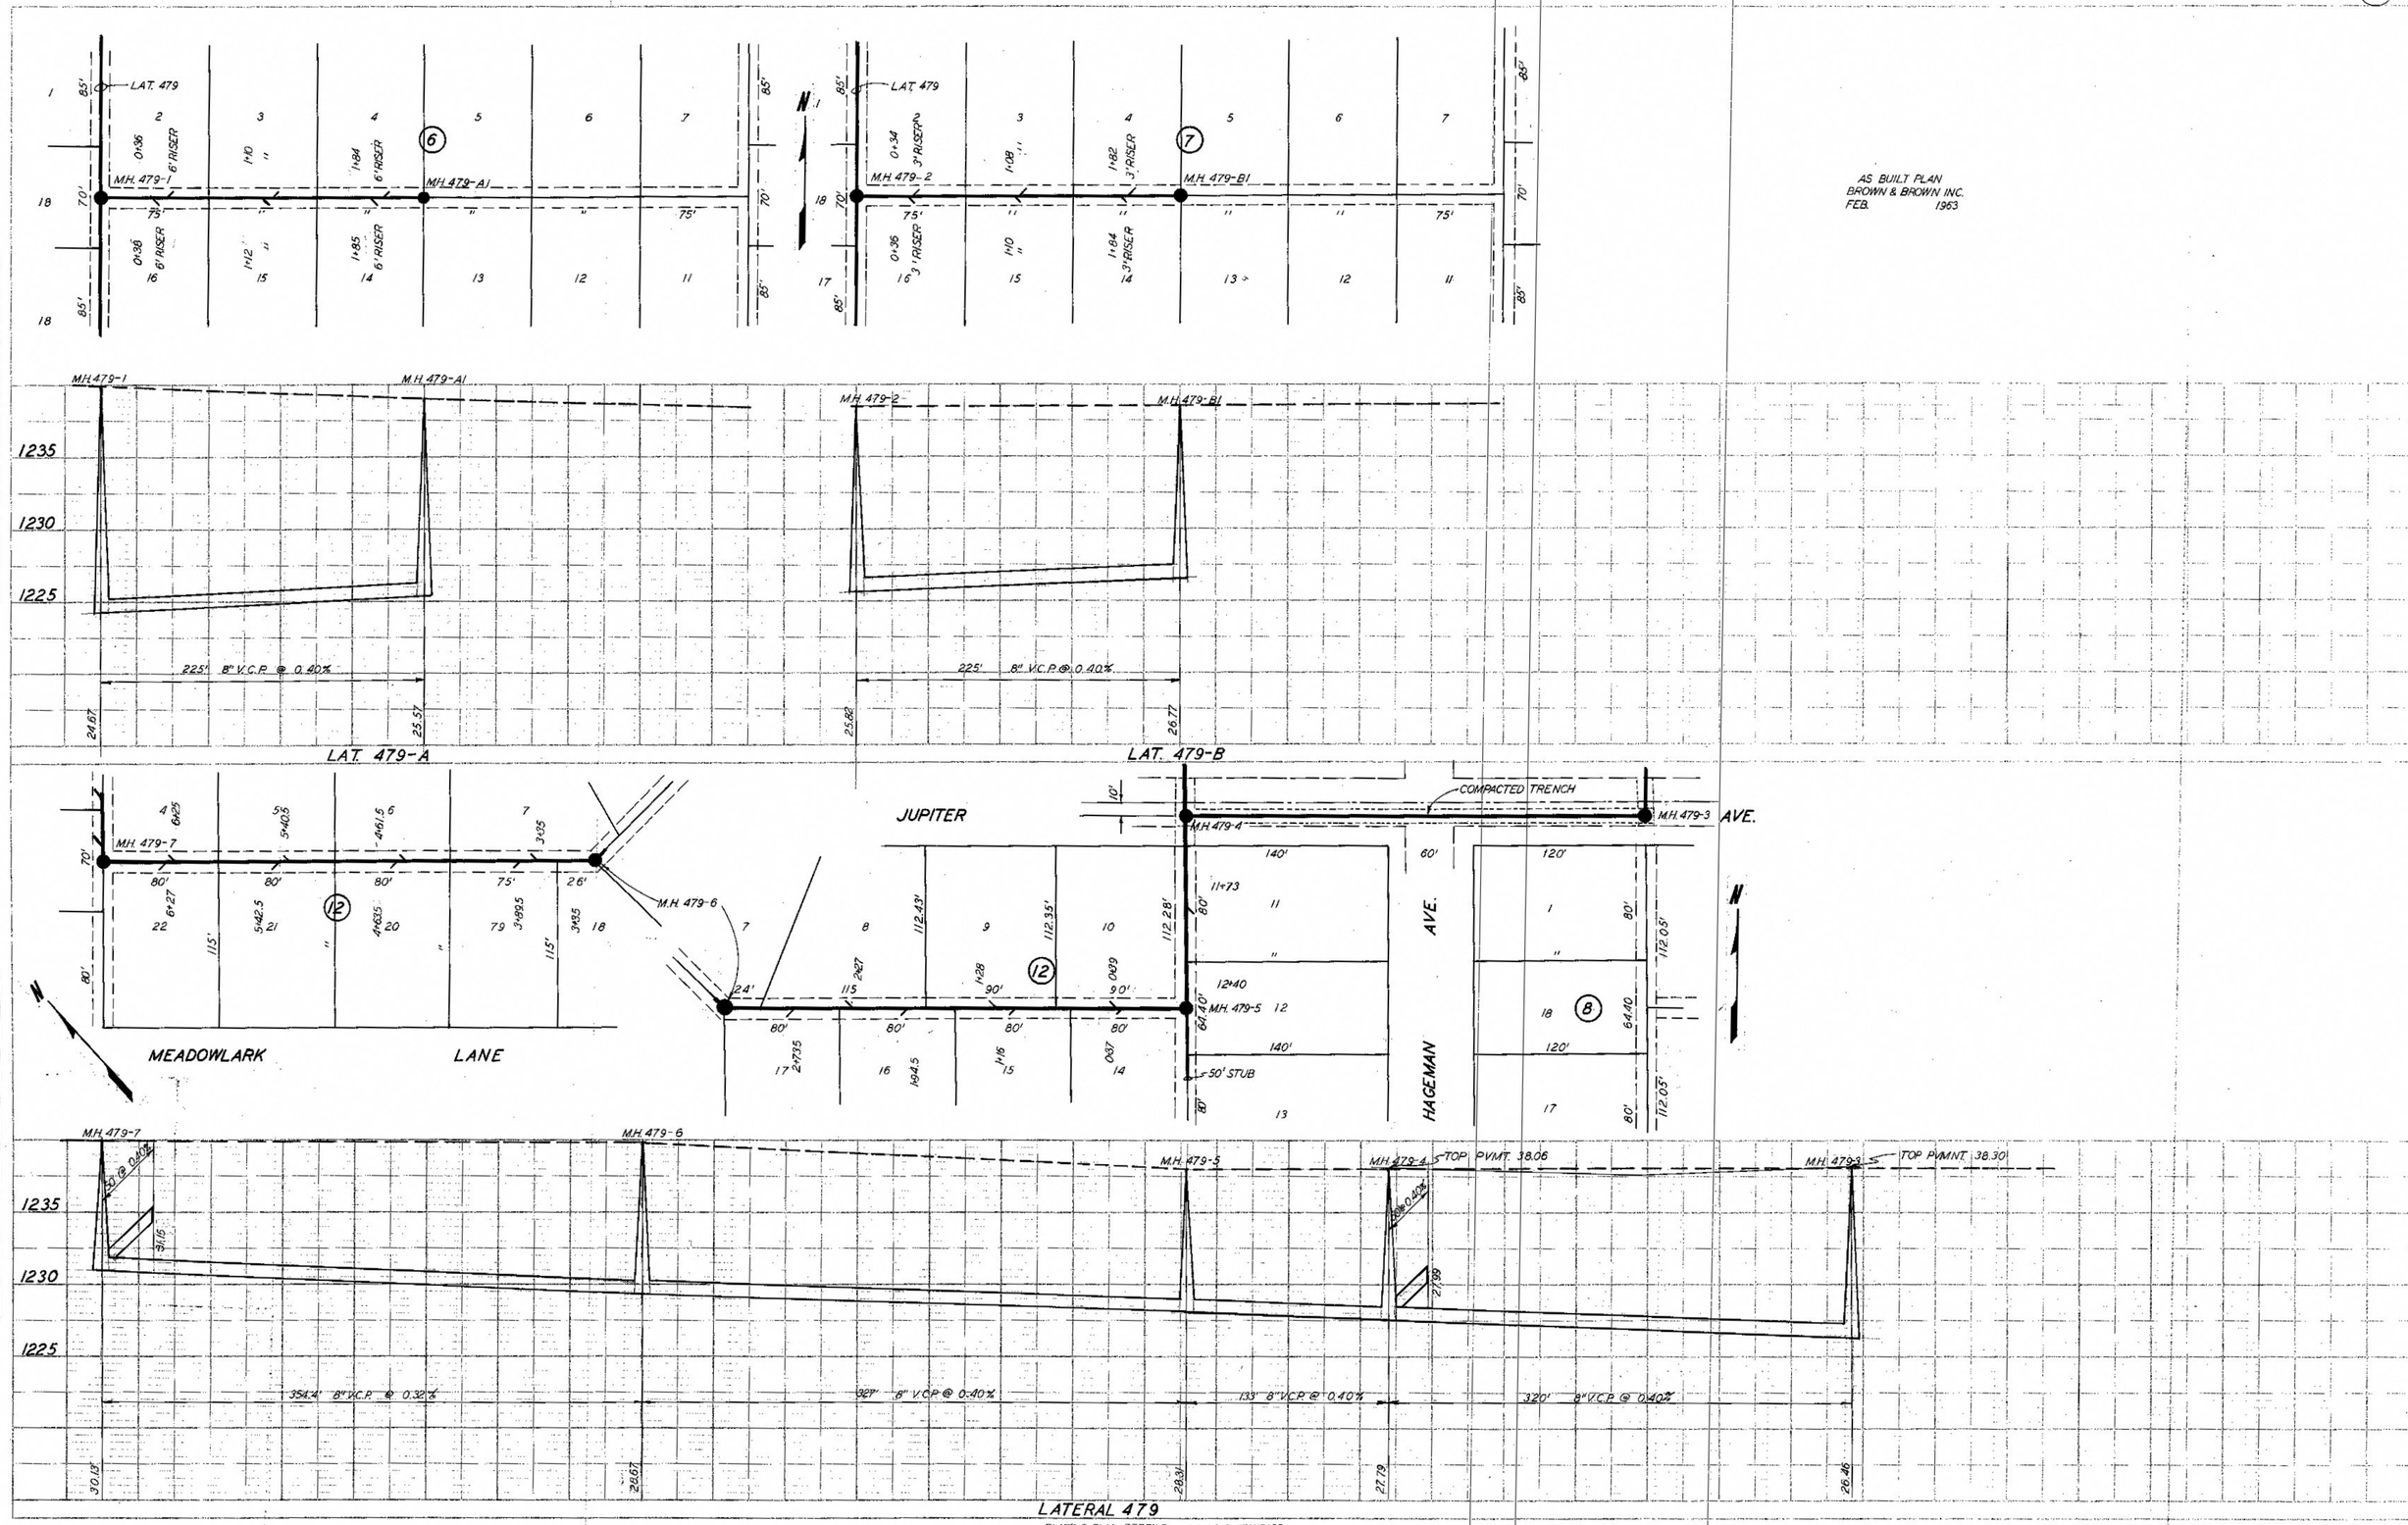

PLATE 2-PLAN-PROFILE C.A.P.W.A.&S.C. STANDARD

SHEET 4