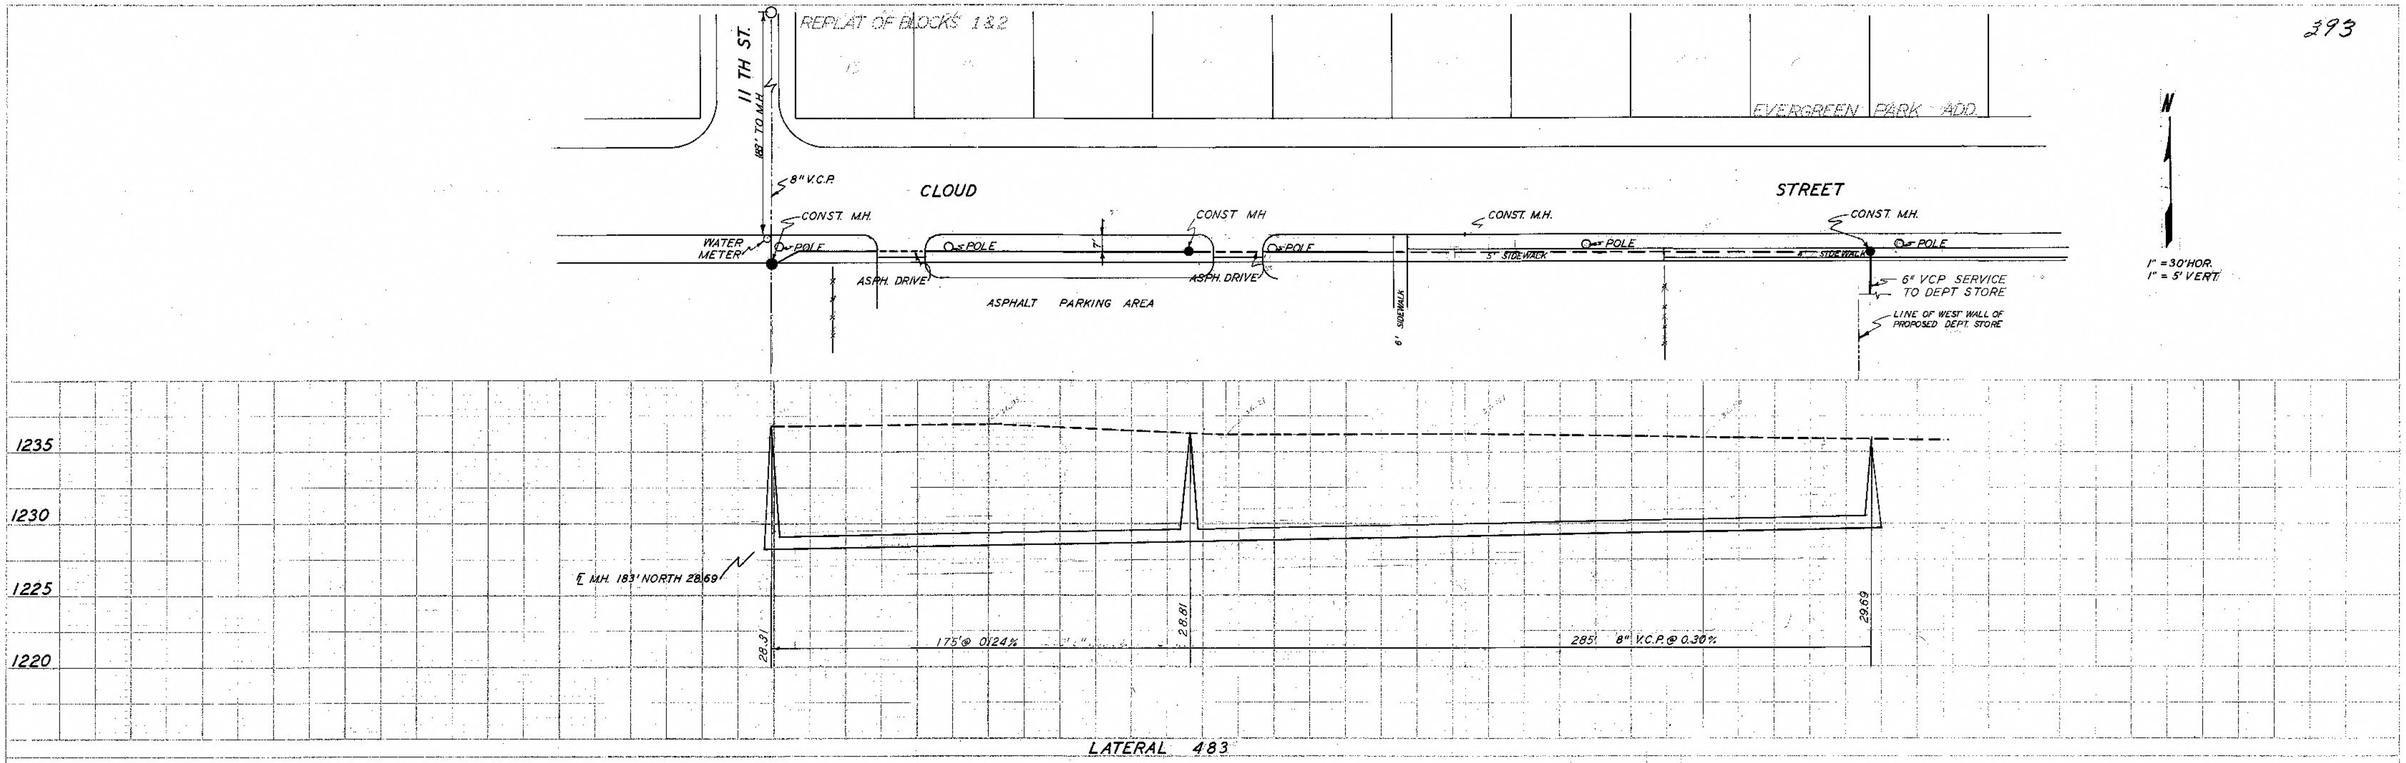

PLATE 2-PLAN-PROFILE C.P.&.E. STANDARD
100% ASSEMBLED BY WILLIAM HAGT AND PRINTED IN U.S.A.
EUGENE DIETZGEN CO.