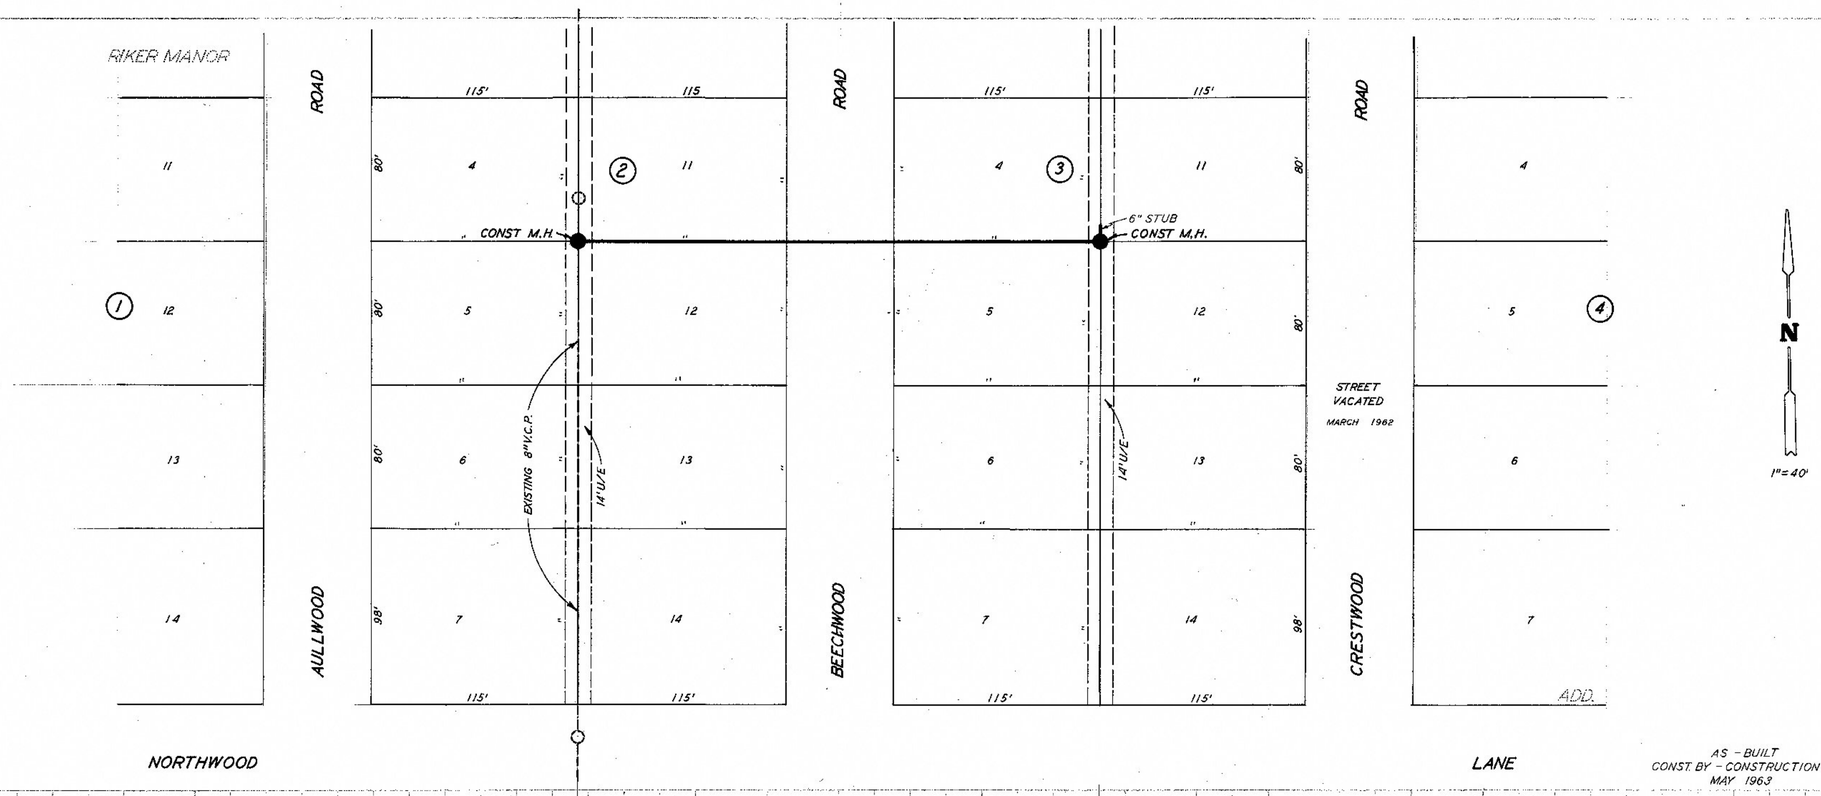

AS - BUILT
CONST. BY - CONSTRUCTION INDUSTRIES
MAY 1963

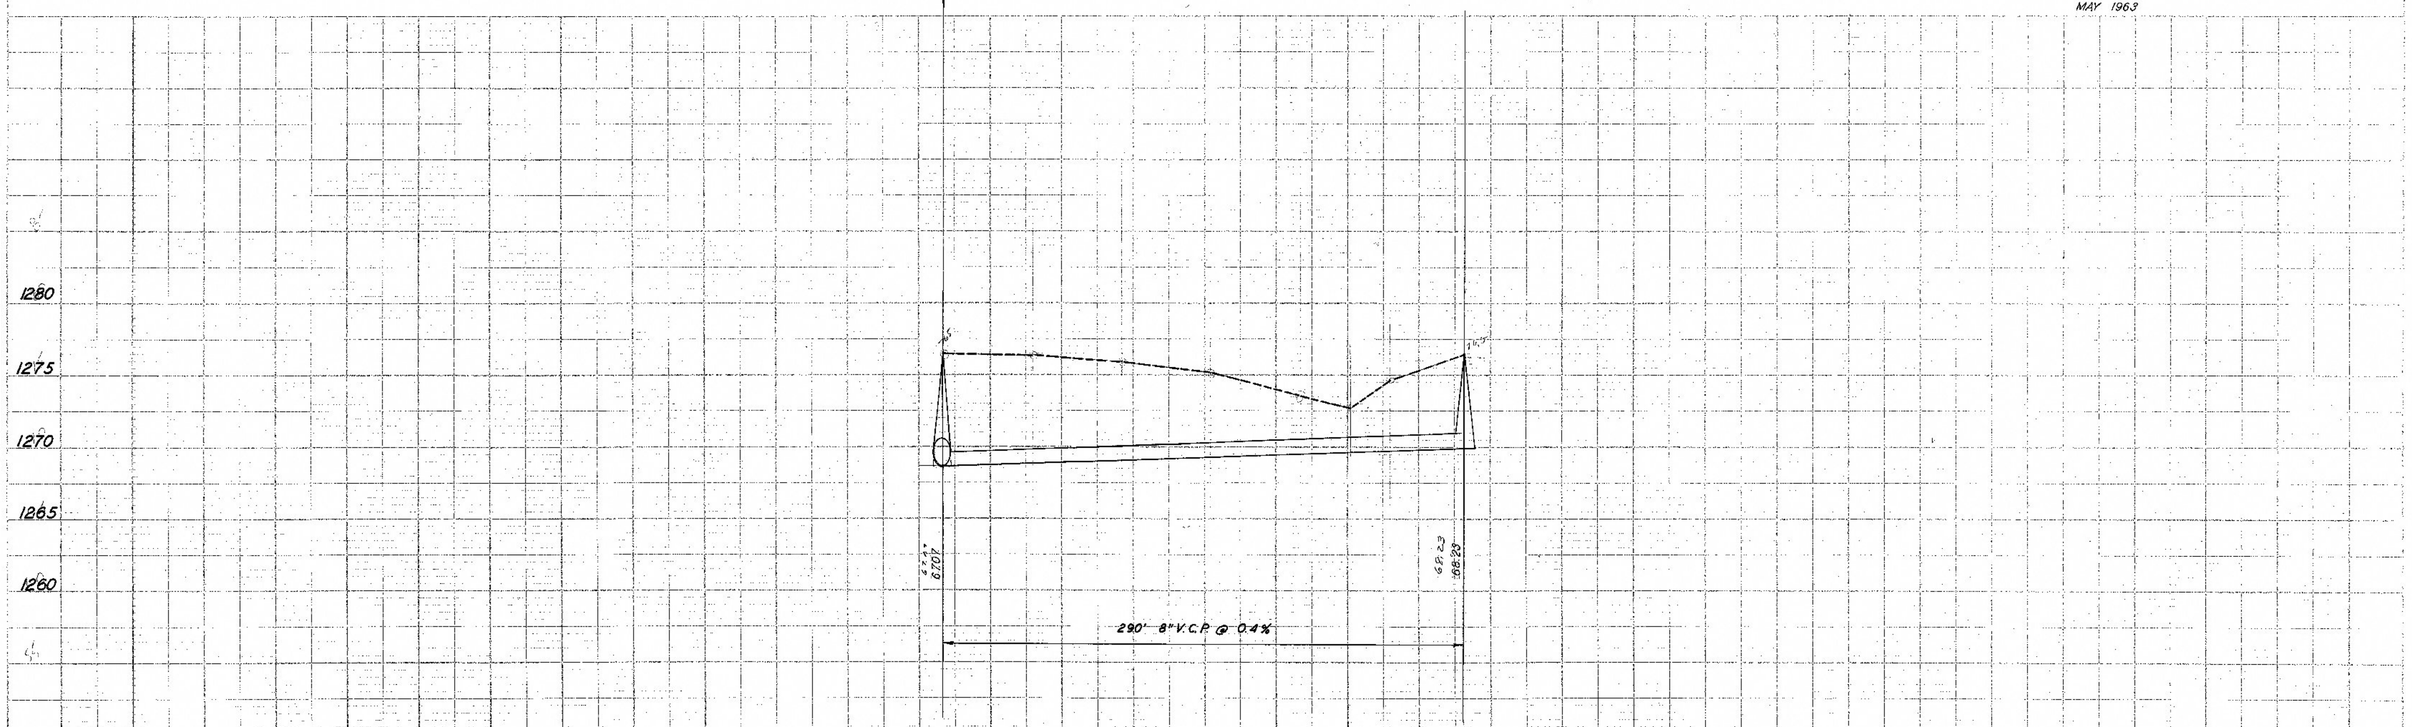

LATERAL 476

PLATE 1 - PLAN-PROFILE C.F.R.A.R.E. STANDARD