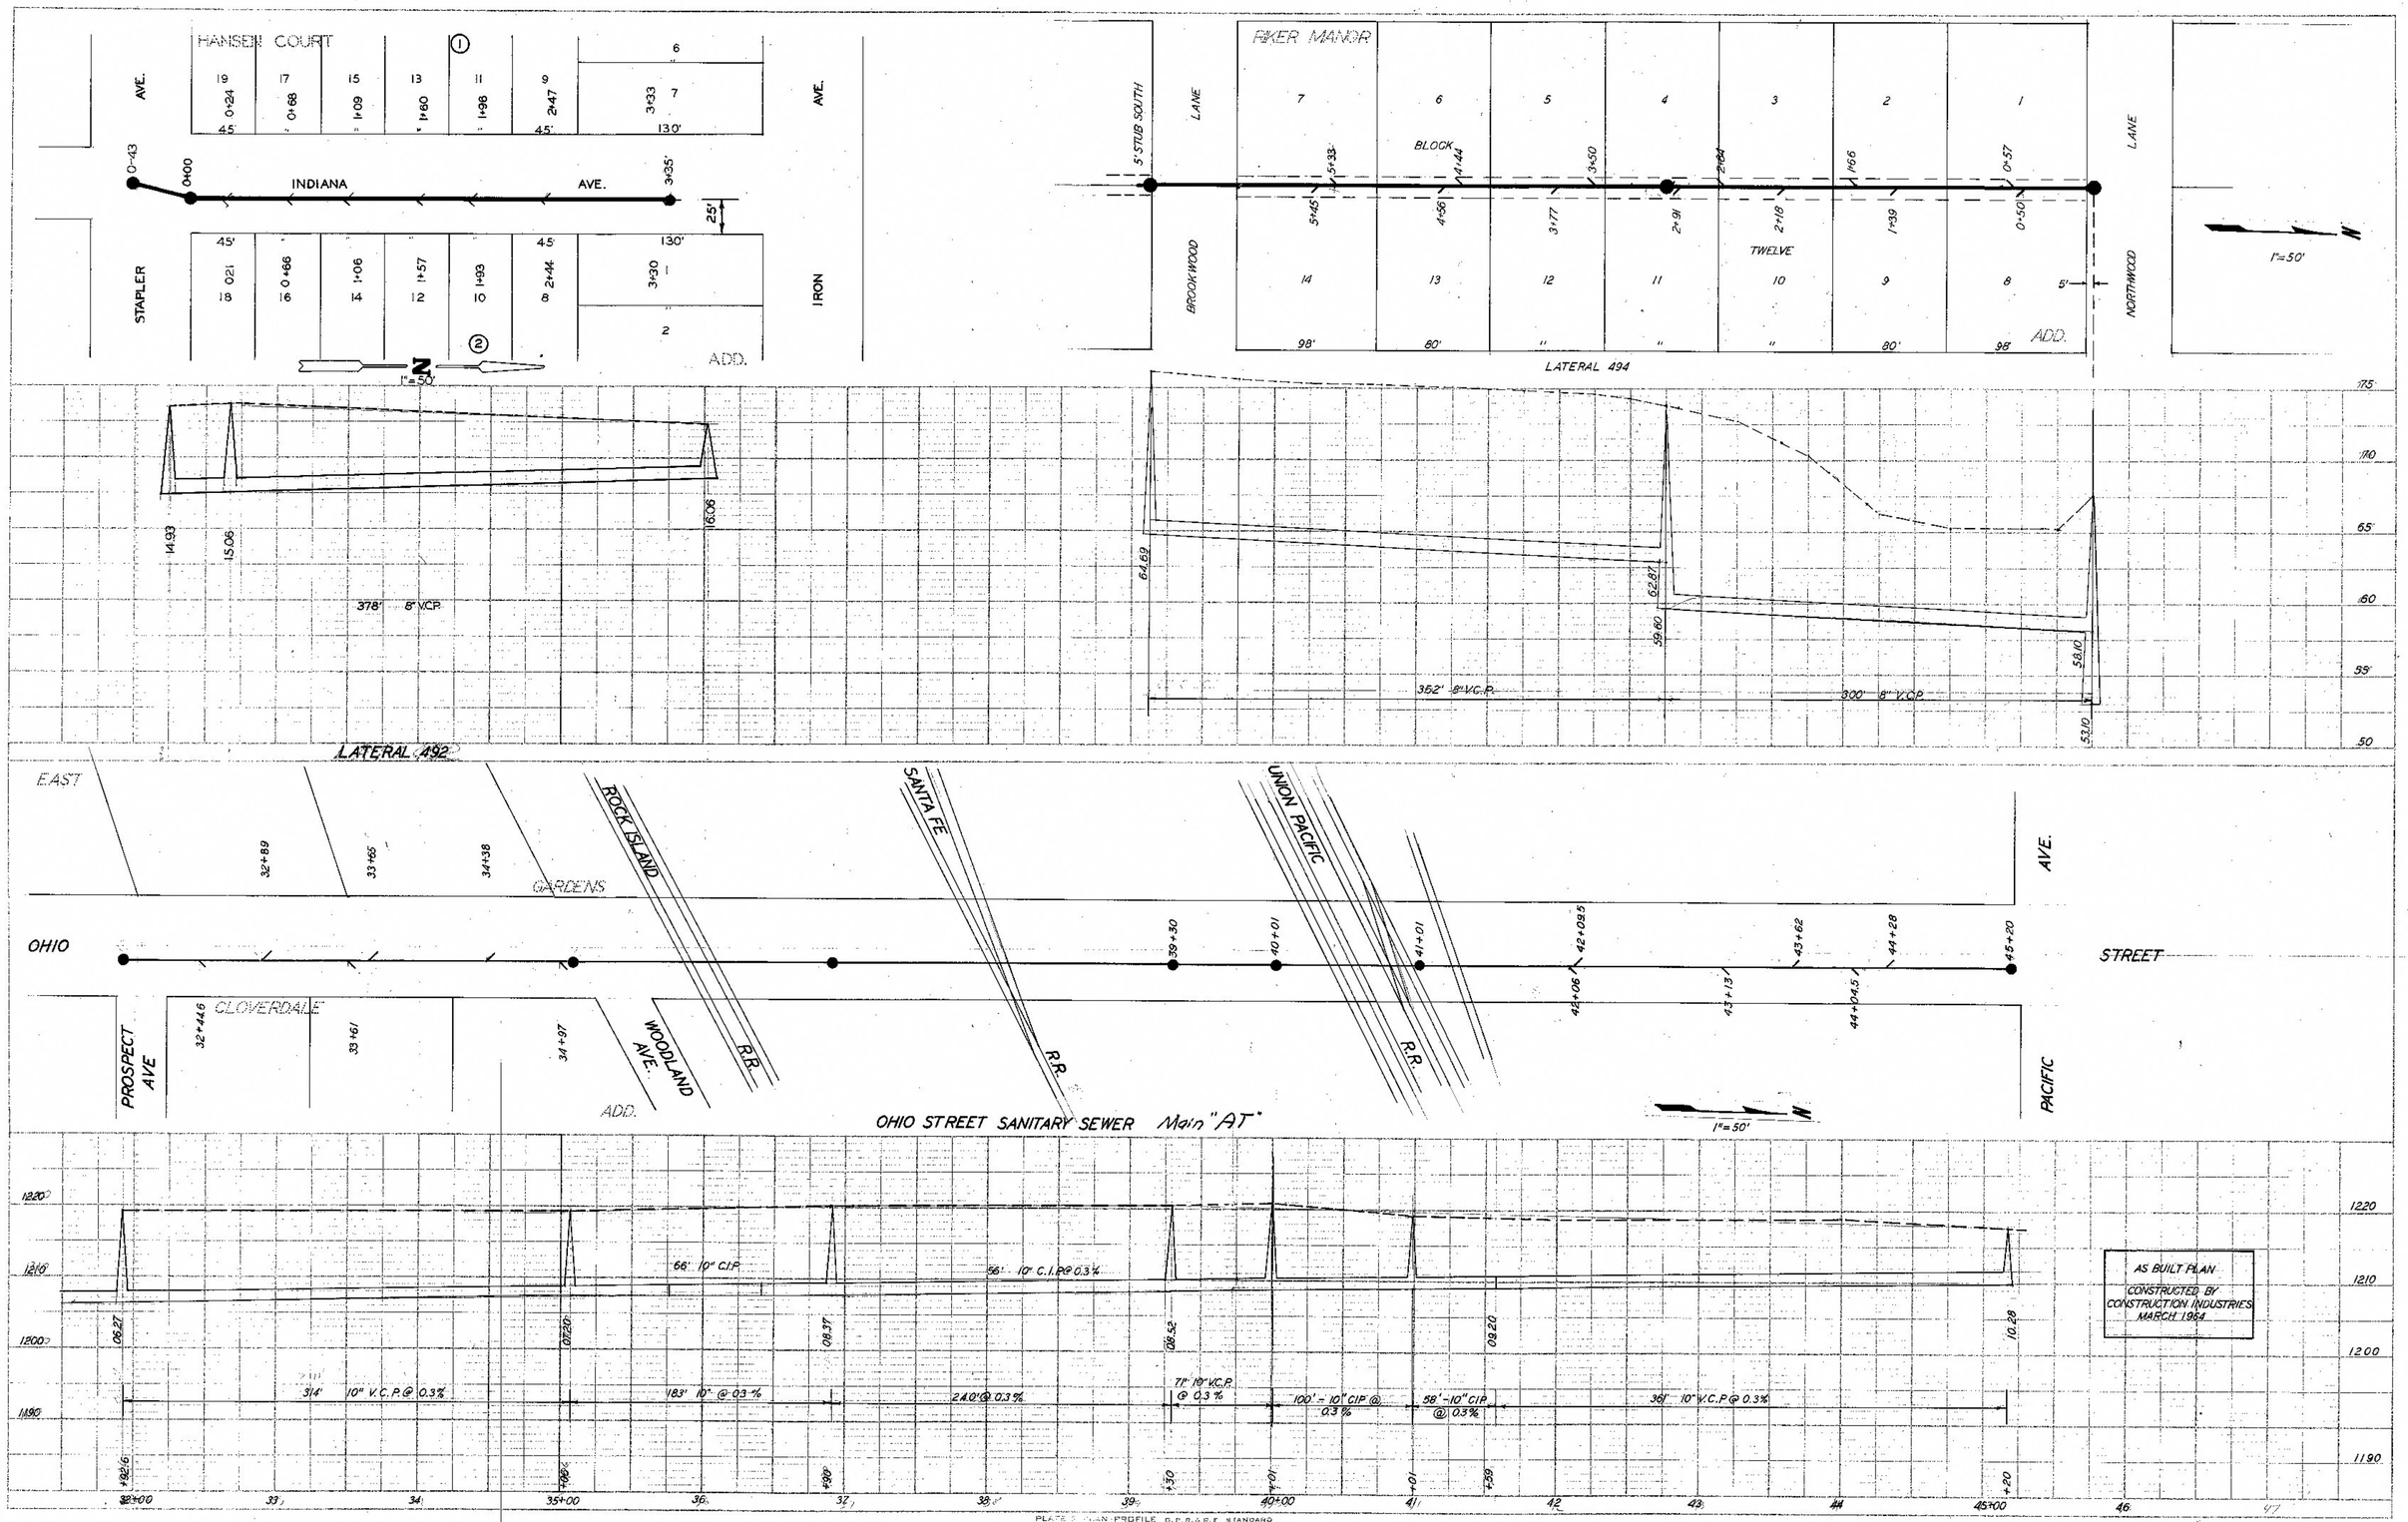
HANSEN COURT
AVE.
STAPLER
INDIANA
AVE.
IRON
AVE.
ADD.
1"=50'
5' STUB SOUTH
LANE
BROOKWOOD
RIKER MANOR
BLOCK
TWELVE
ADD.
NORTHWOOD
LANE
LATERAL 494
1"=50'
LATERAL 492
378' 8" V.C.P.
352' 8" V.C.P.
300' 8" V.C.P.
EAST
OHIO
STREET
GARDENS
ROCK ISLAND
SANTA FE
UNION PACIFIC
R.R.
R.R.
R.R.
PROSPECT AVE
CLOVERDALE
WOODLAND AVE.
ADD.
AVE.
PACIFIC
OHIO STREET SANITARY SEWER Main "AT"
1"=50'
66' 10" C.I.P.
56' 10" C.I.P. @ 0.3%
314' 10" V.C.P. @ 0.3%
183' 10" @ 0.3%
240' @ 0.3%
71' 10" V.C.P. @ 0.3%
100' - 10" CIP @ 0.3%
58' - 10" CIP @ 0.3%
36' 10" V.C.P. @ 0.3%
AS BUILT PLAN
CONSTRUCTED BY
CONSTRUCTION INDUSTRIES
MARCH 1964
PLAN
PROFILE