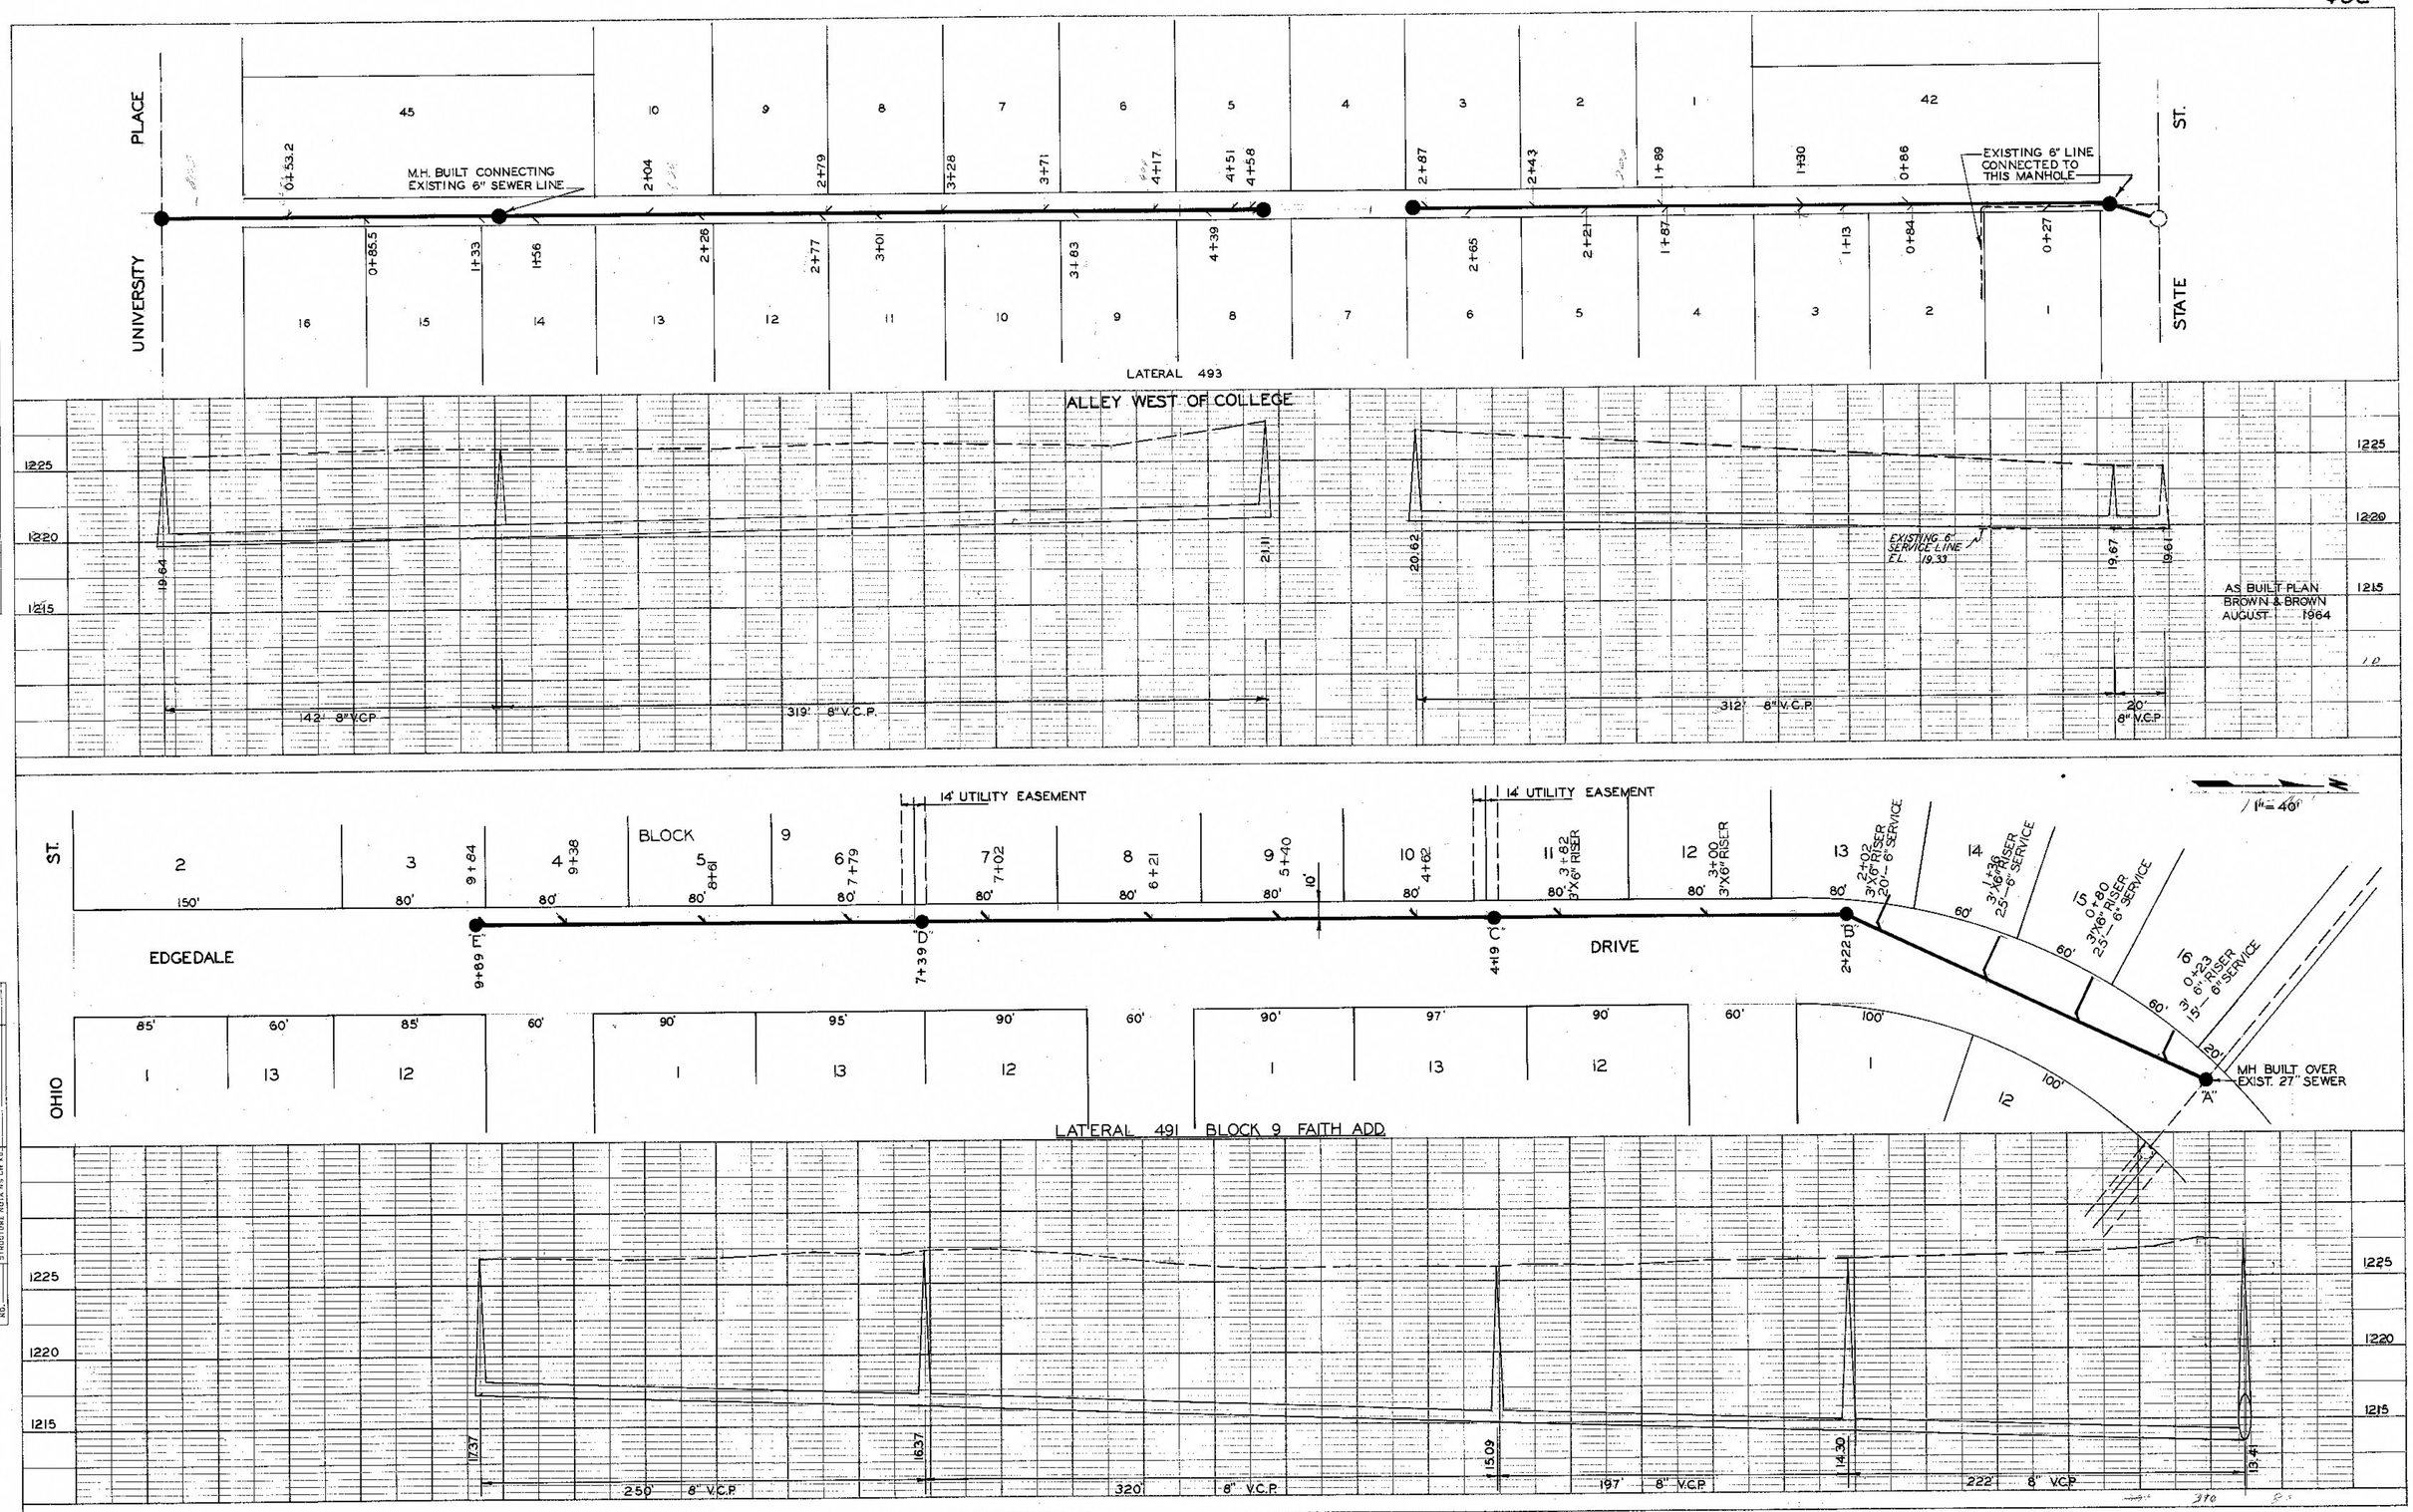

PLAN
NOTE BOOK
NO.
SURVEYED
PLOTTED
ALIGNMENT CHECKED
PT. BY PAY CHANGE
BY
DATE

PROFILE
NOTE BOOK
NO.
SURVEYED
PLOTTED
GRADES CHECKED
B.M. NOTED
STRUCTURE NOTATIONS CHKD.
BY
DATE

PLATE 2-PLAN-PROFILE D.P.R. & R.E. STANDARD
100% ASCOPROOF VELLUM-MADE AND PRINTED IN U.S.A.
EUGENE DIETZGEN CO.