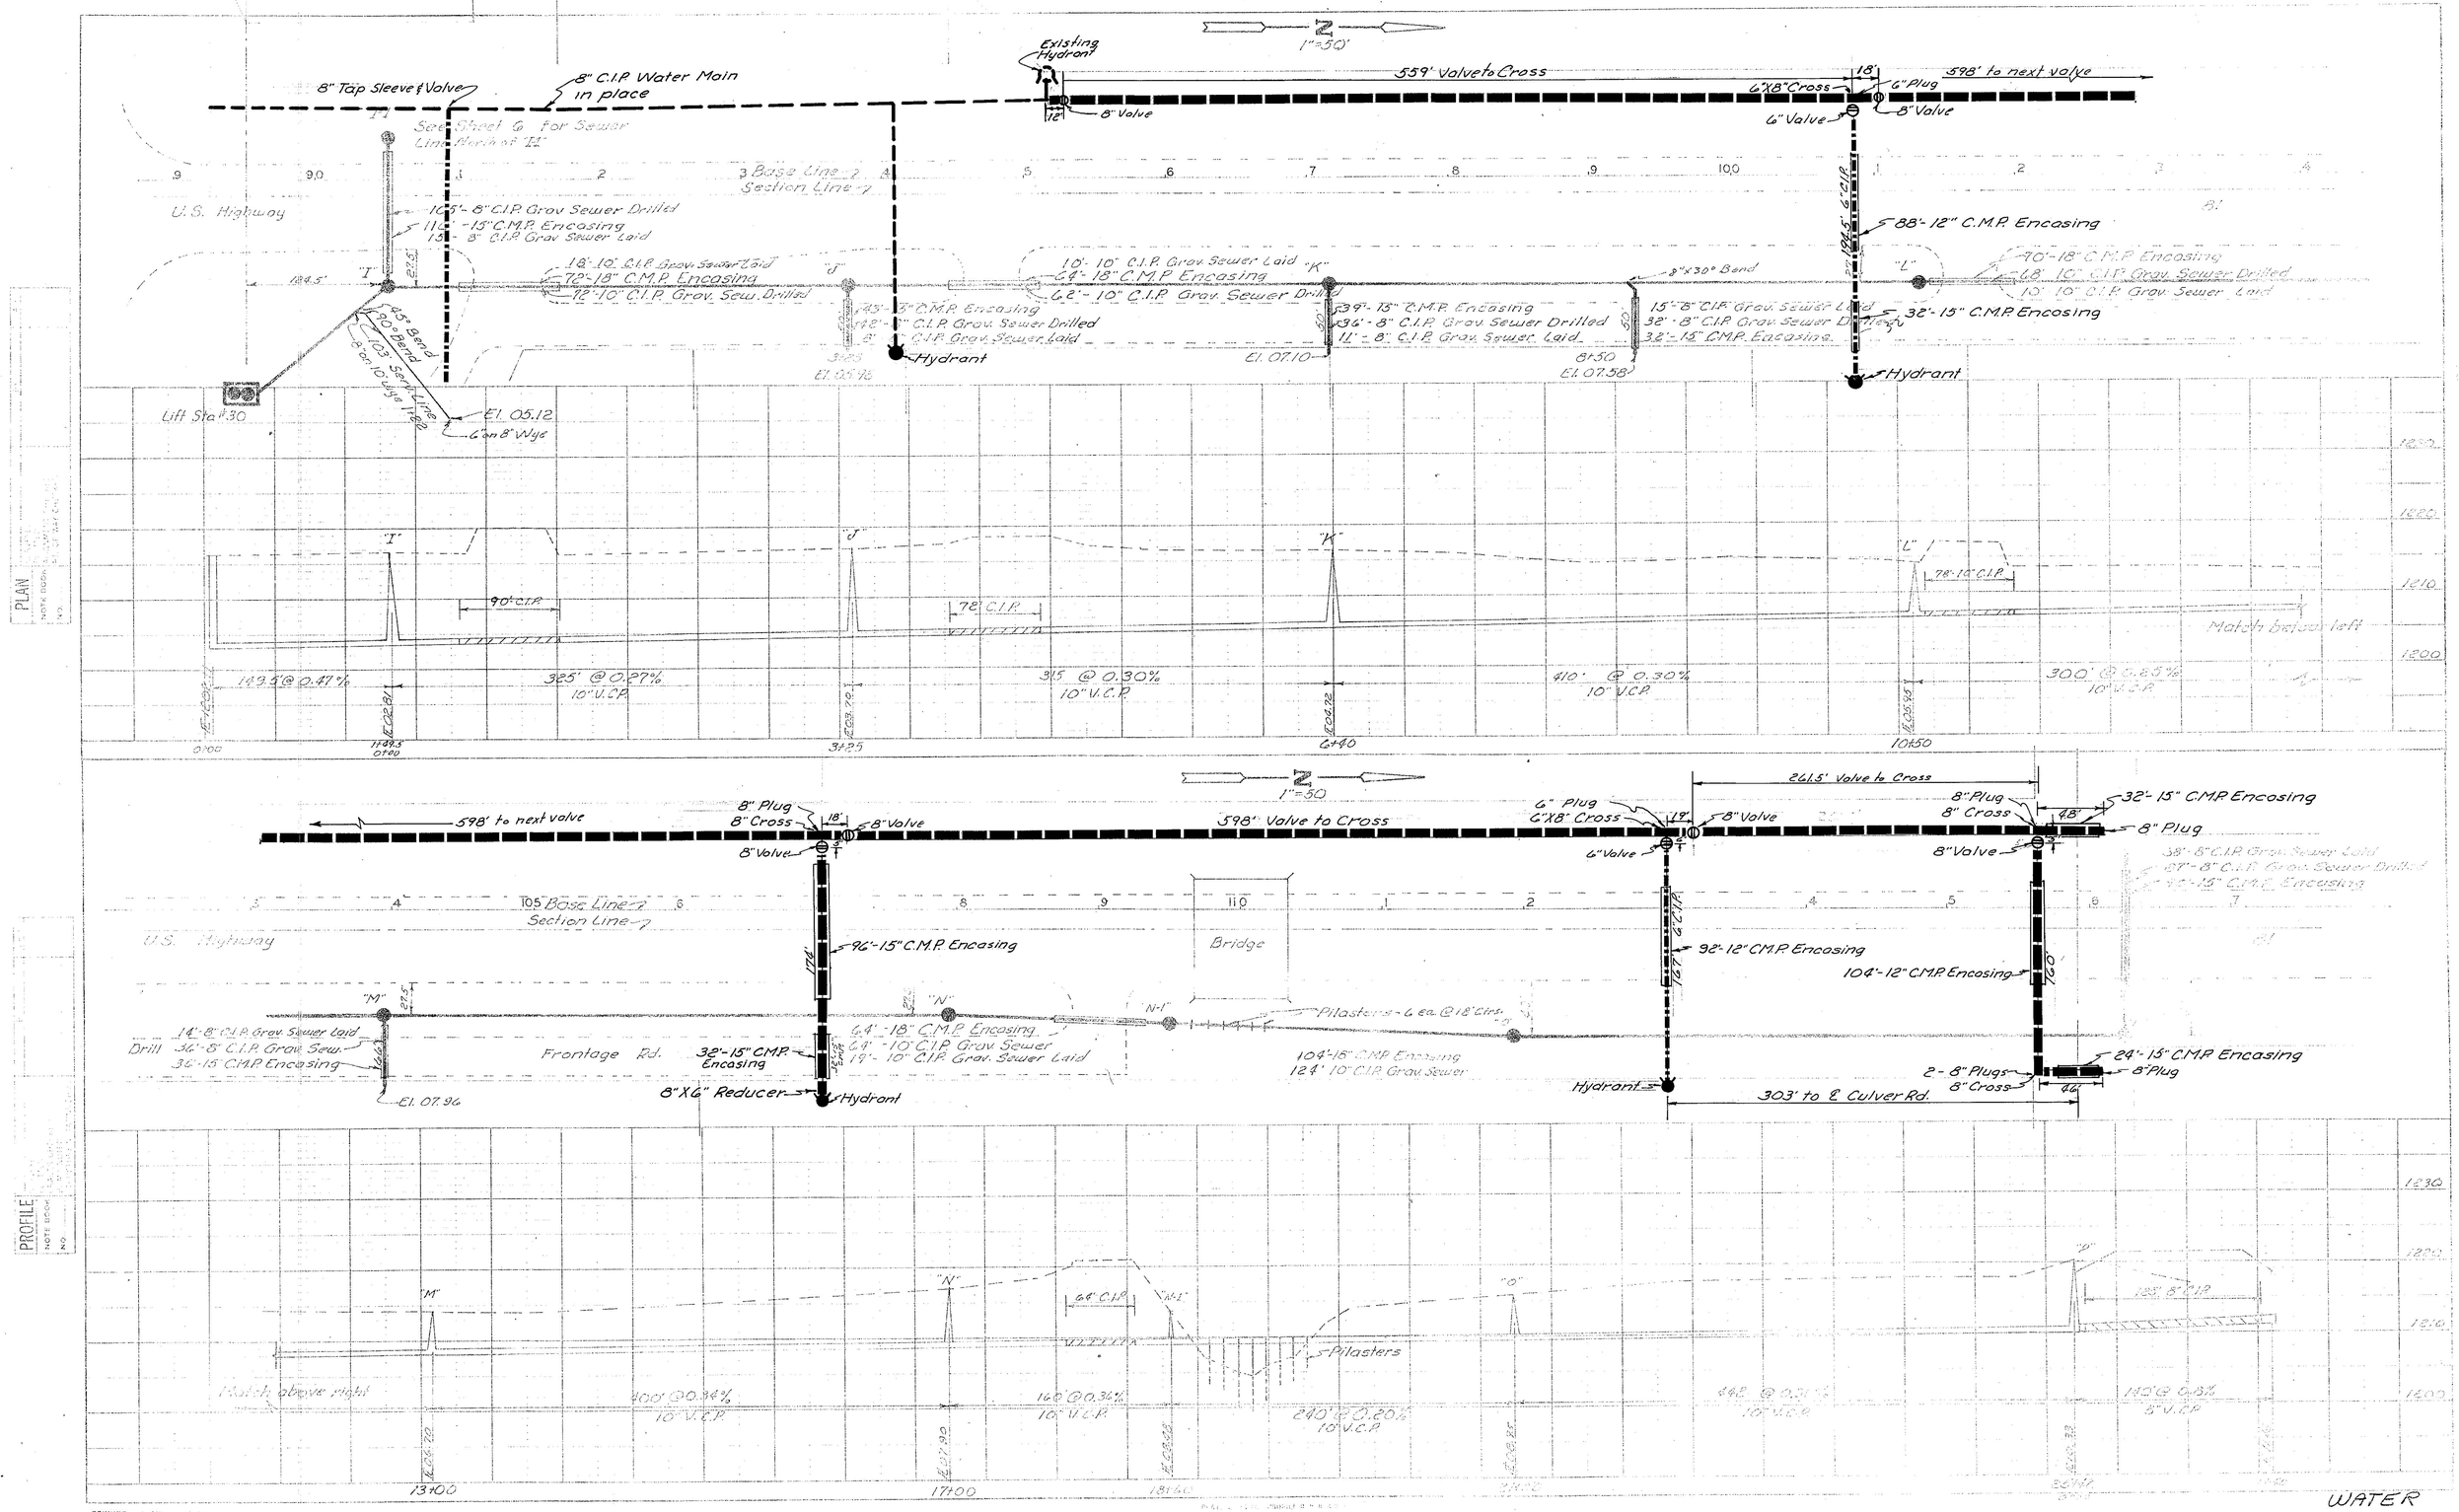

WATER
Sheet 4A