412
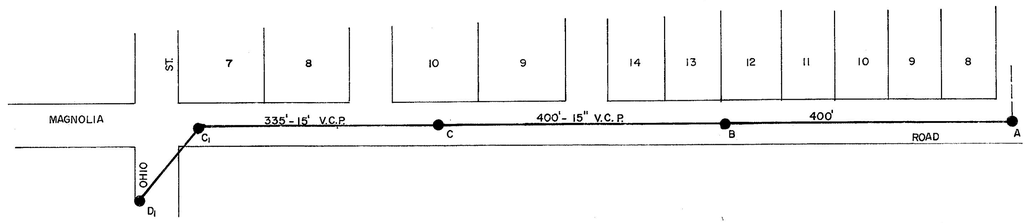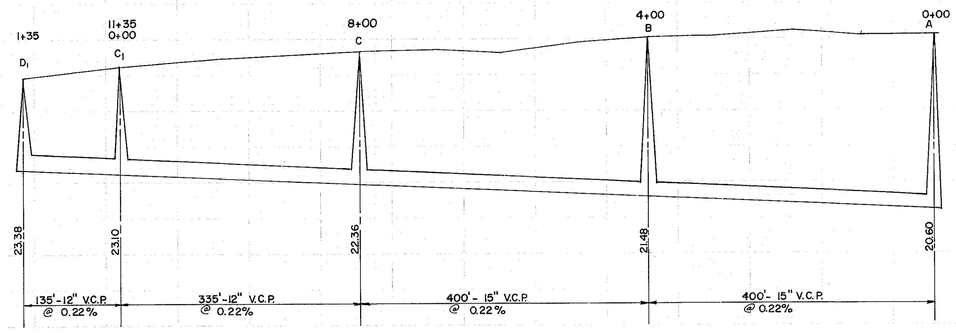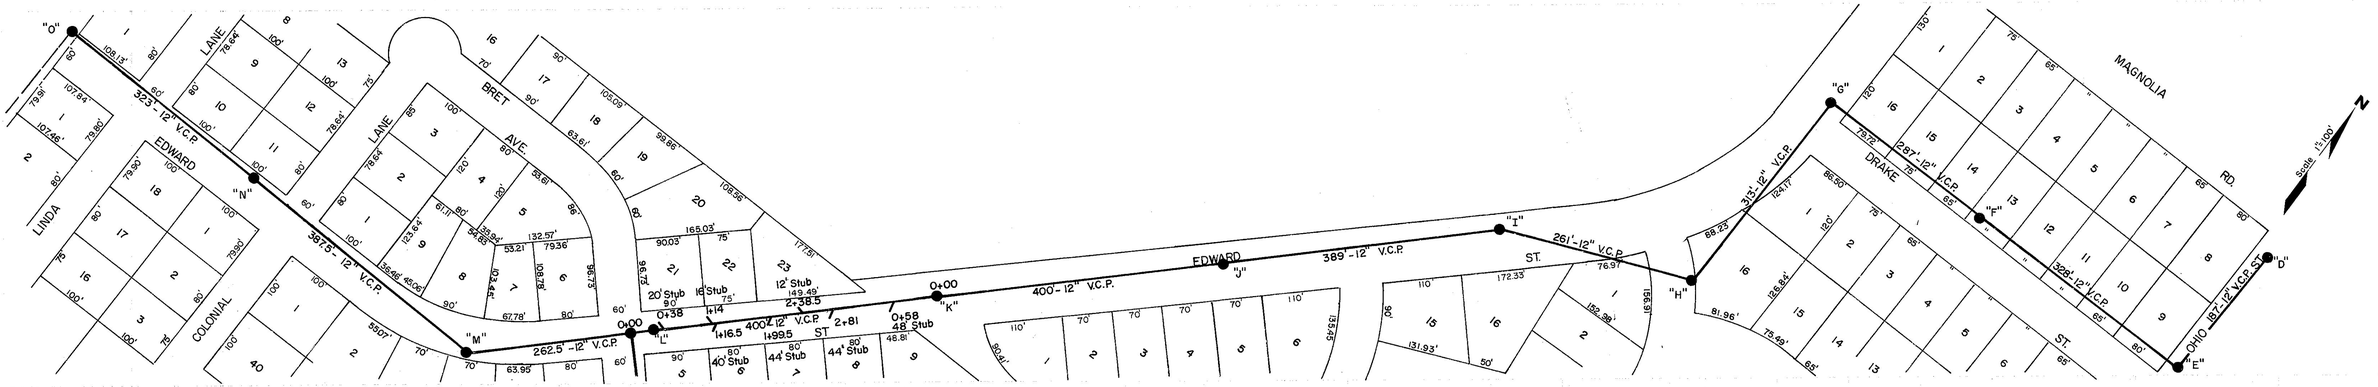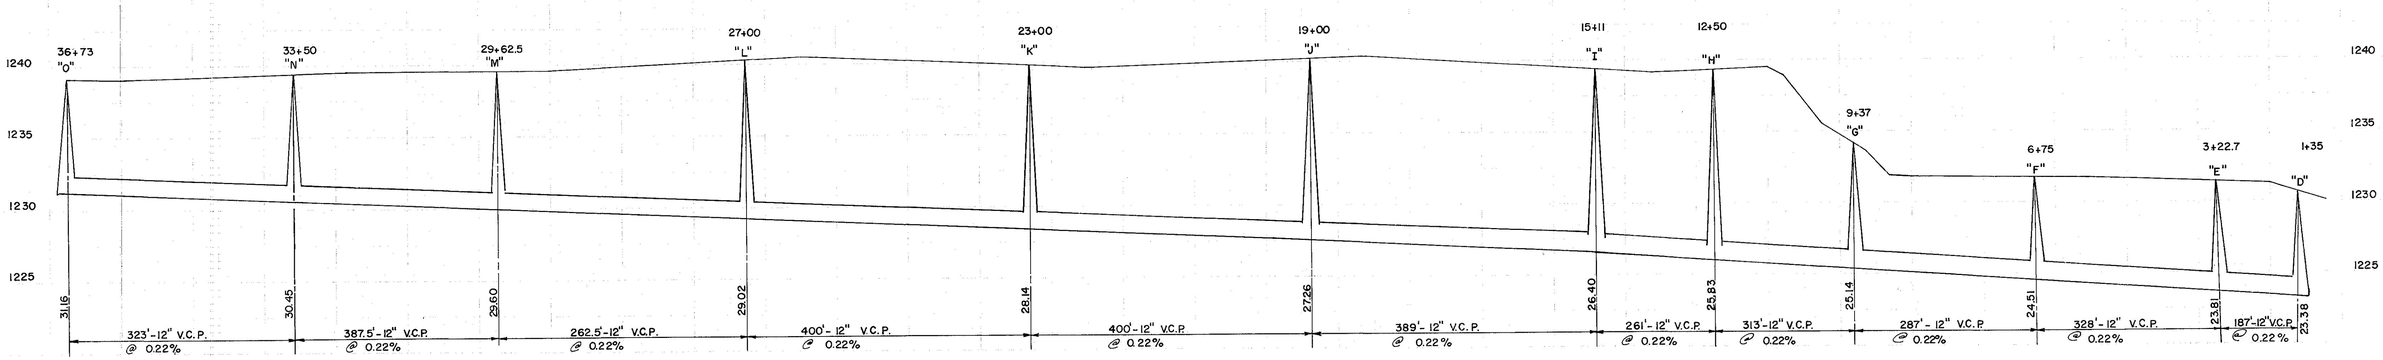
AS BUILT PLANS
JOB 458
WILMOTH CONST.
COMPLETION DATE
MAY 1966