
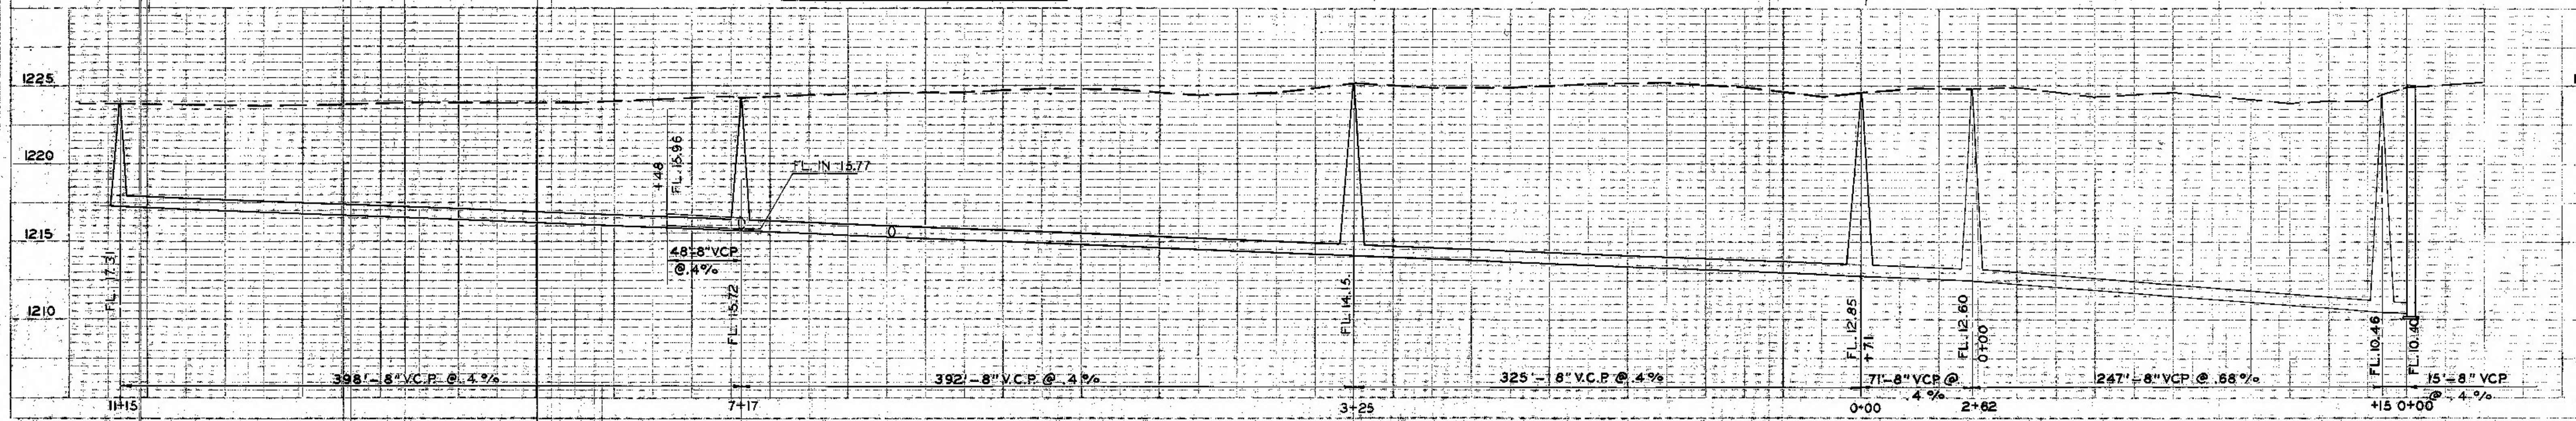
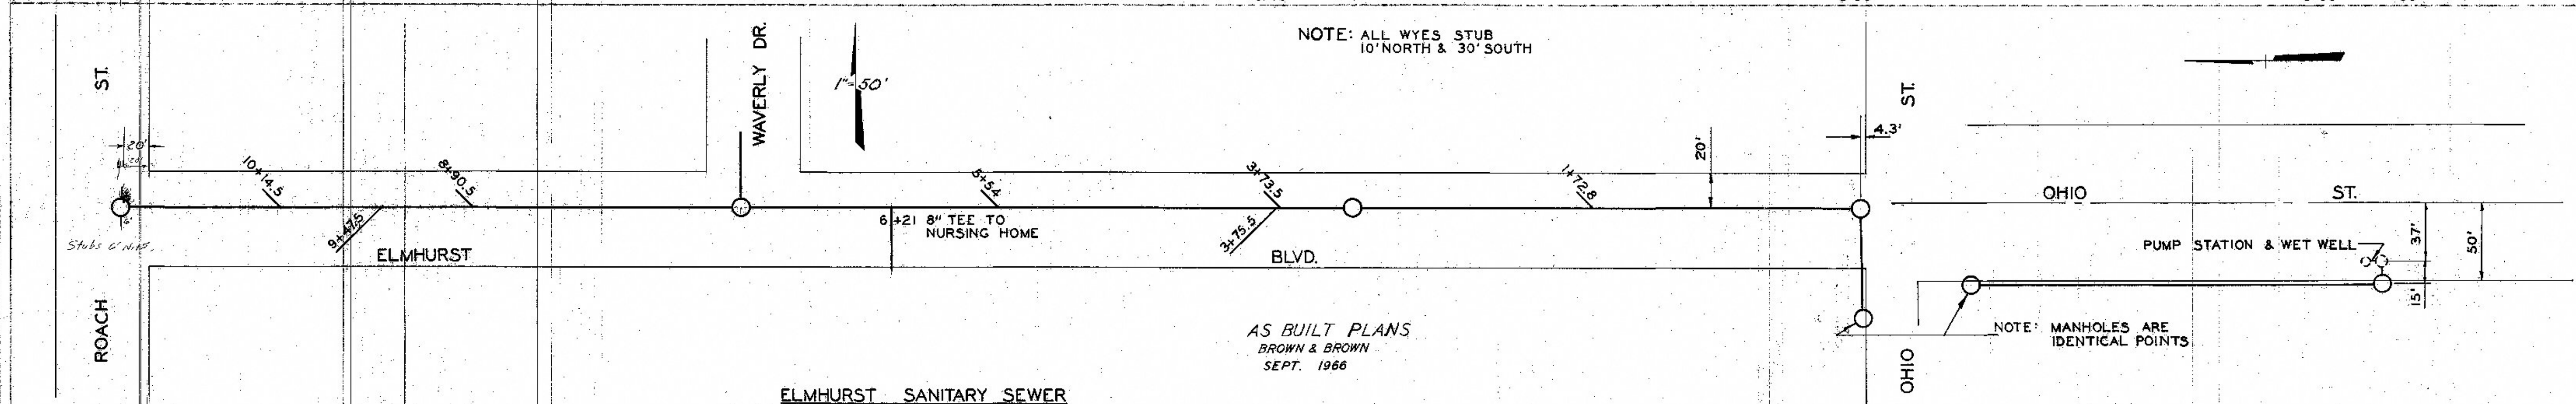


AS BUILTS O. D. WILMOTH CONTINUATION JOB 458 oct. 1966

SCALE 1"=50'

415

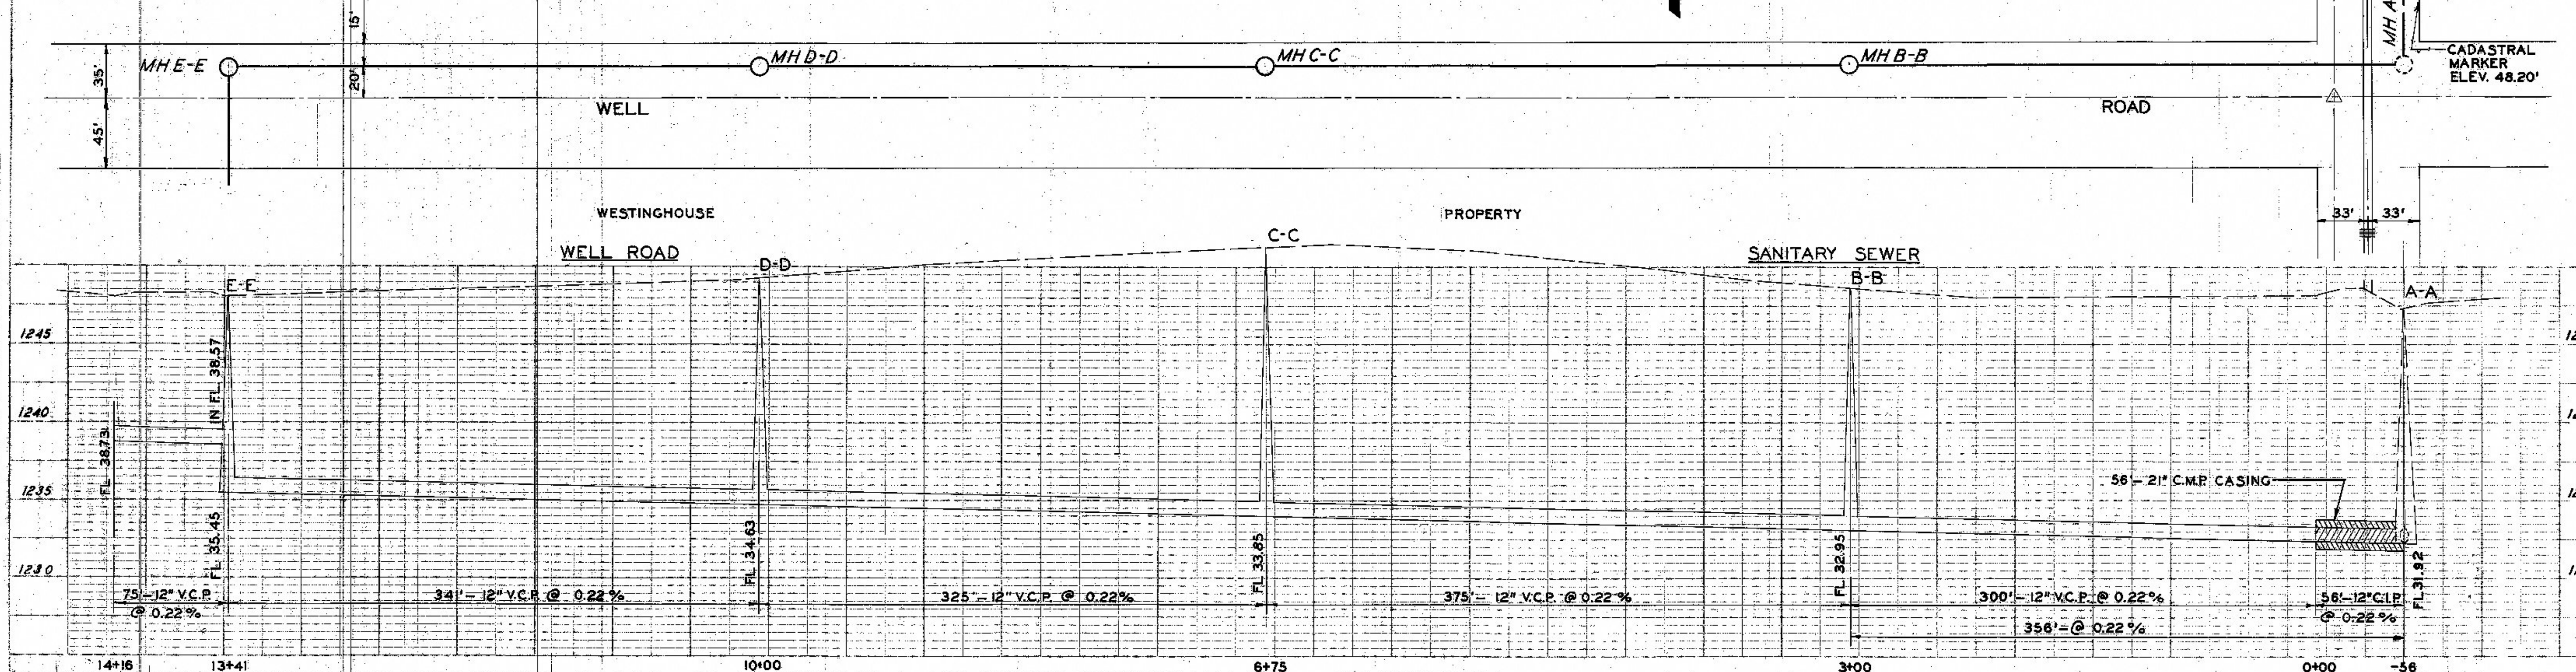

PLAN
SUPPORTED
NOTE BOOK
BY THE WAY CHECKED

PROJECT
SUPPORTED
NOTE BOOK
BY THE WAY CHECKED

AS BUILT PLANS
BROWN & BROWN
SEPT. 1966