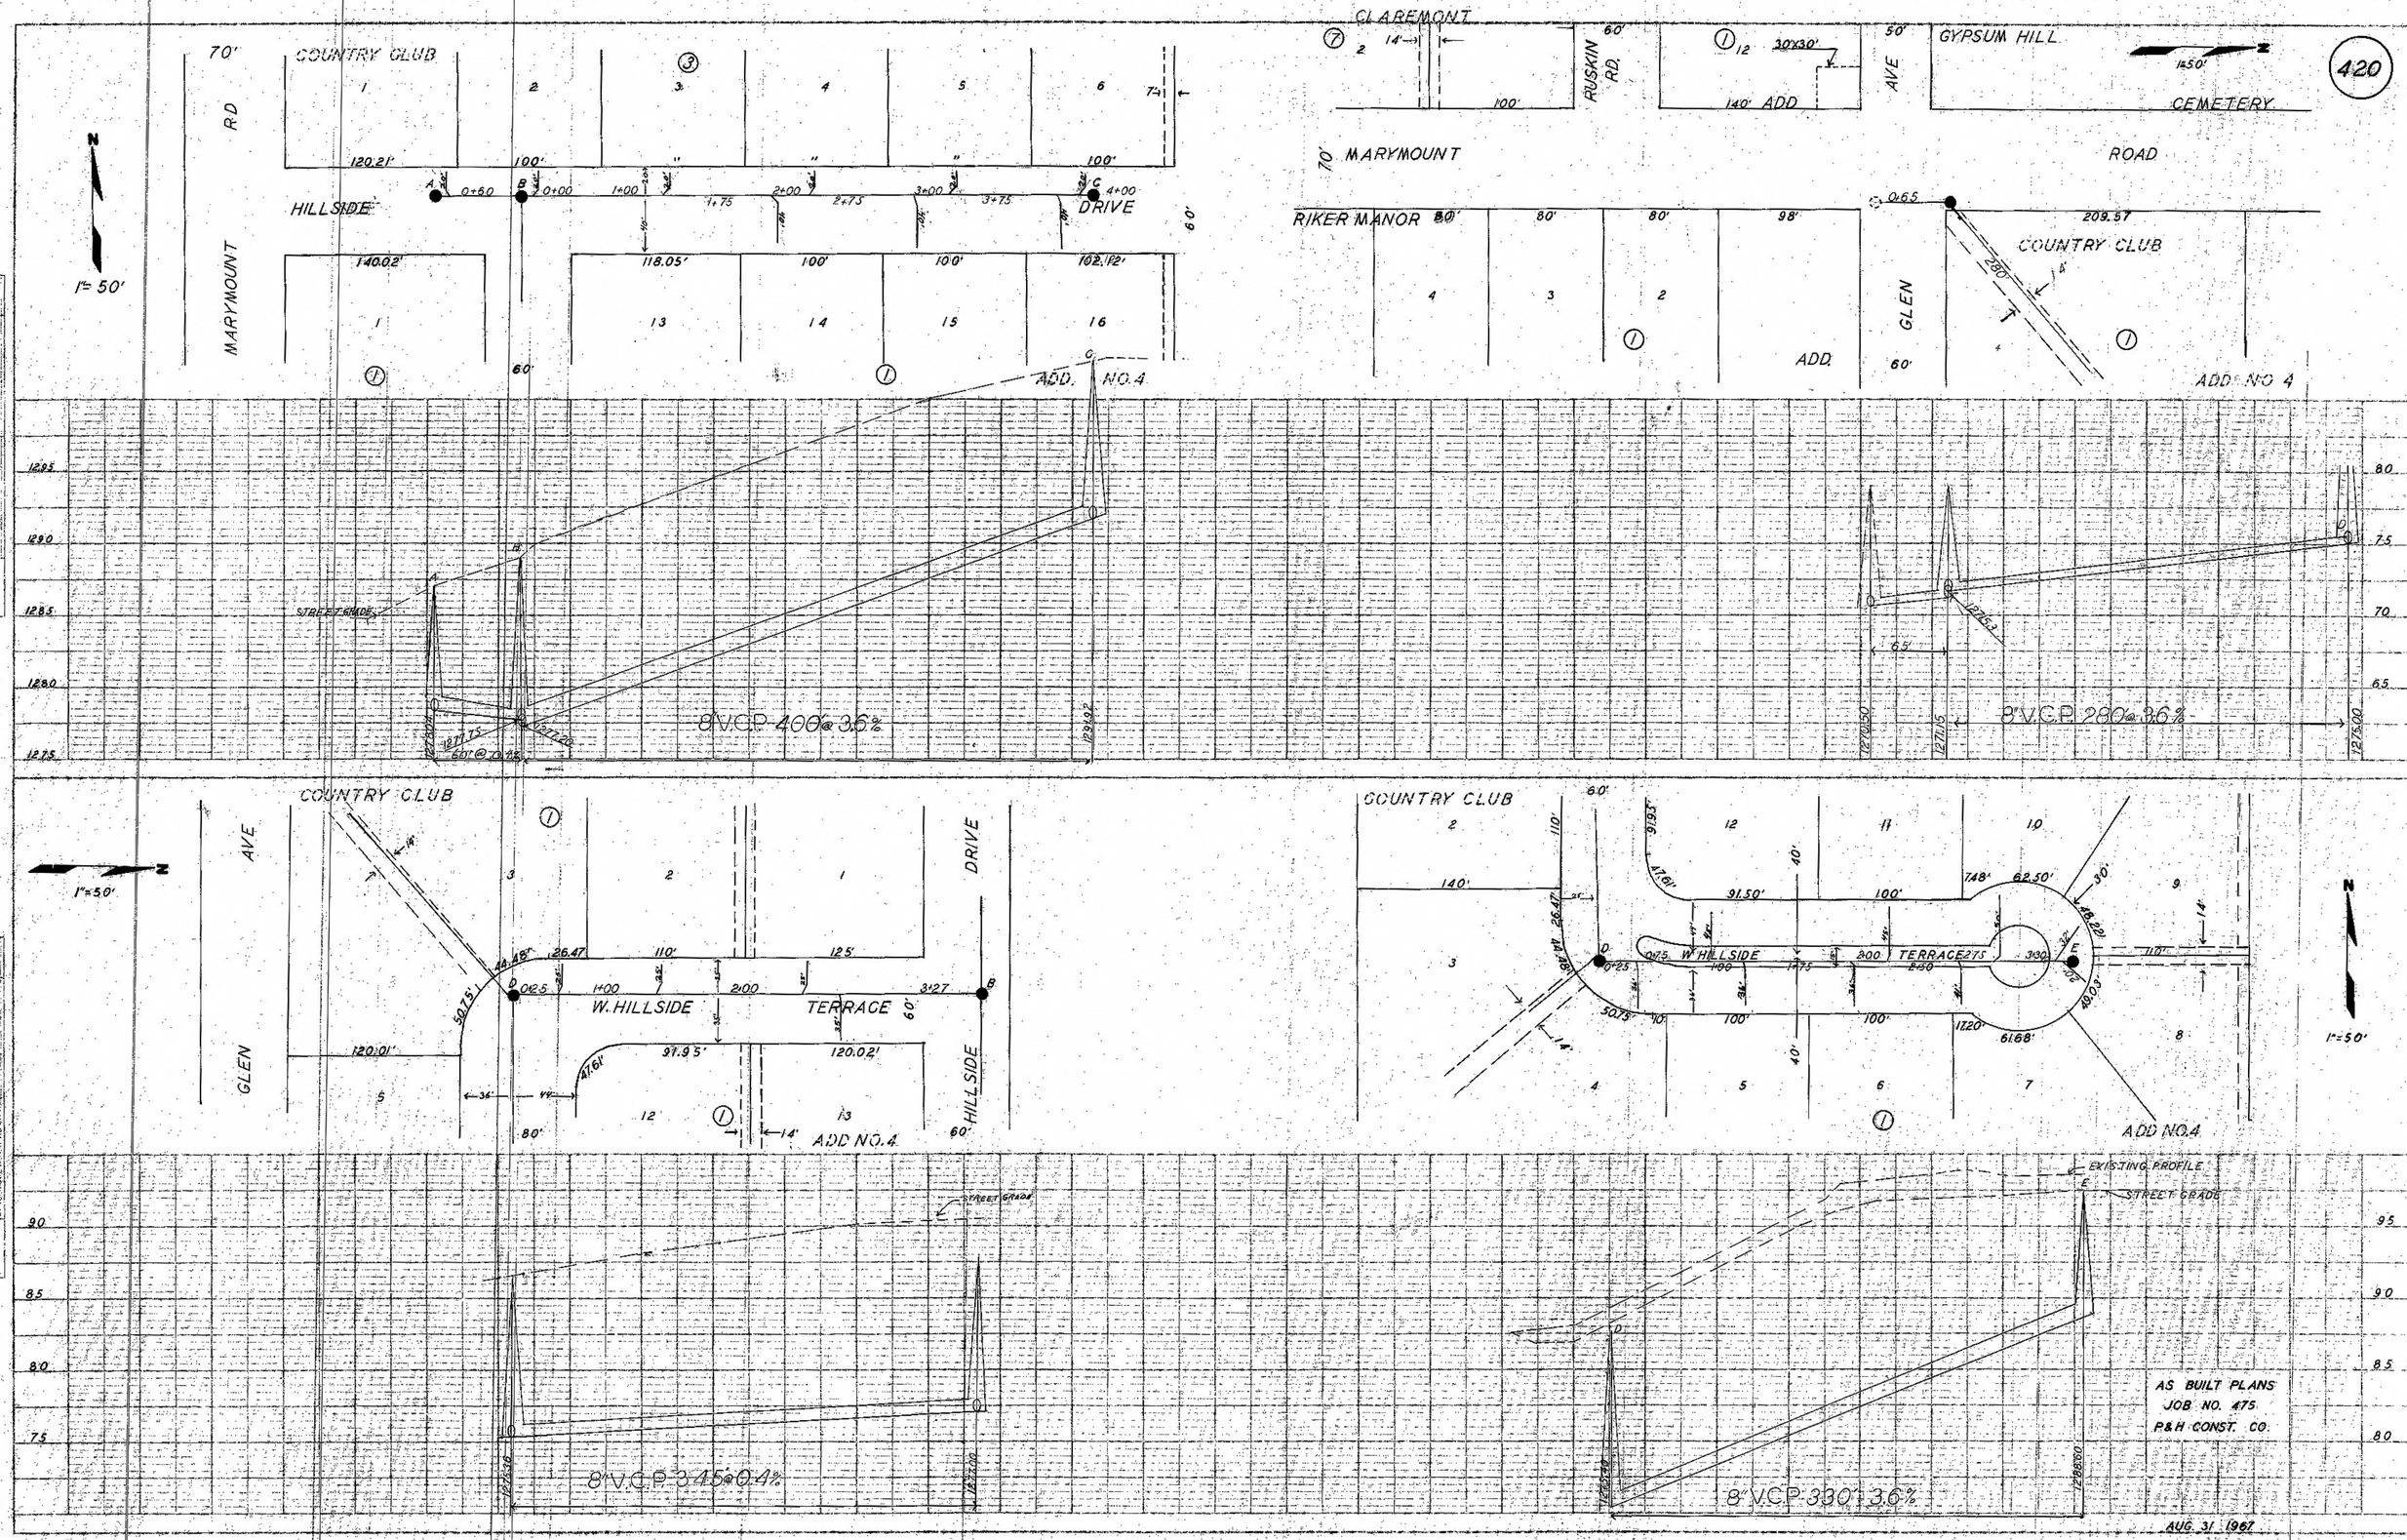
420
COUNTRY CLUB
MARYMOUNT RD
HILLSIDE DRIVE
1" = 50'
ADD. NO. 4
CLAREMONT
RUSKIN RD.
GYPSUM HILL
CEMETERY
ROAD
70' MARYMOUNT
RIKER MANOR
GLEN AVE
8" V.C.P. 400' @ 3.6%
8" V.C.P. 280' @ 3.6%
STREET GRADE
W. HILLSIDE TERRACE
HILLSIDE DRIVE
1" = 50'
8" V.C.P. 345' @ 0.4%
8" V.C.P. 330' @ 3.6%
EXISTING PROFILE
AS BUILT PLANS
JOB NO. 475
P&H CONST. CO.
AUG. 31 1967
PLAN
PROFILE