422

1" = 50'

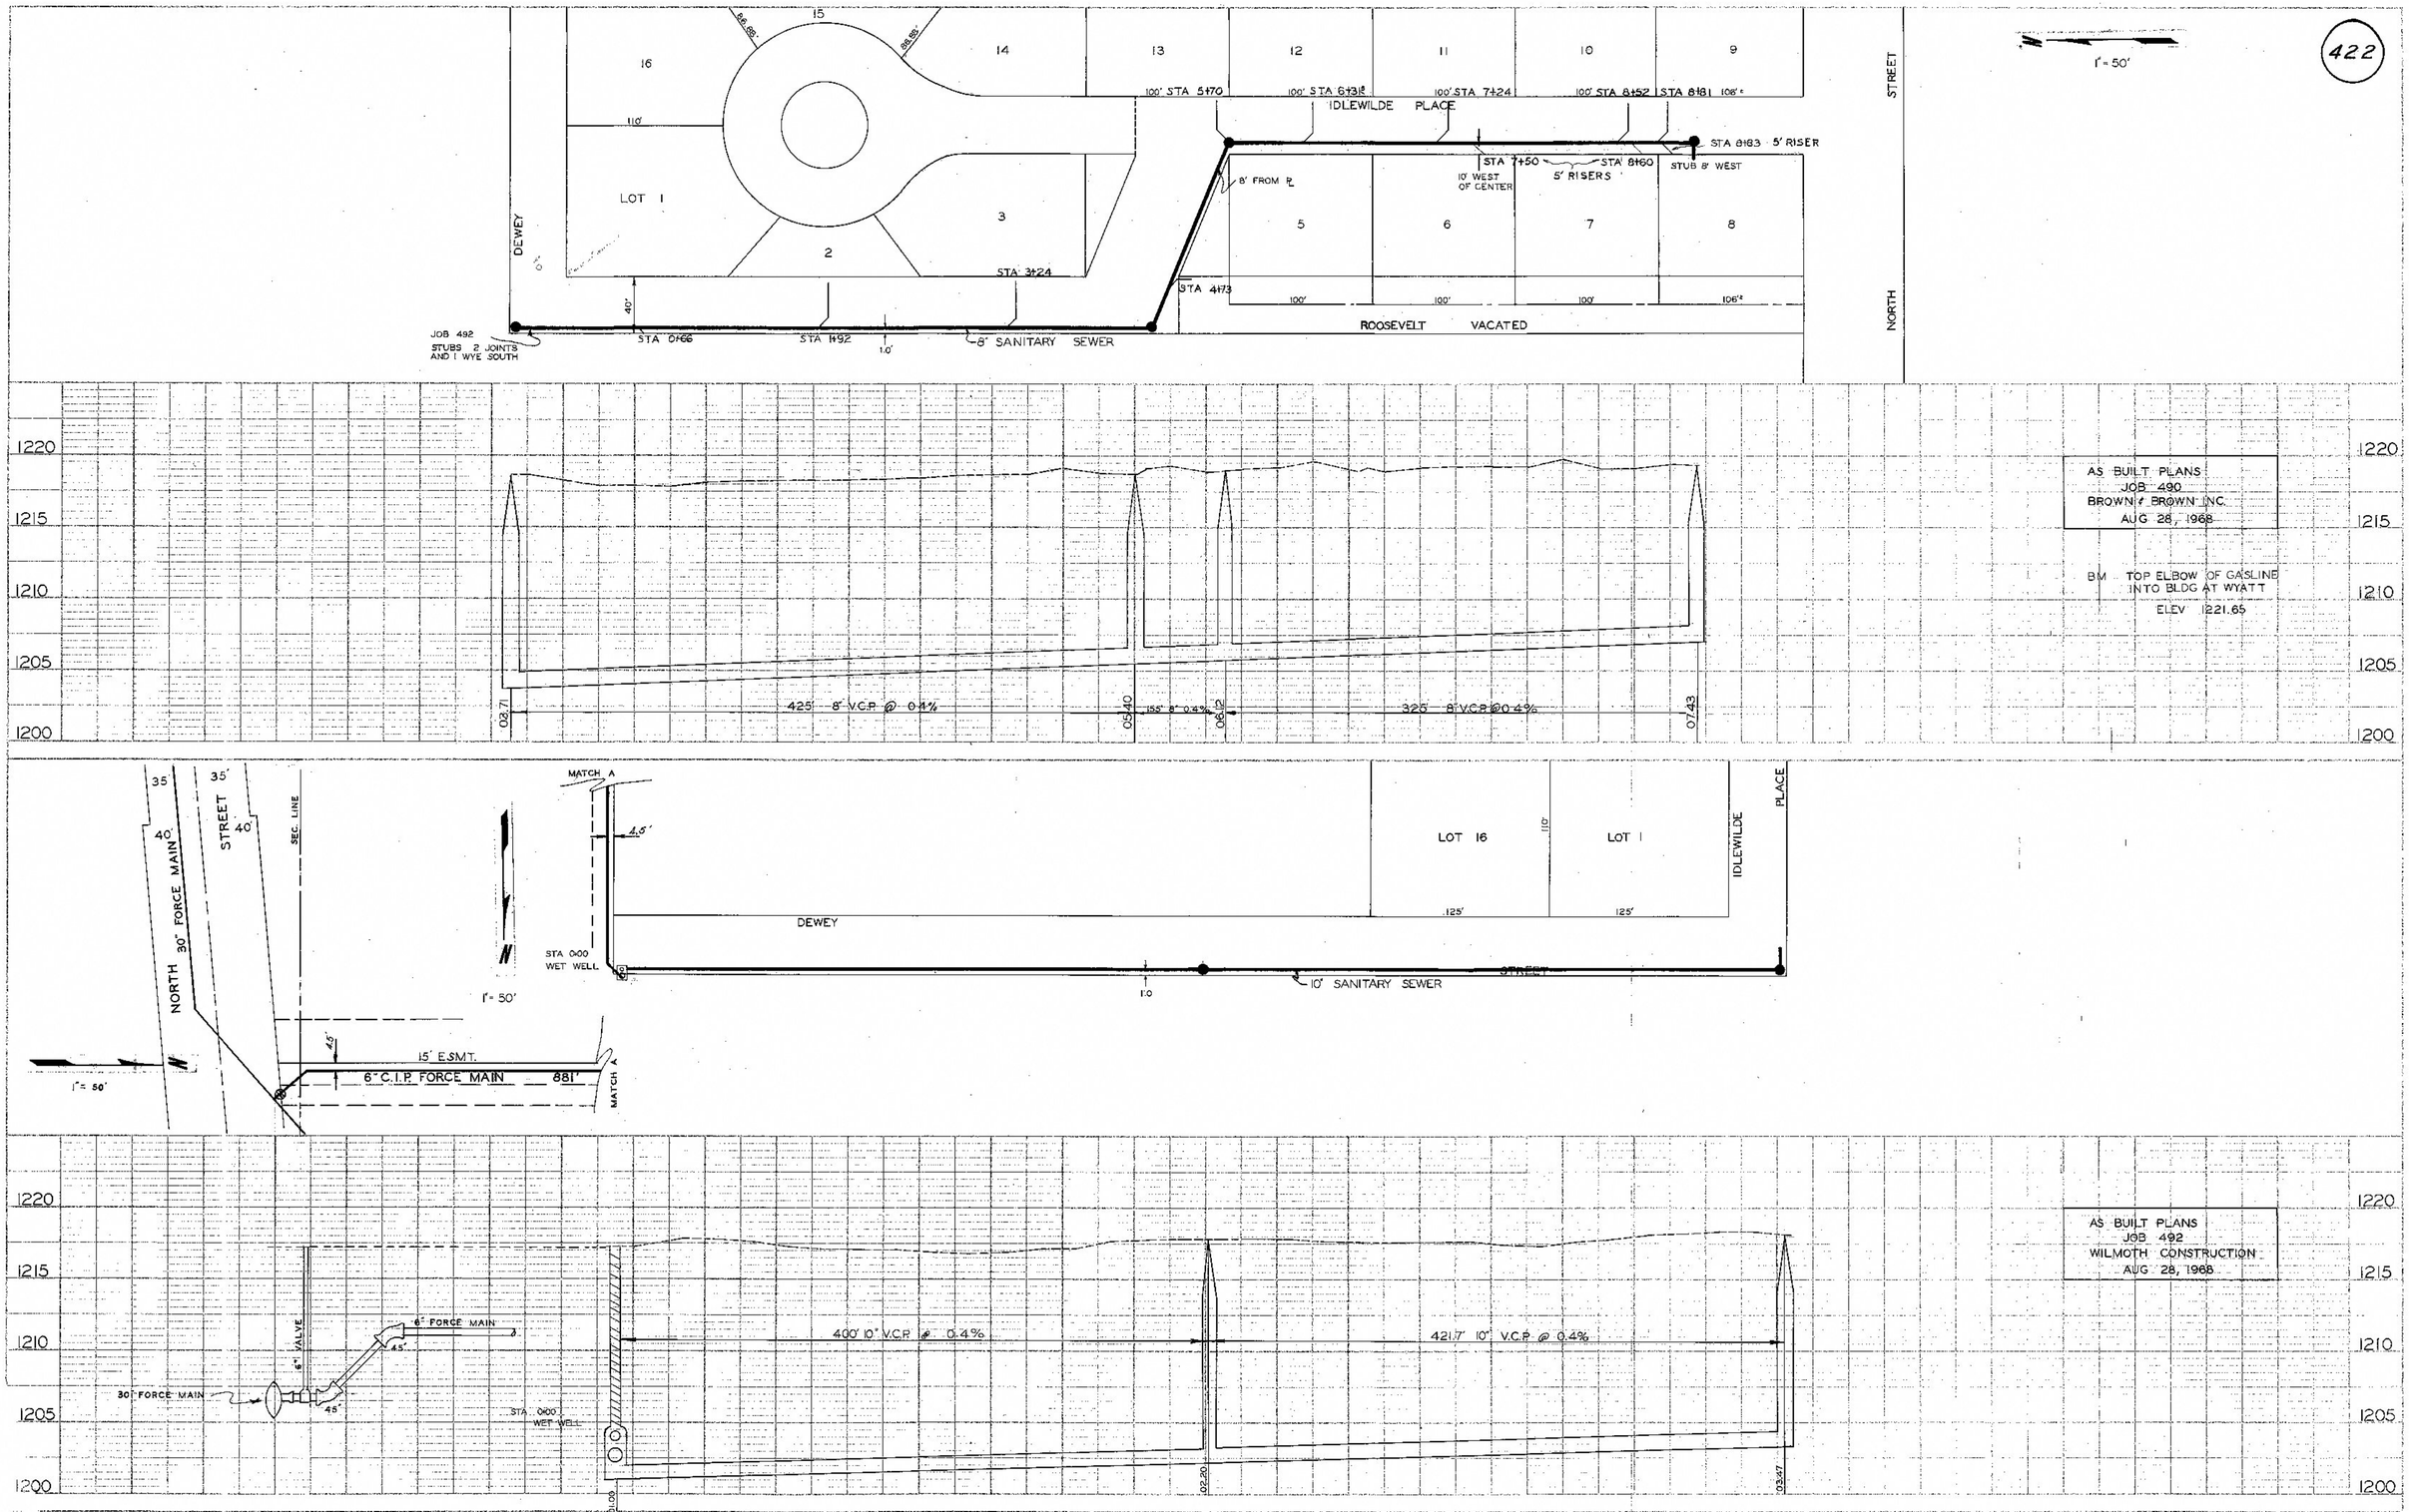

