
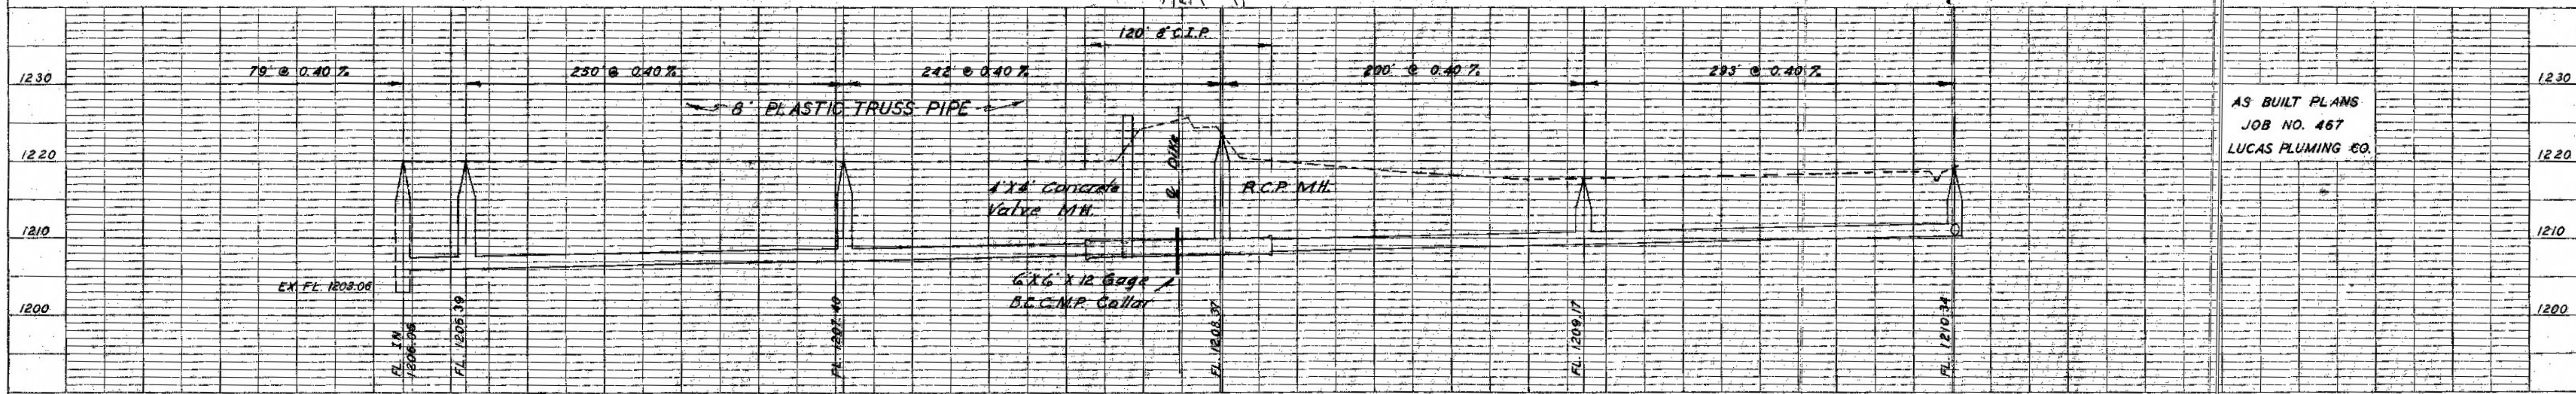
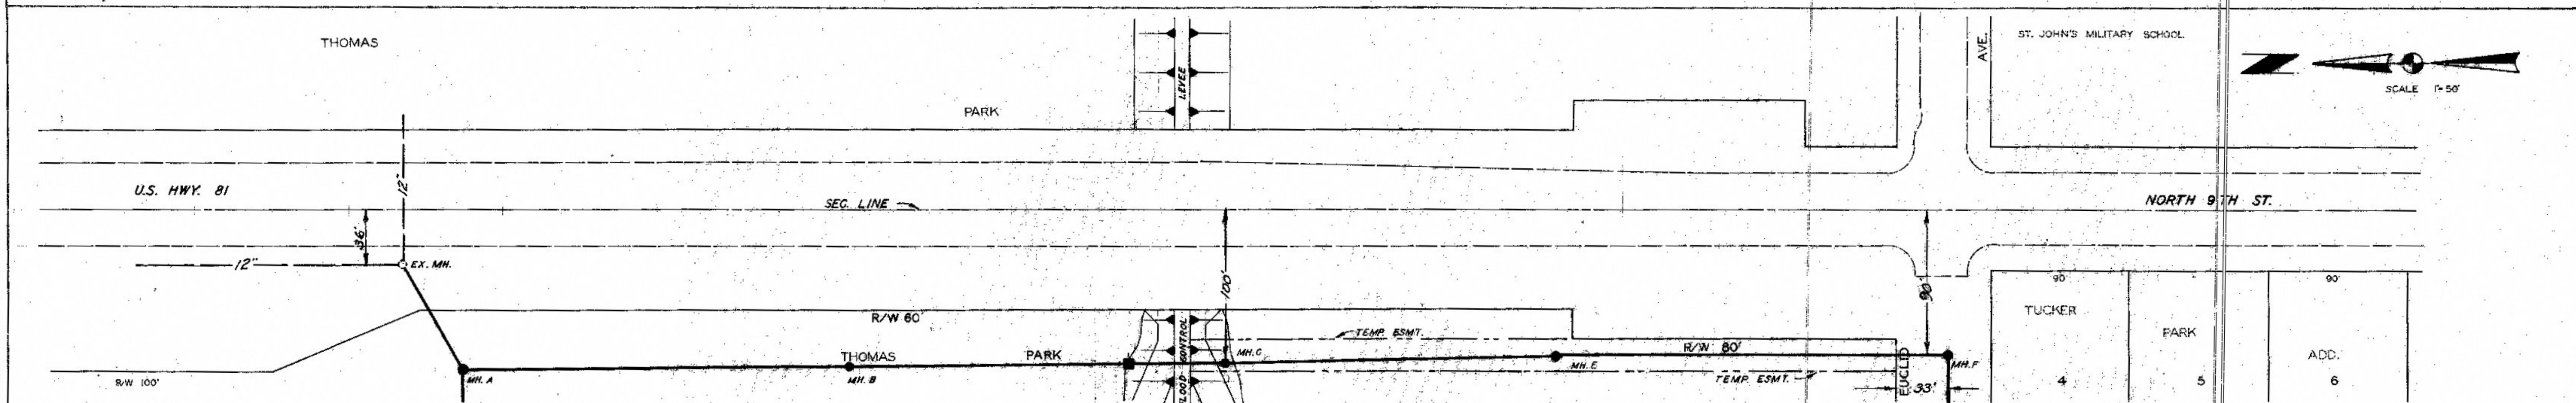


PLAN
 SURVEYED BY
 PLOTTED BY
 NOTE BOOK ALIGNMENT CHECKED
 RT. OF WAY CHECKED
 NO. DATE

PROFILE
 SURVEYED BY
 GRADES CHECKED
 R. M. S. NOTED
 STRUCTURE NOTATIONS CH'D
 NO. DATE

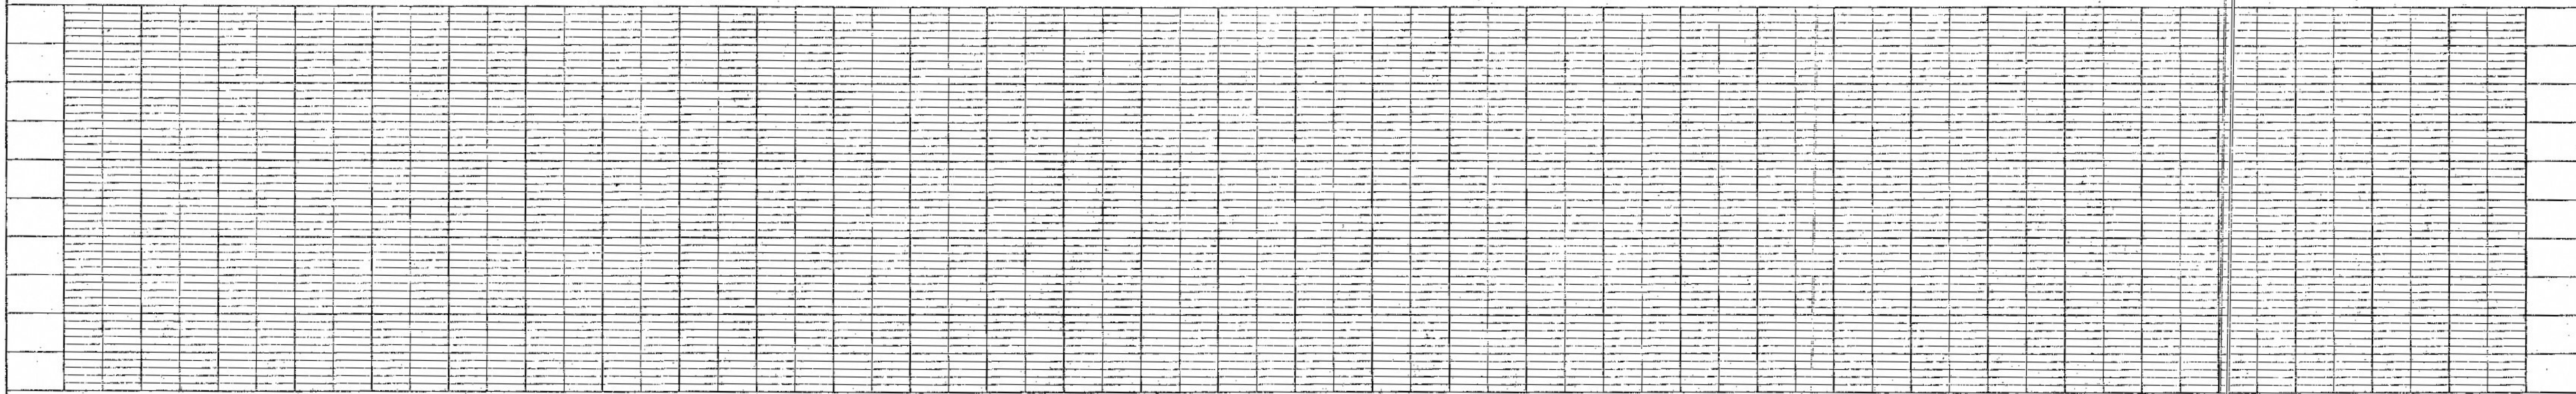

AS BUILT PLANS
 JOB NO. 467
 LUCAS PLUMBING '60.