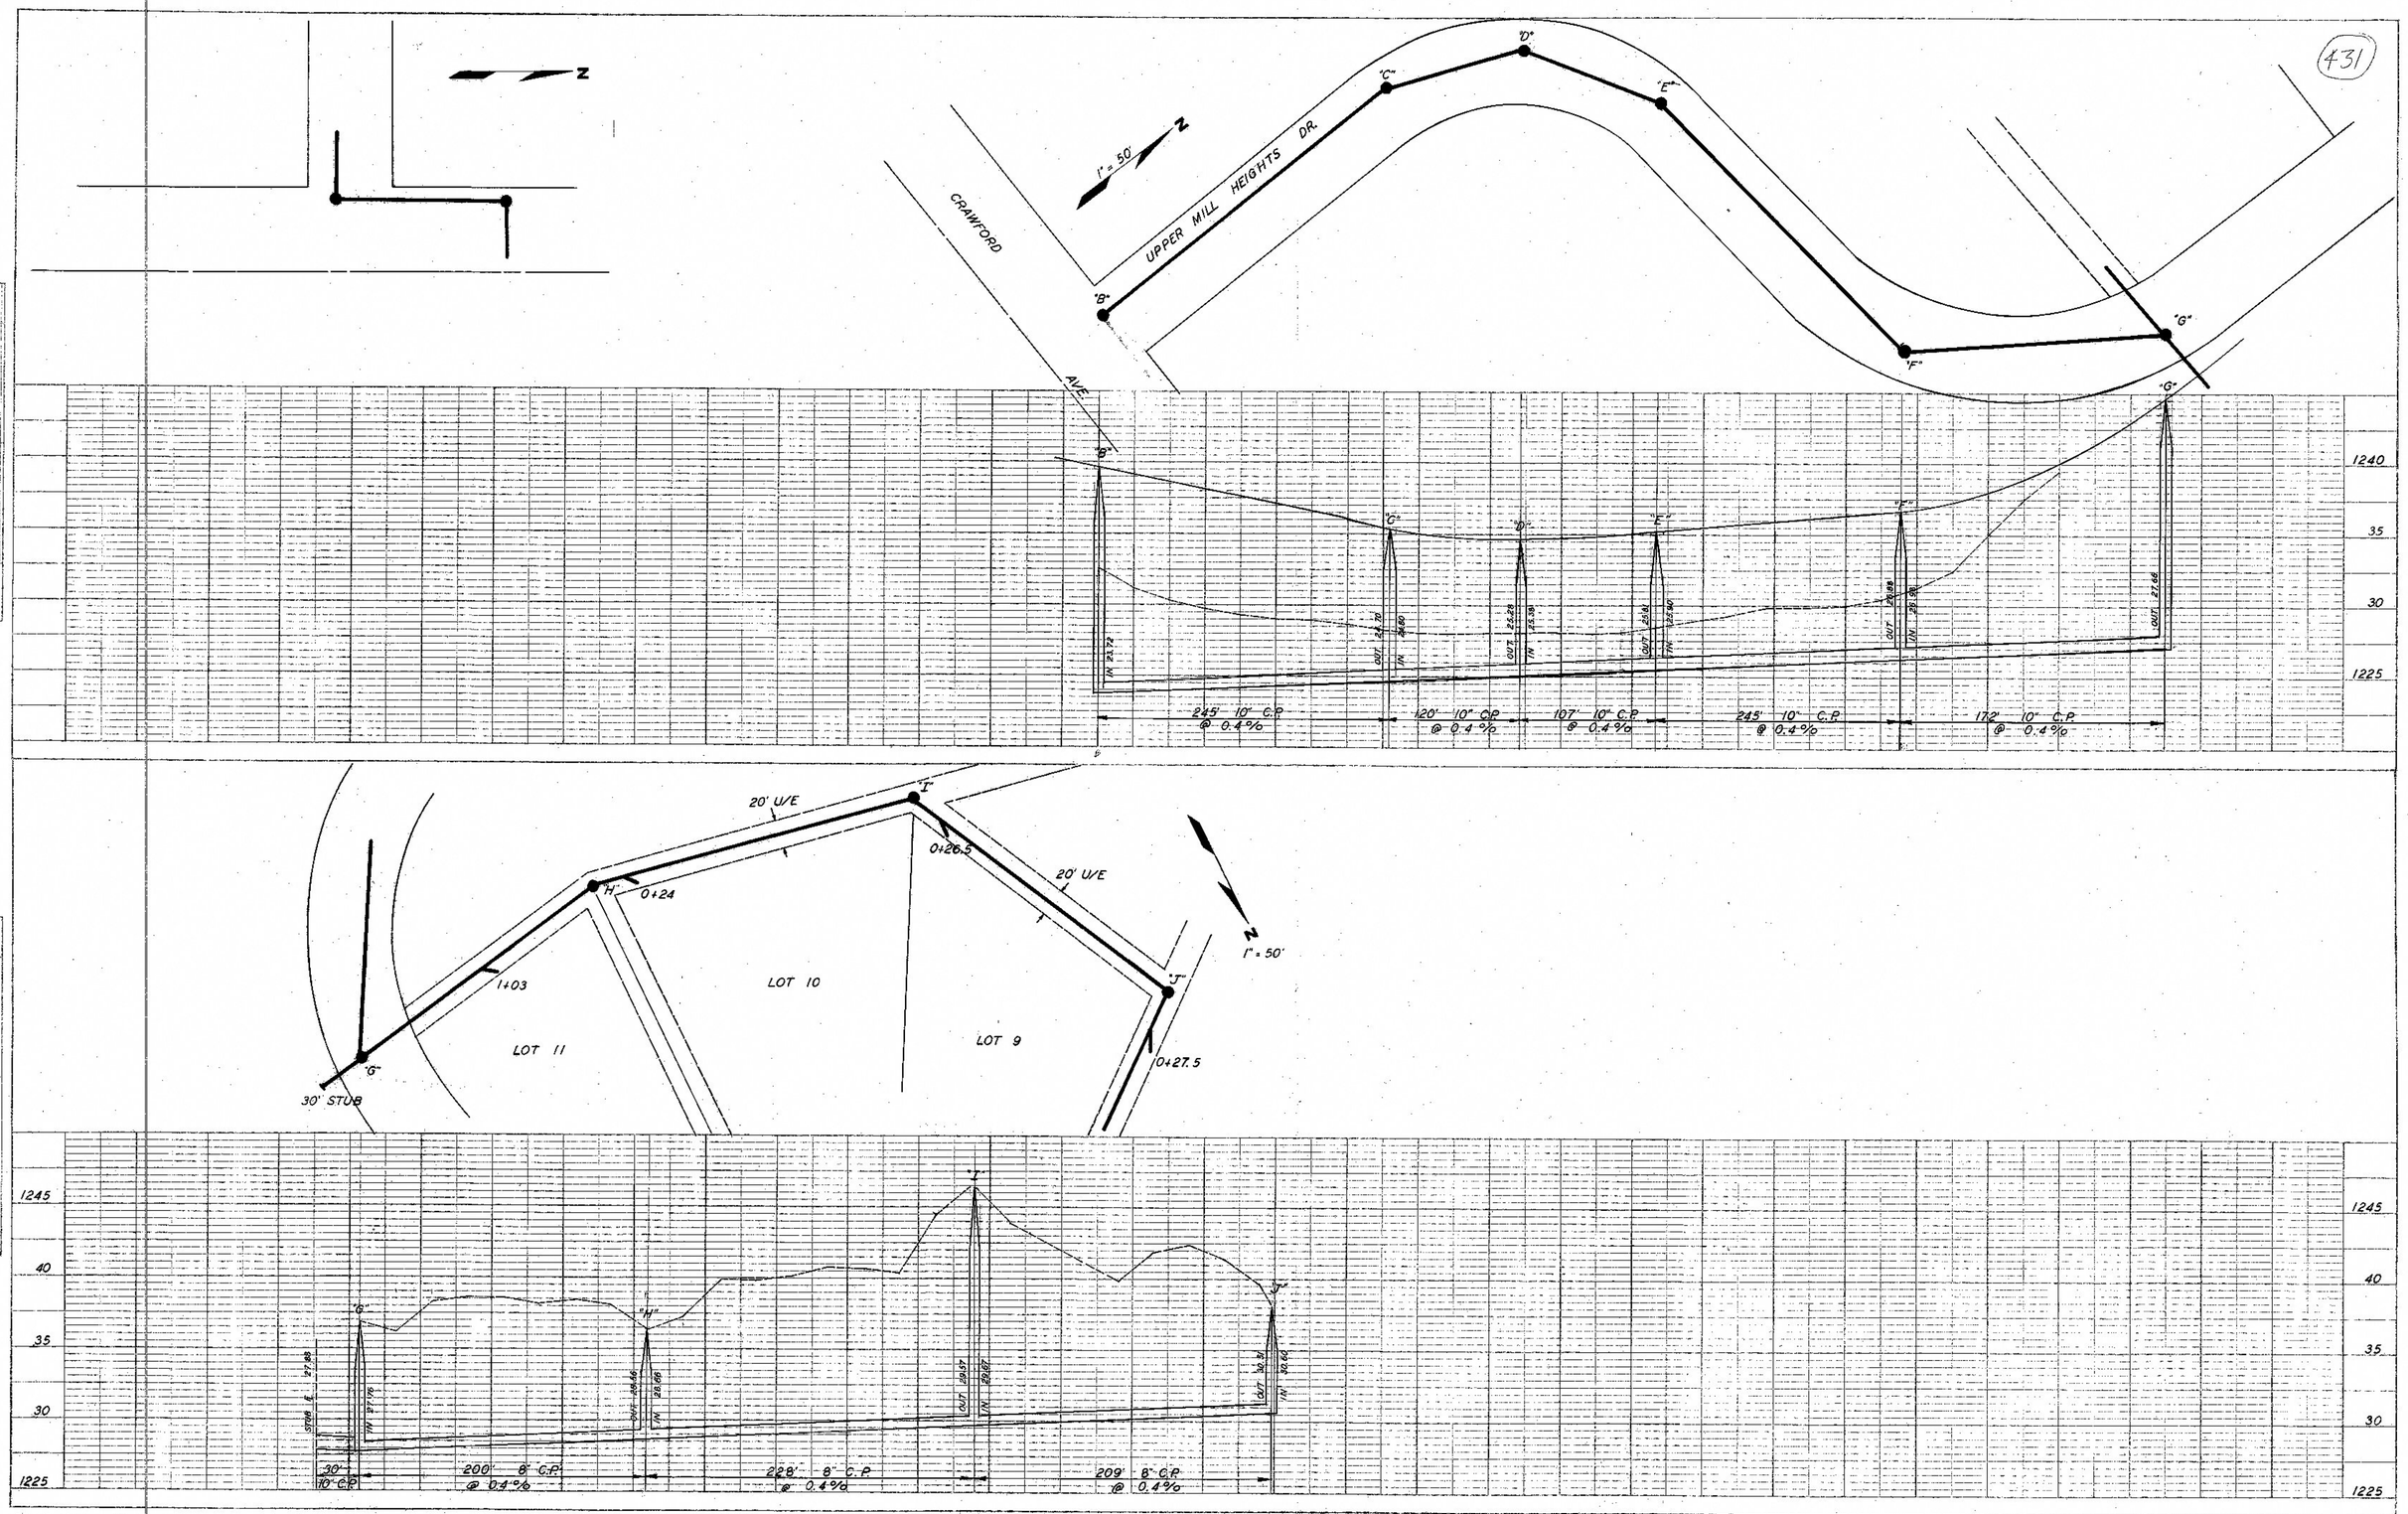

PLATE 2—PLAN—PROFILE O. P. R. & R. R.
MADE AND PRINTED BY THE
CHARLES BRUNING COMPANY, Inc.

BRUNING NO. 083 52671