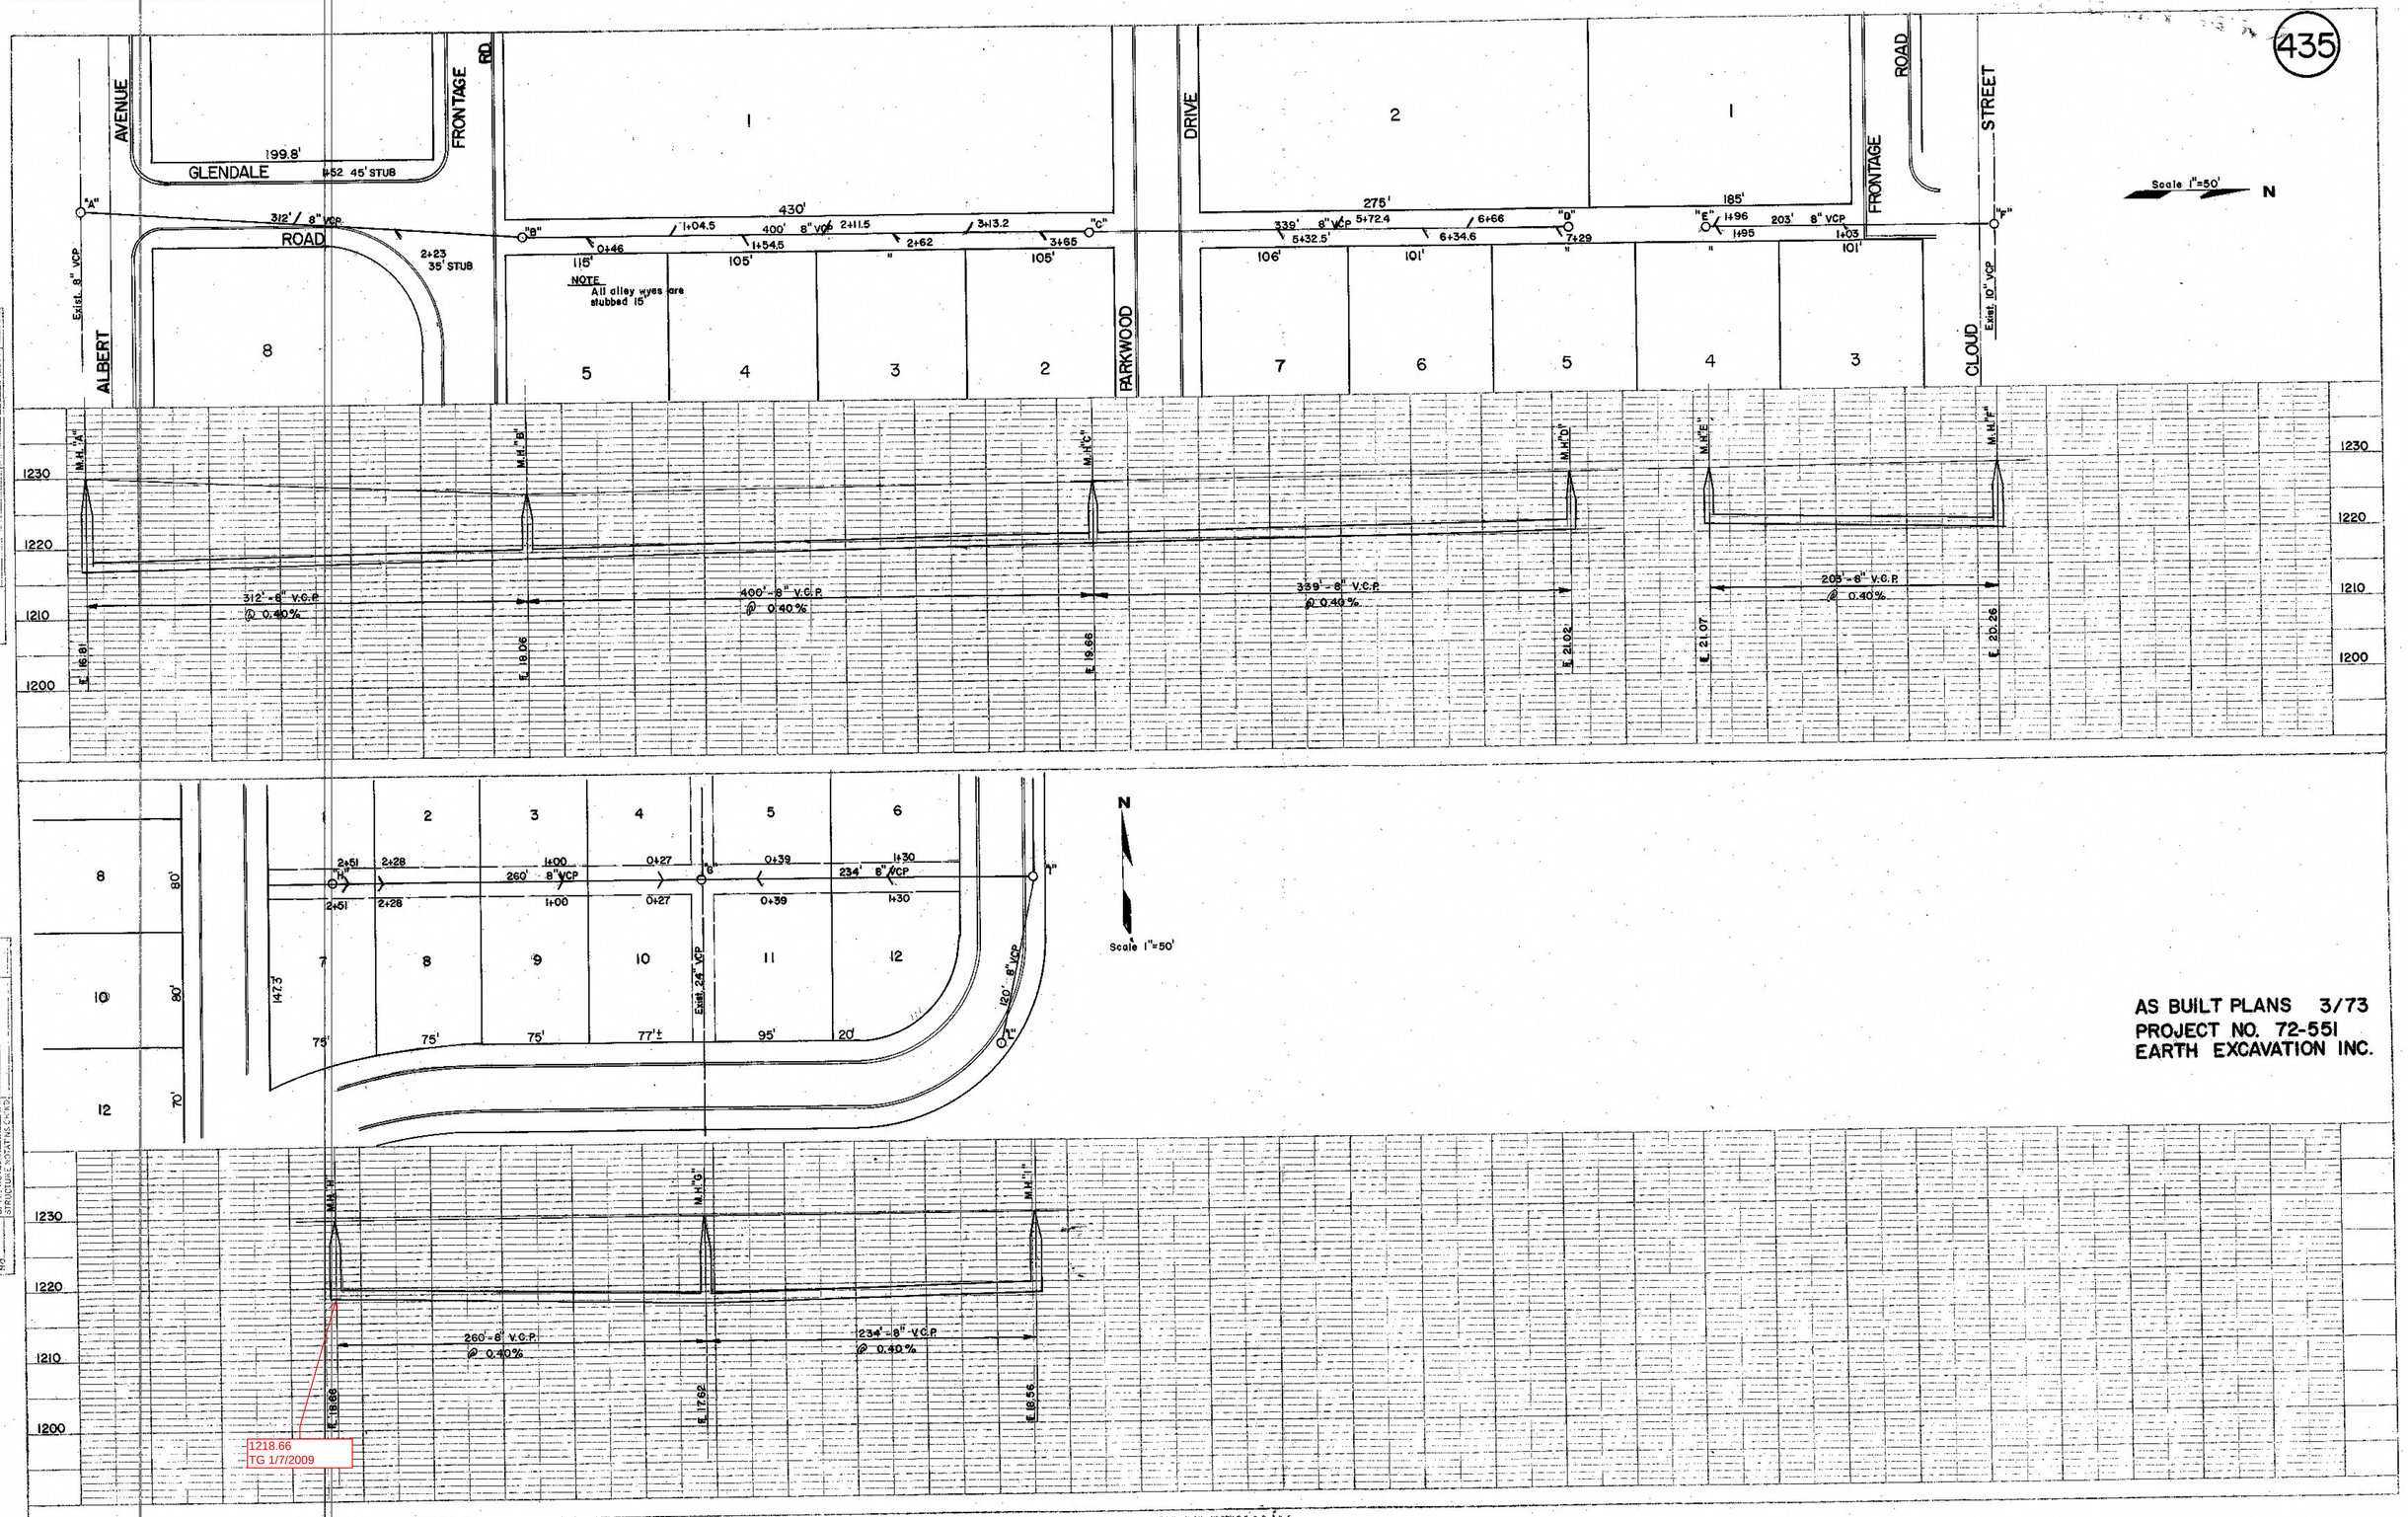

PLATE 2 - PLAN - PROFILE G. P. R. & R. E.
MADE AND PRINTED IN U. S. A.
THE ALEX. GRAHAM COMPANY, INC.