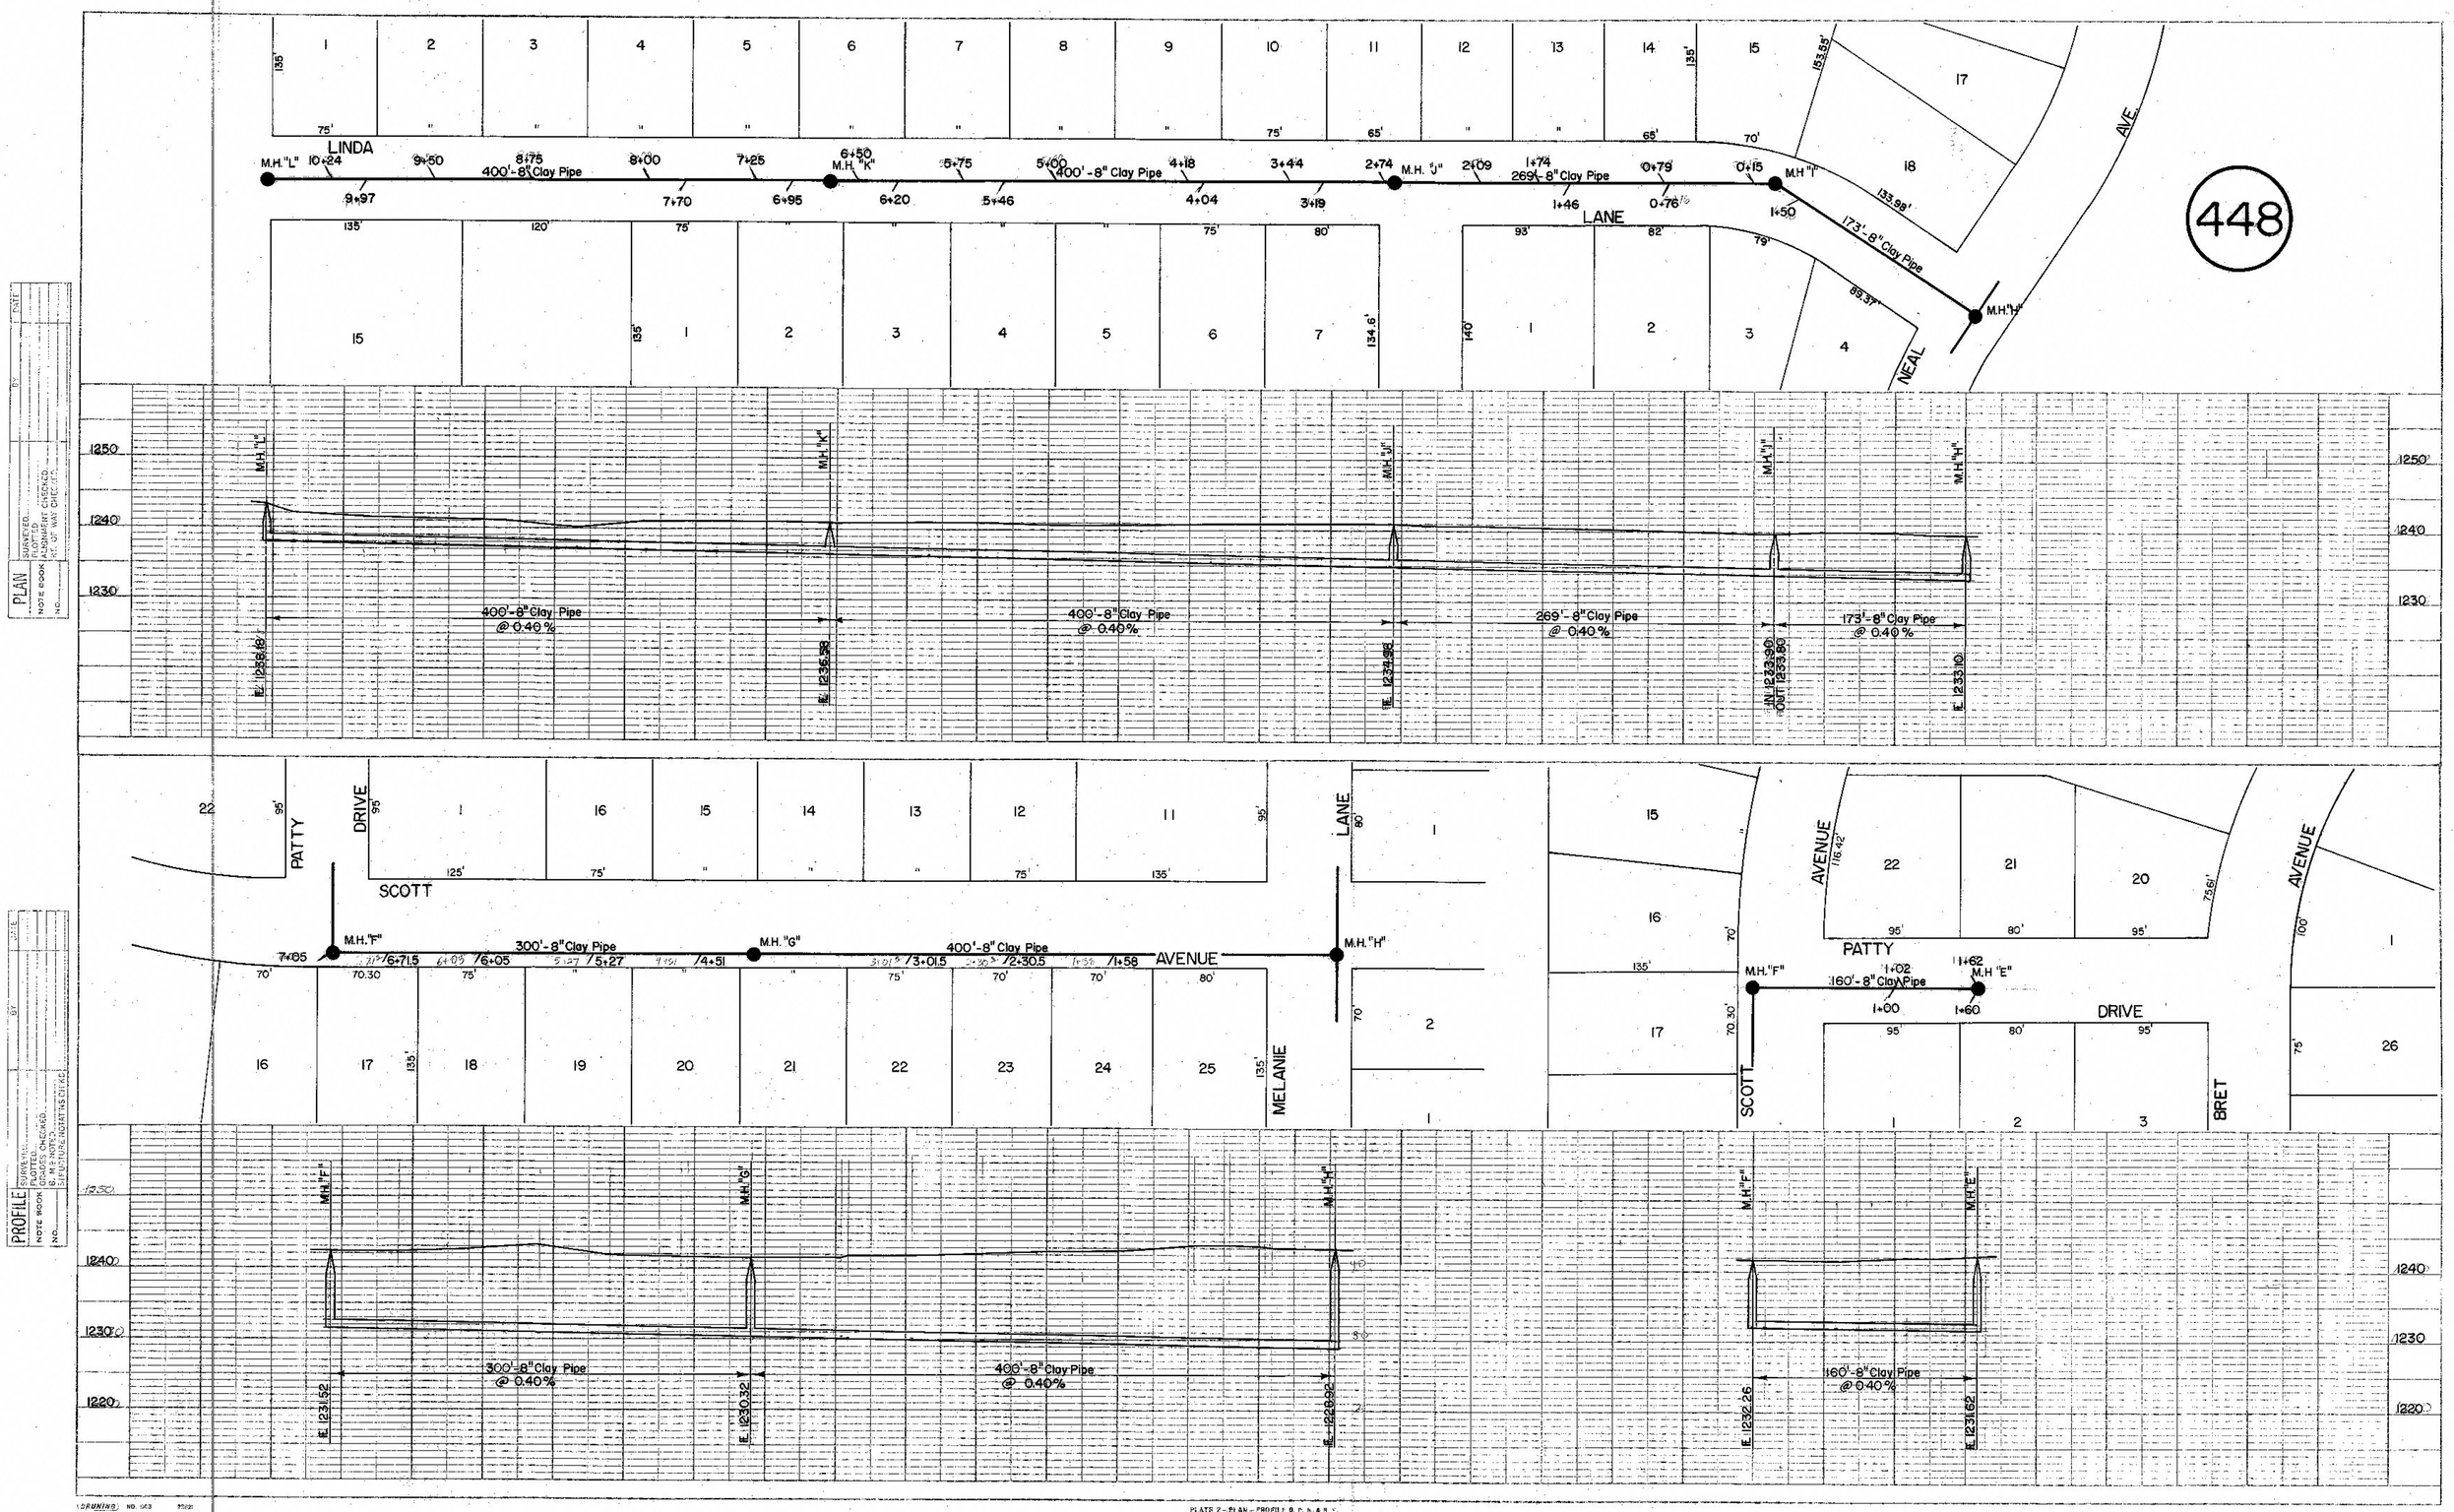

PLATE 2 – PLAN – PROFILE O. P. N. & R. Y.
CHARLES BRUNING COMPANY, INC.
BRUNING NO. 563