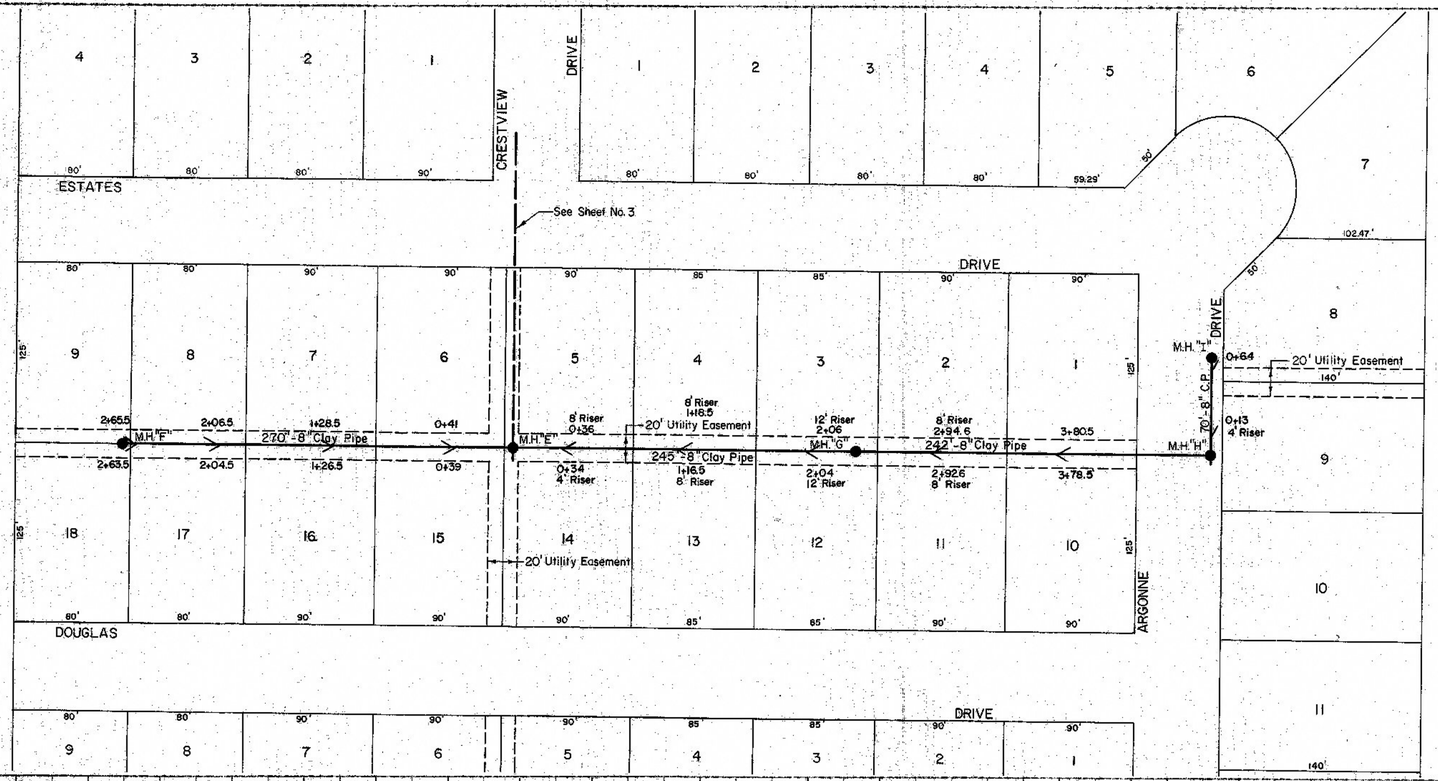

AS BUILT PLANS
PROJECT NO. 75-575
SMOKY HILL INC.
COMPLETION DATE
JULY 1975

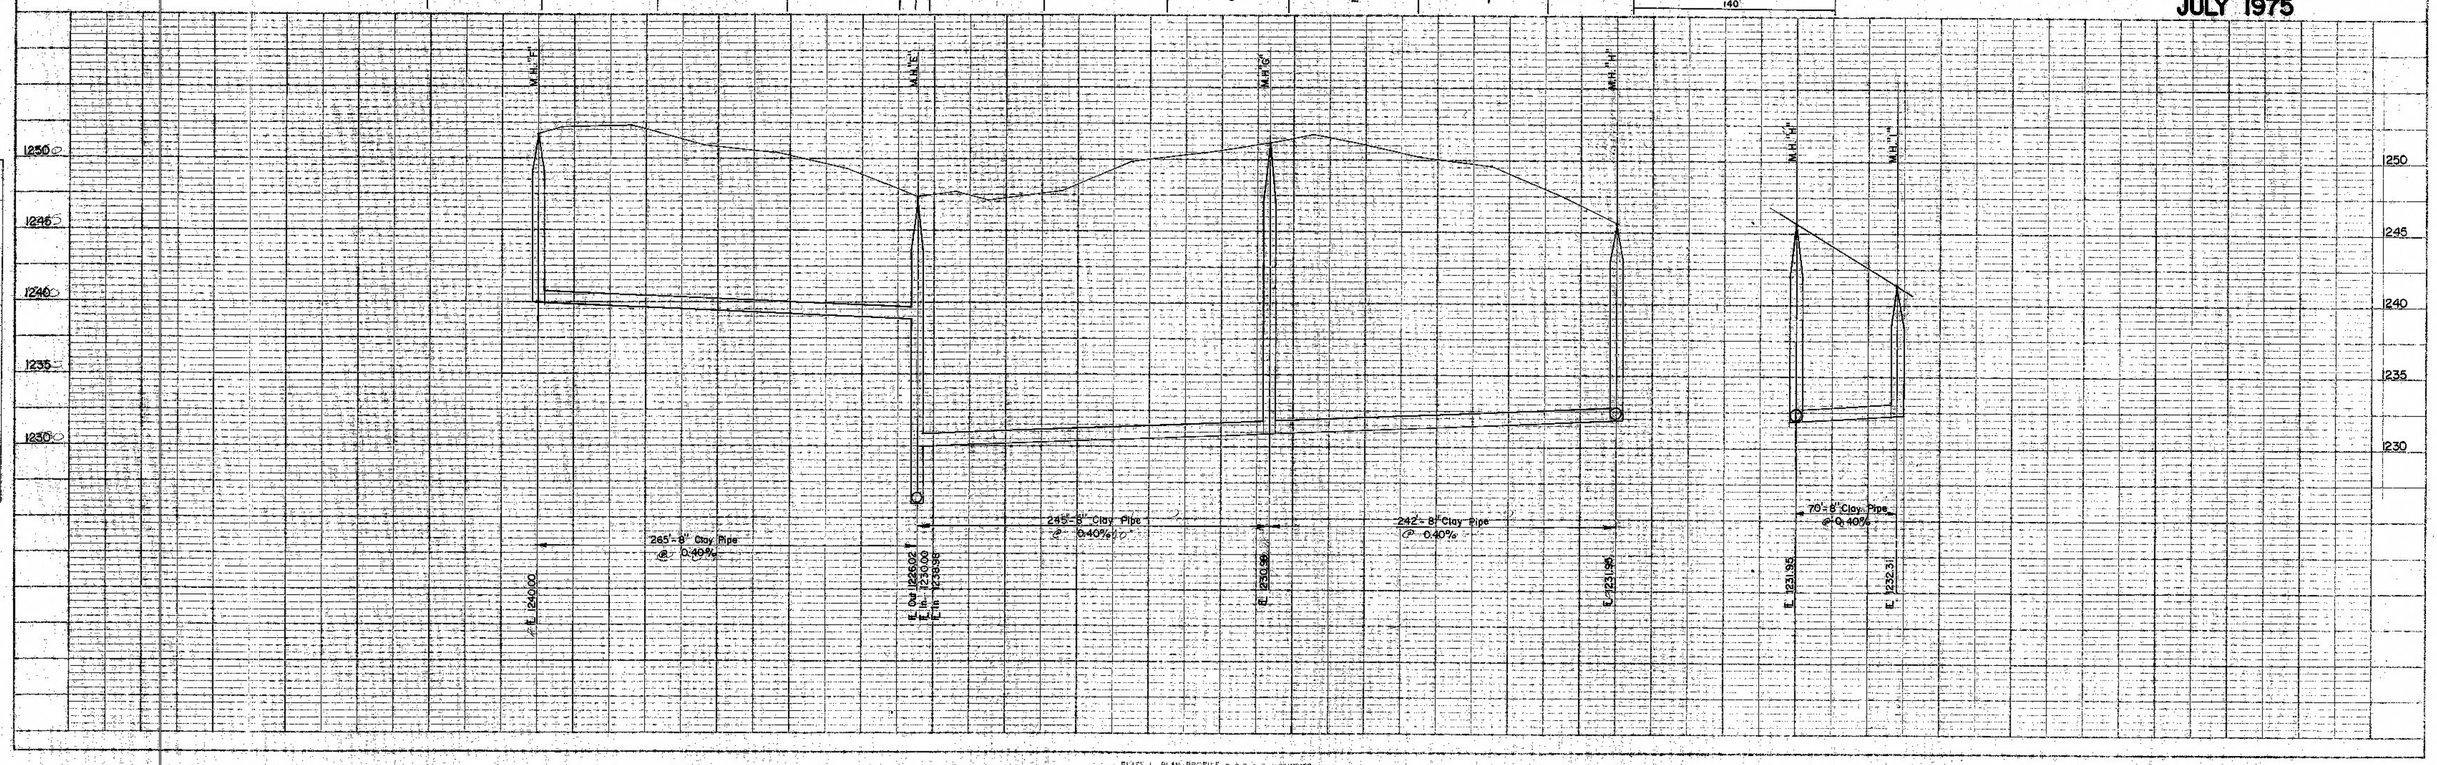

PLAN
SURVEYED
PLOTTED
NOTE BOOK
ALIGNMENT CHECKED
RT. OF WAY CHECKED
NO.
BY
DATE

PROFILE
SURVEYED
PLOTTED
NOTE BOOK
GRADES CHECKED
S. M.S. NOTED
STRUCTURE NOTATING CHKD.
NO.
BY
DATE

PLATE 1 - PLAN-PROFILE S.P.S.A.R. STANDARD
REVISED, NIESSEN CO. NEW YORK
K.A.S.H.O. NO. 2146-11