466

AS BUILT PLANS
PROJECT NO. 76-601
SMOKY HILL INC.
AUGUST 1976

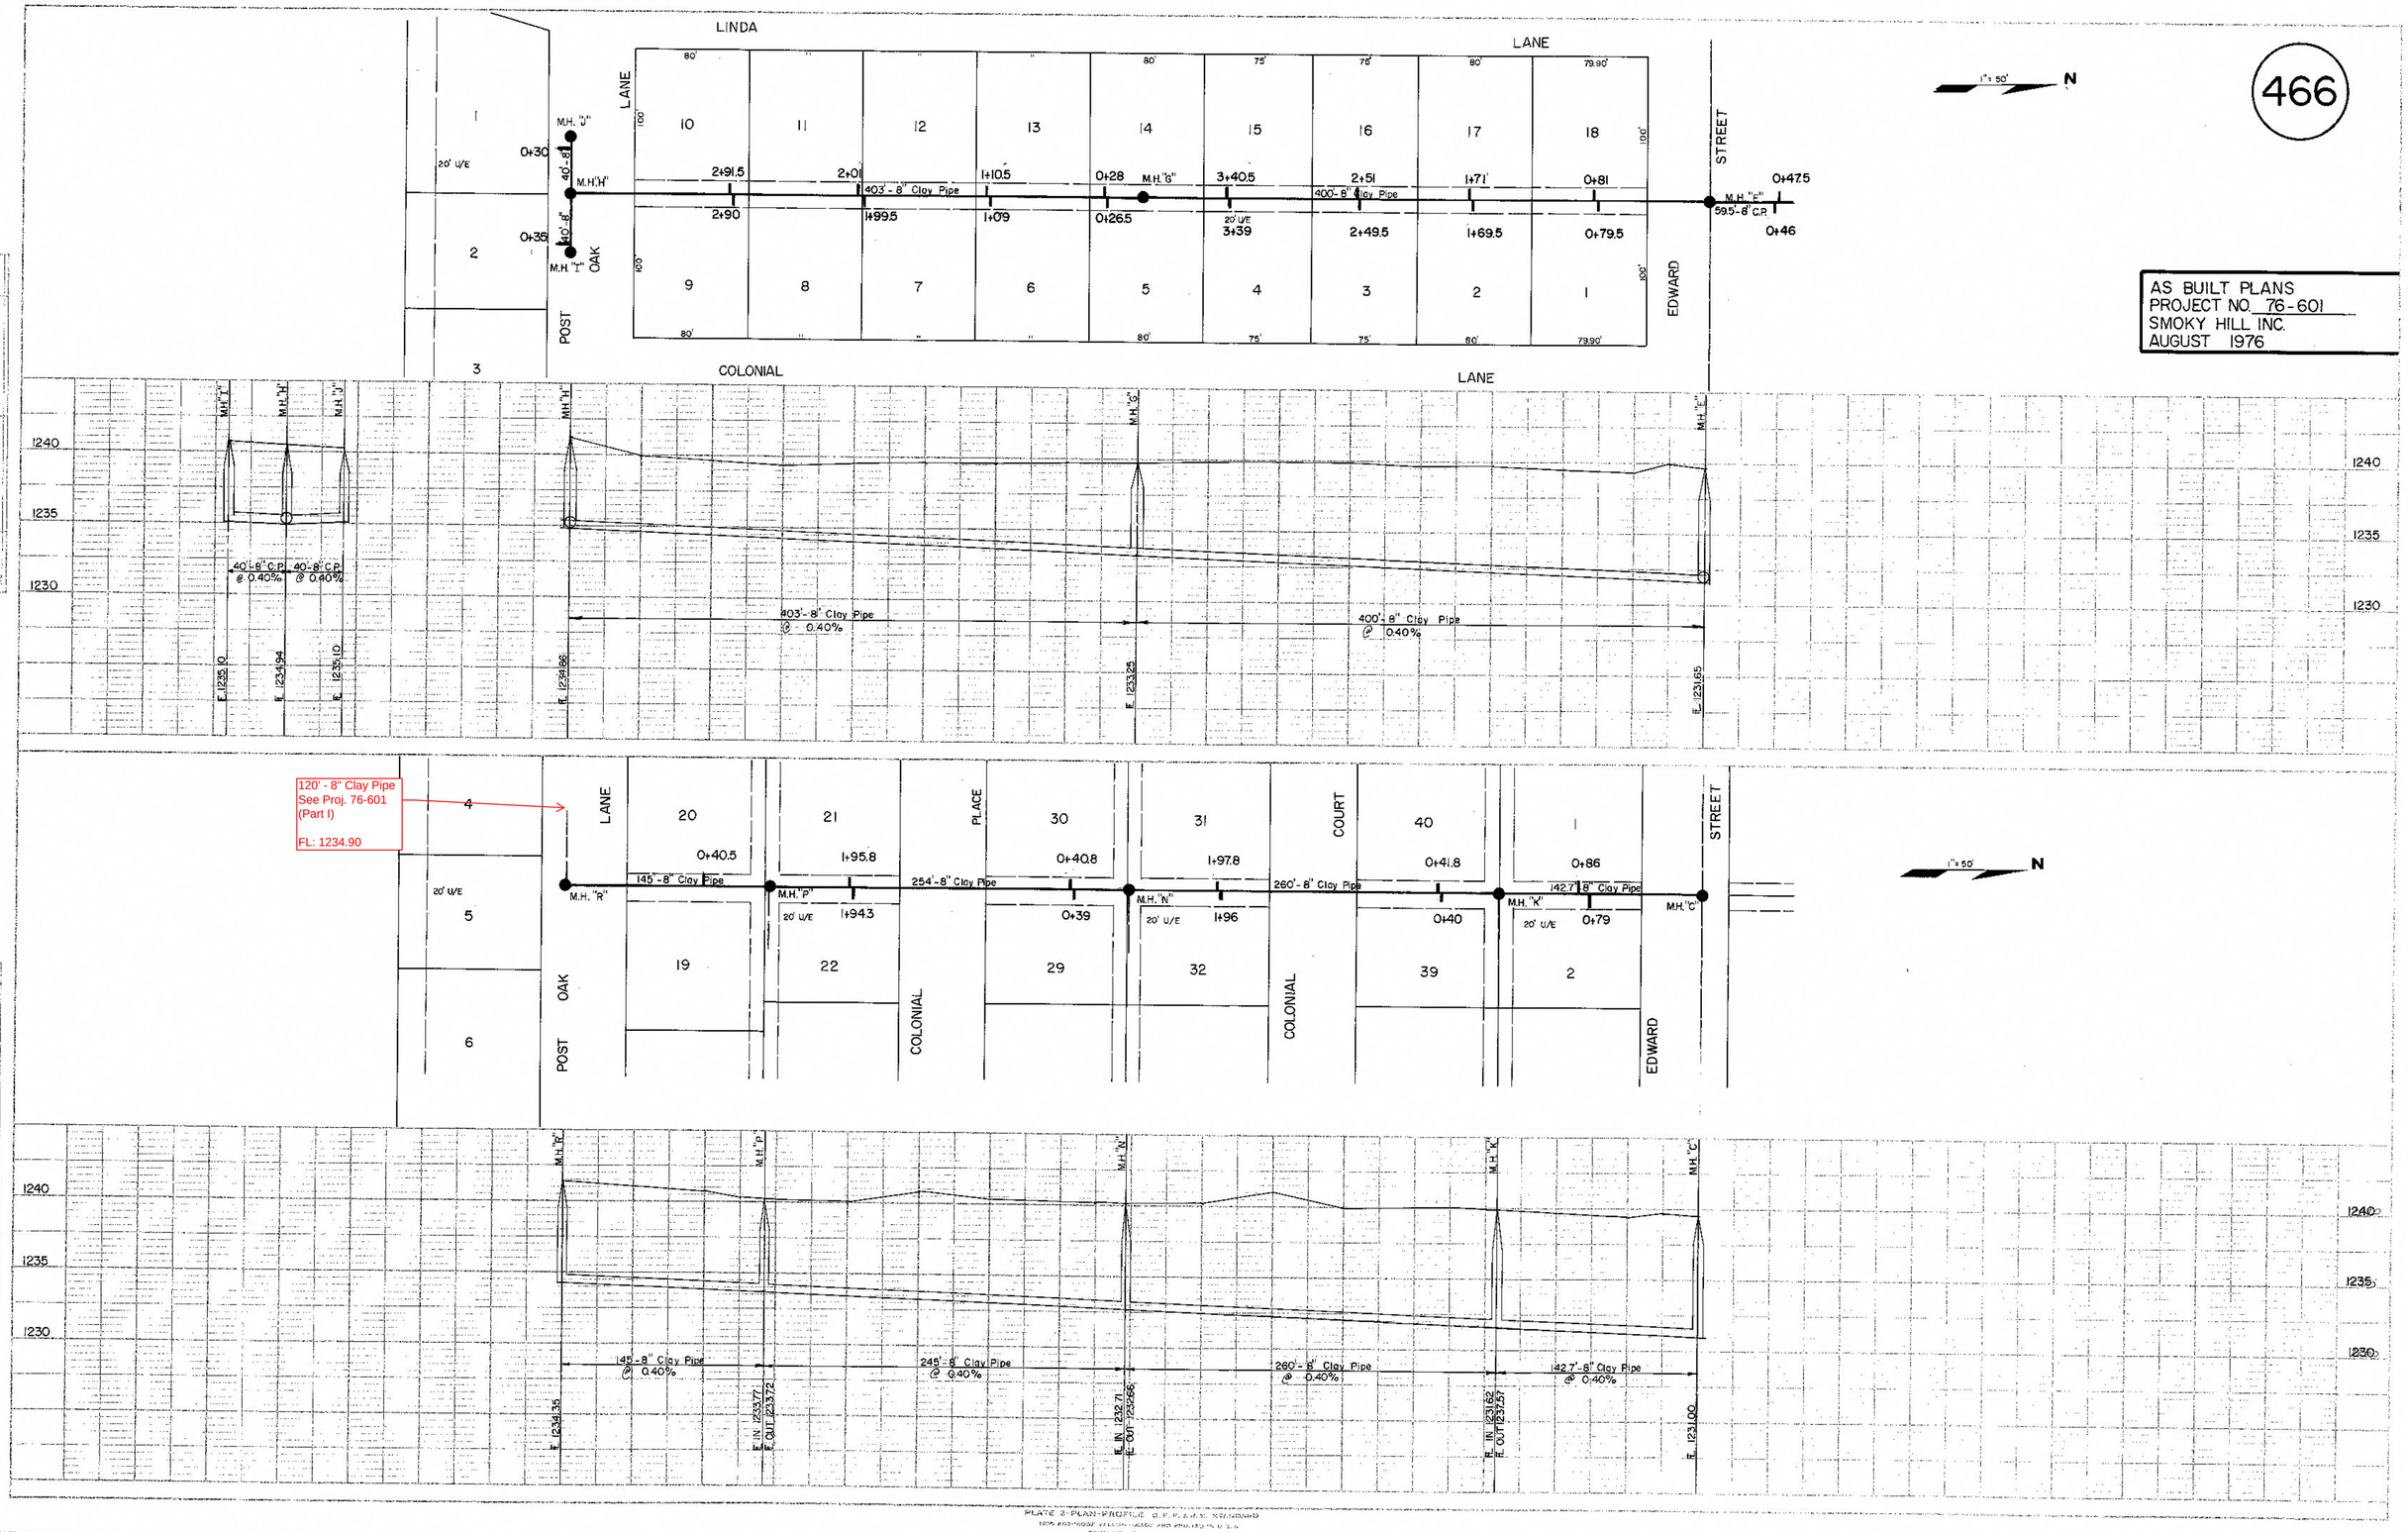

PLATE 2-PLAN-PROFILE O.P.R.A.R.E. 127/1000