467

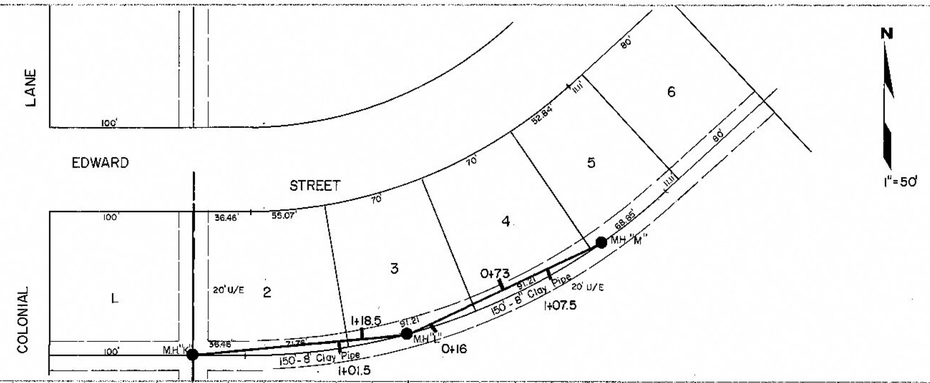

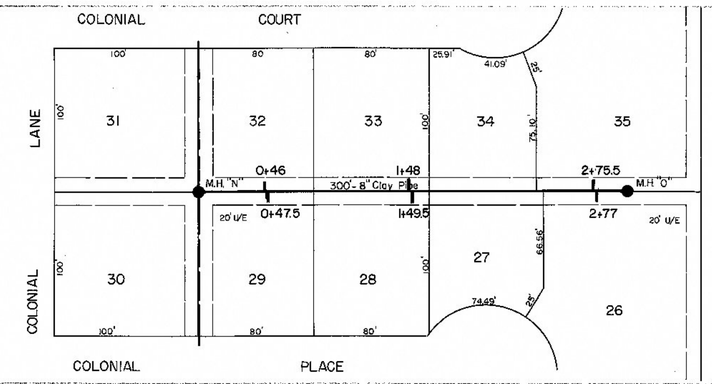

AS BUILT PLANS
PROJECT NO. 76-601
SMOKY HILL INC.
AUGUST 1976

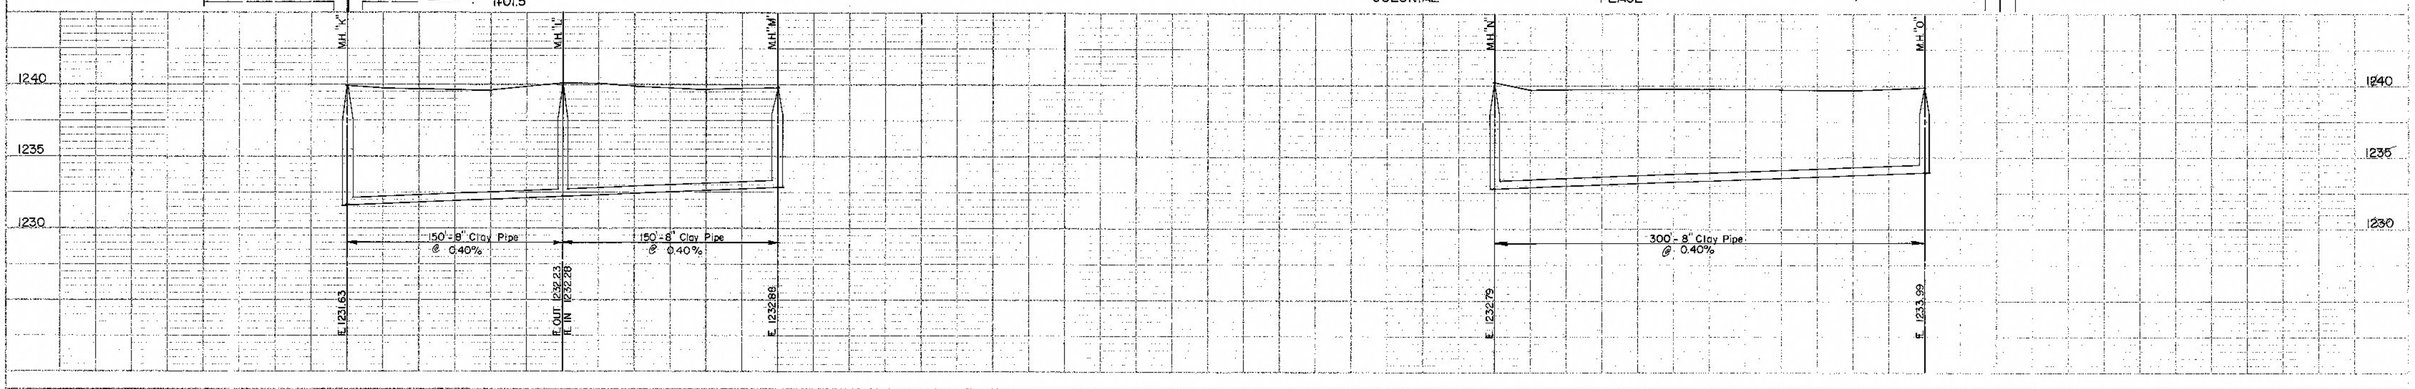

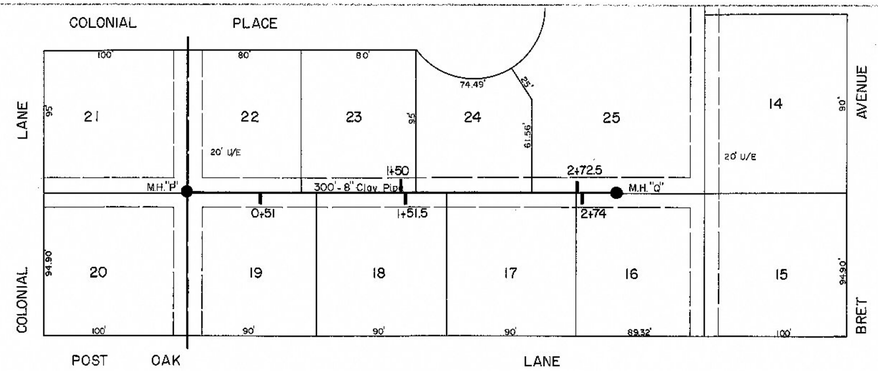

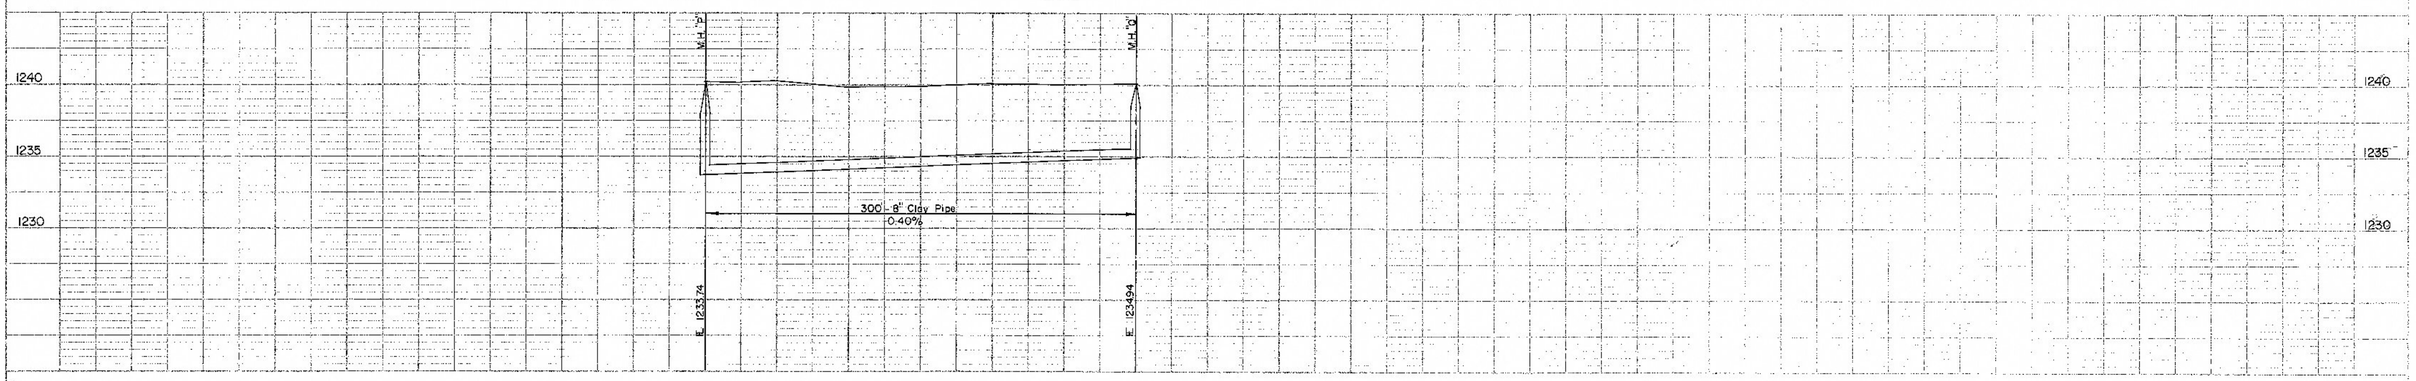

PLAN
SURVEYED
PLOTTED
CHECKED
DATE SCALE
PROFILE
SURVEYED
PLOTTED
CHECKED
DATE SCALE

PLATE 2-PLAN-PROFILE C.M.A.S.W.C. STANDARD
DES. ARCHIBALD TELLING, JR. AND APPROVED 5-11-61 U.S.A.
EUGENE DIETZDEN CO.