472
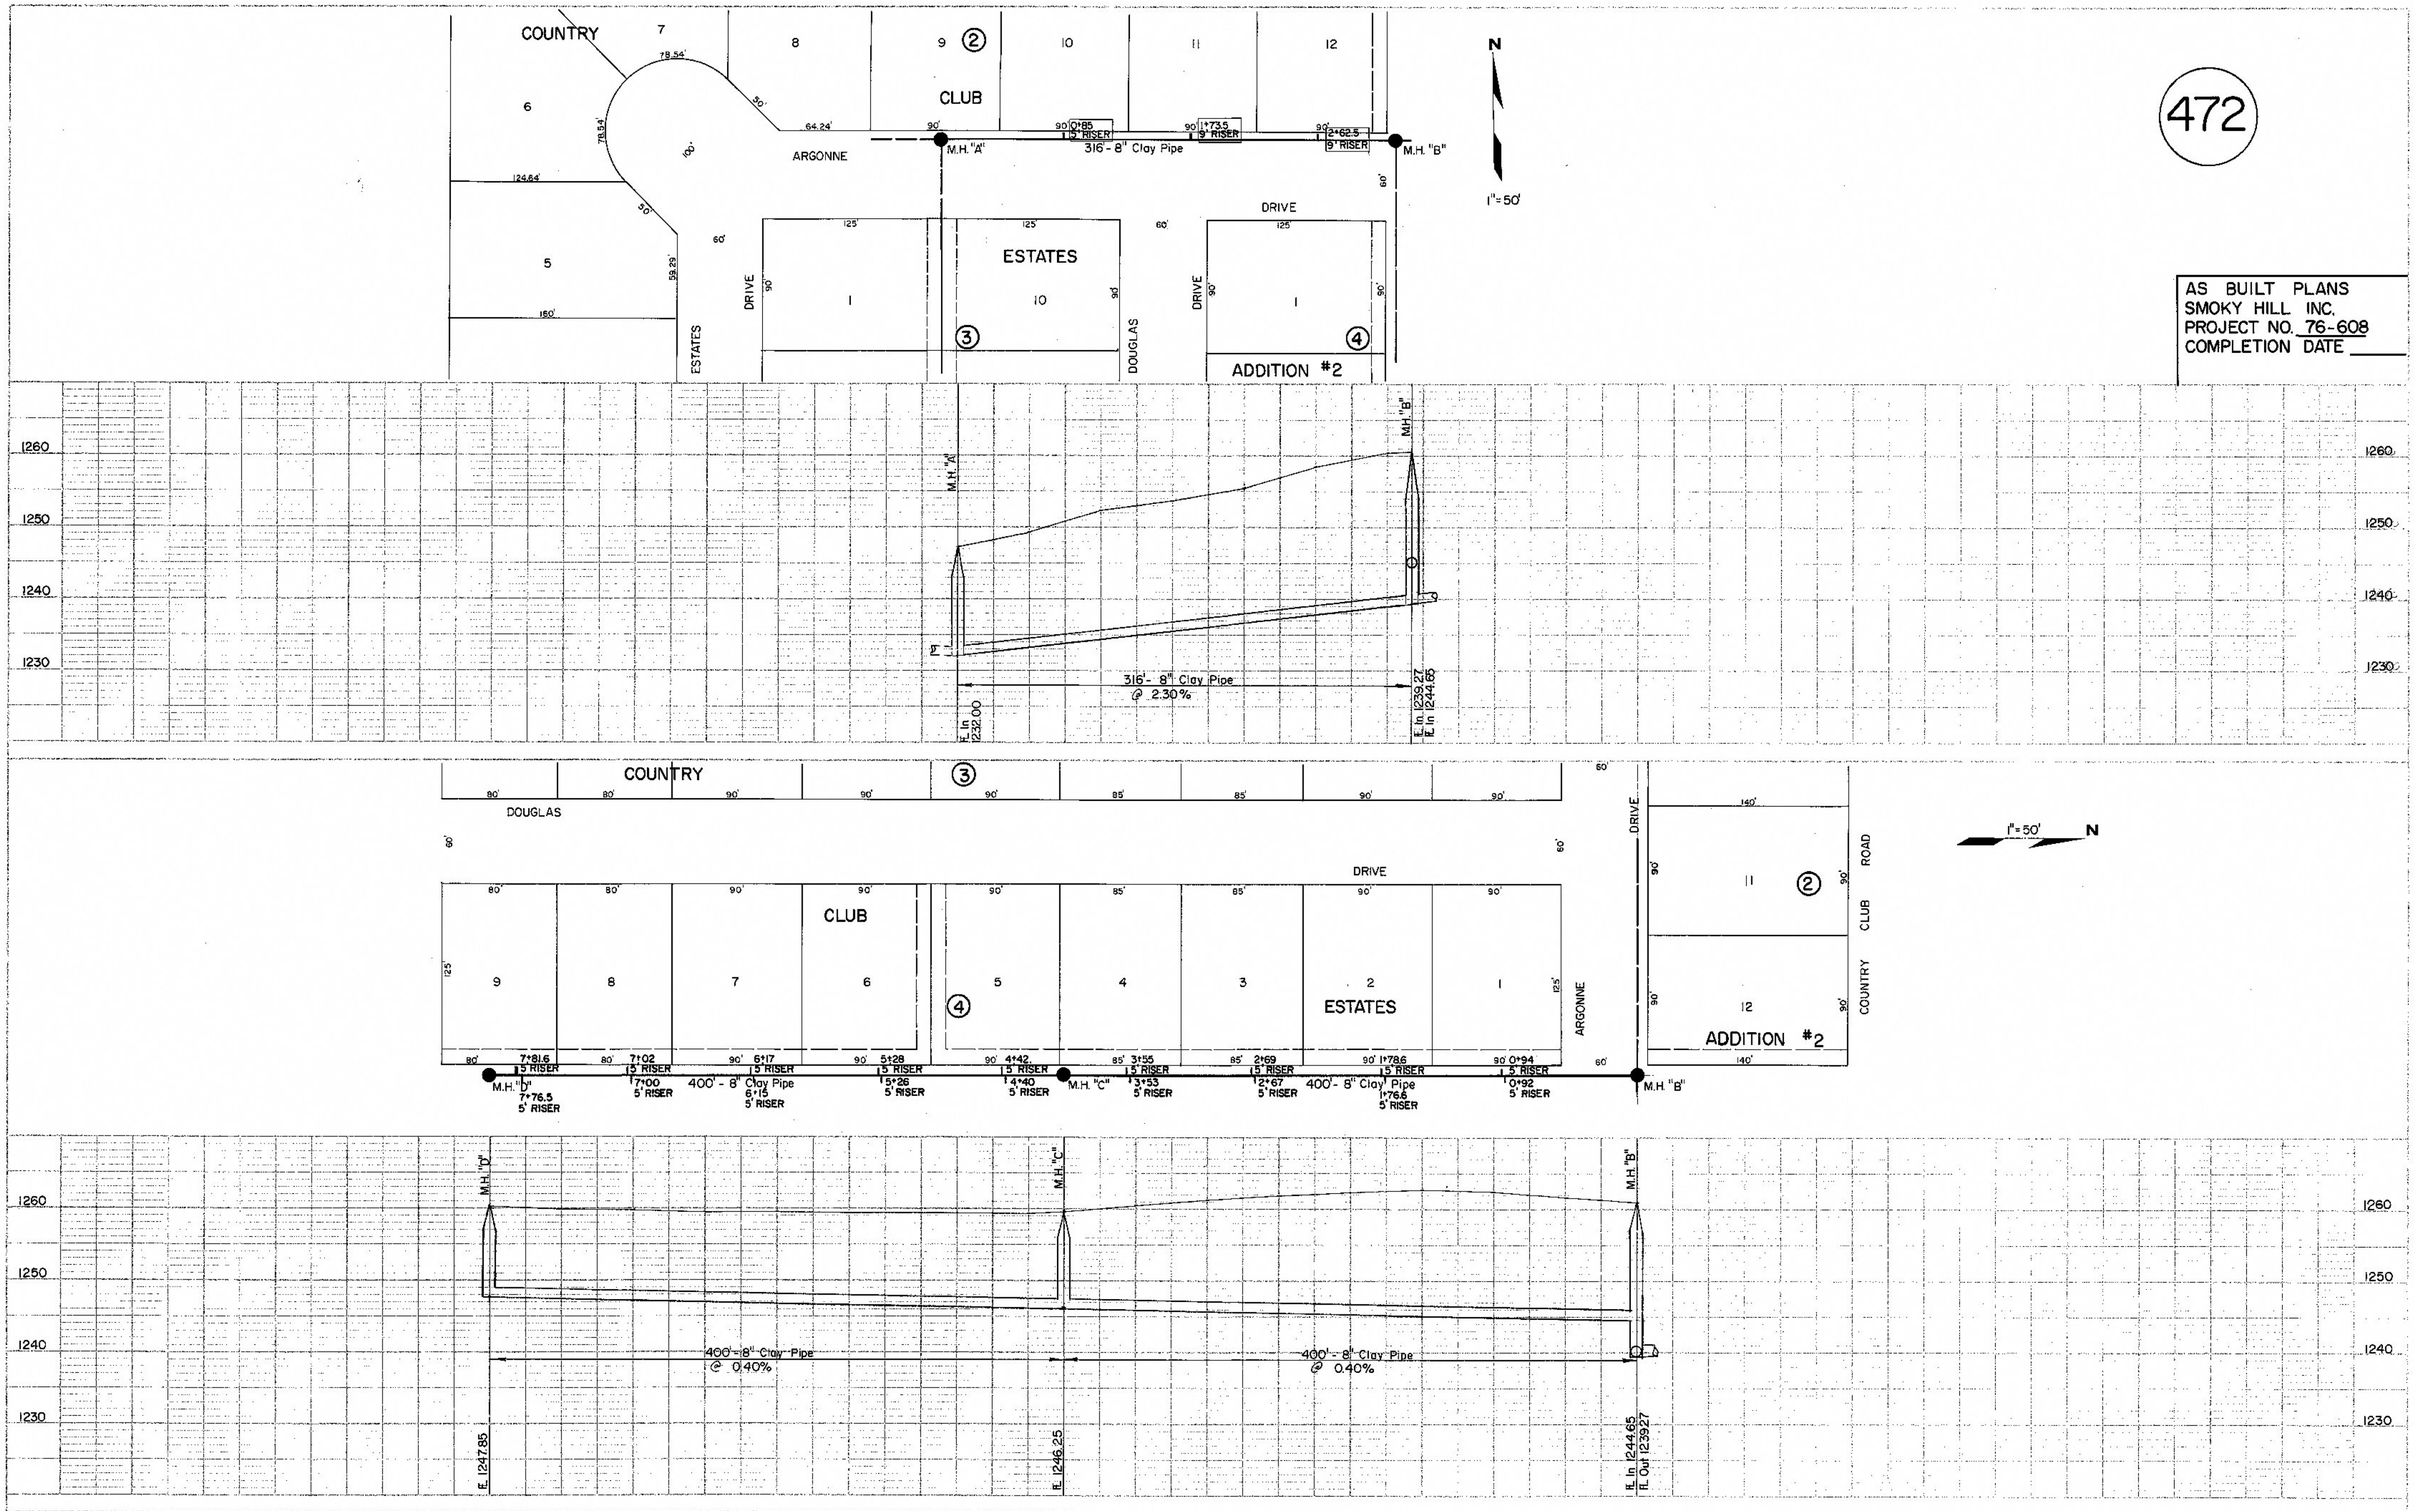
AS BUILT PLANS
SMOKY HILL INC.
PROJECT NO. 76-608
COMPLETION DATE _____