


HOLMQUIST ESTATES ADDITION

AS-BUILT PLAN  
PRIVATE PROJECT  
EARTH EXCAVATION  
COMPLETION DATE: DEC. 1976

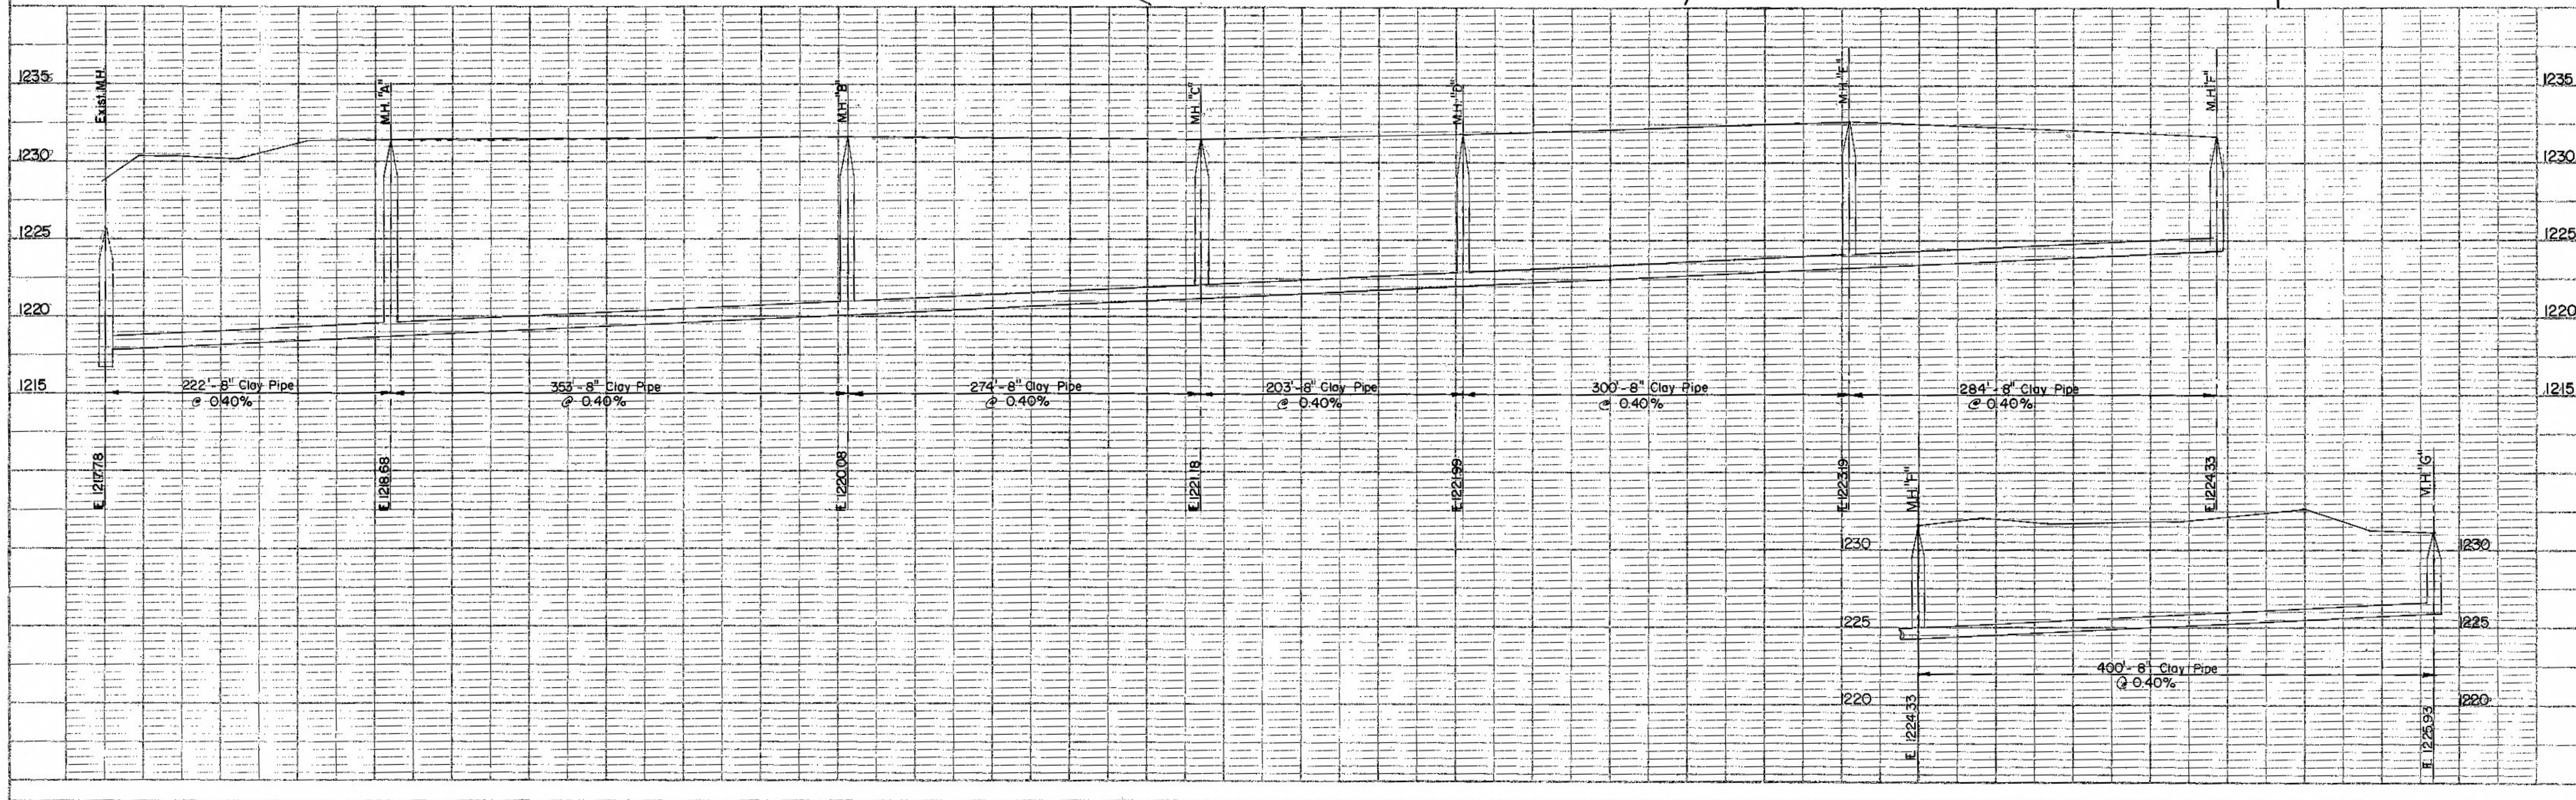

PLAN  
NOTE BOOK  
No.

PROFILE  
NOTE BOOK  
No.