480

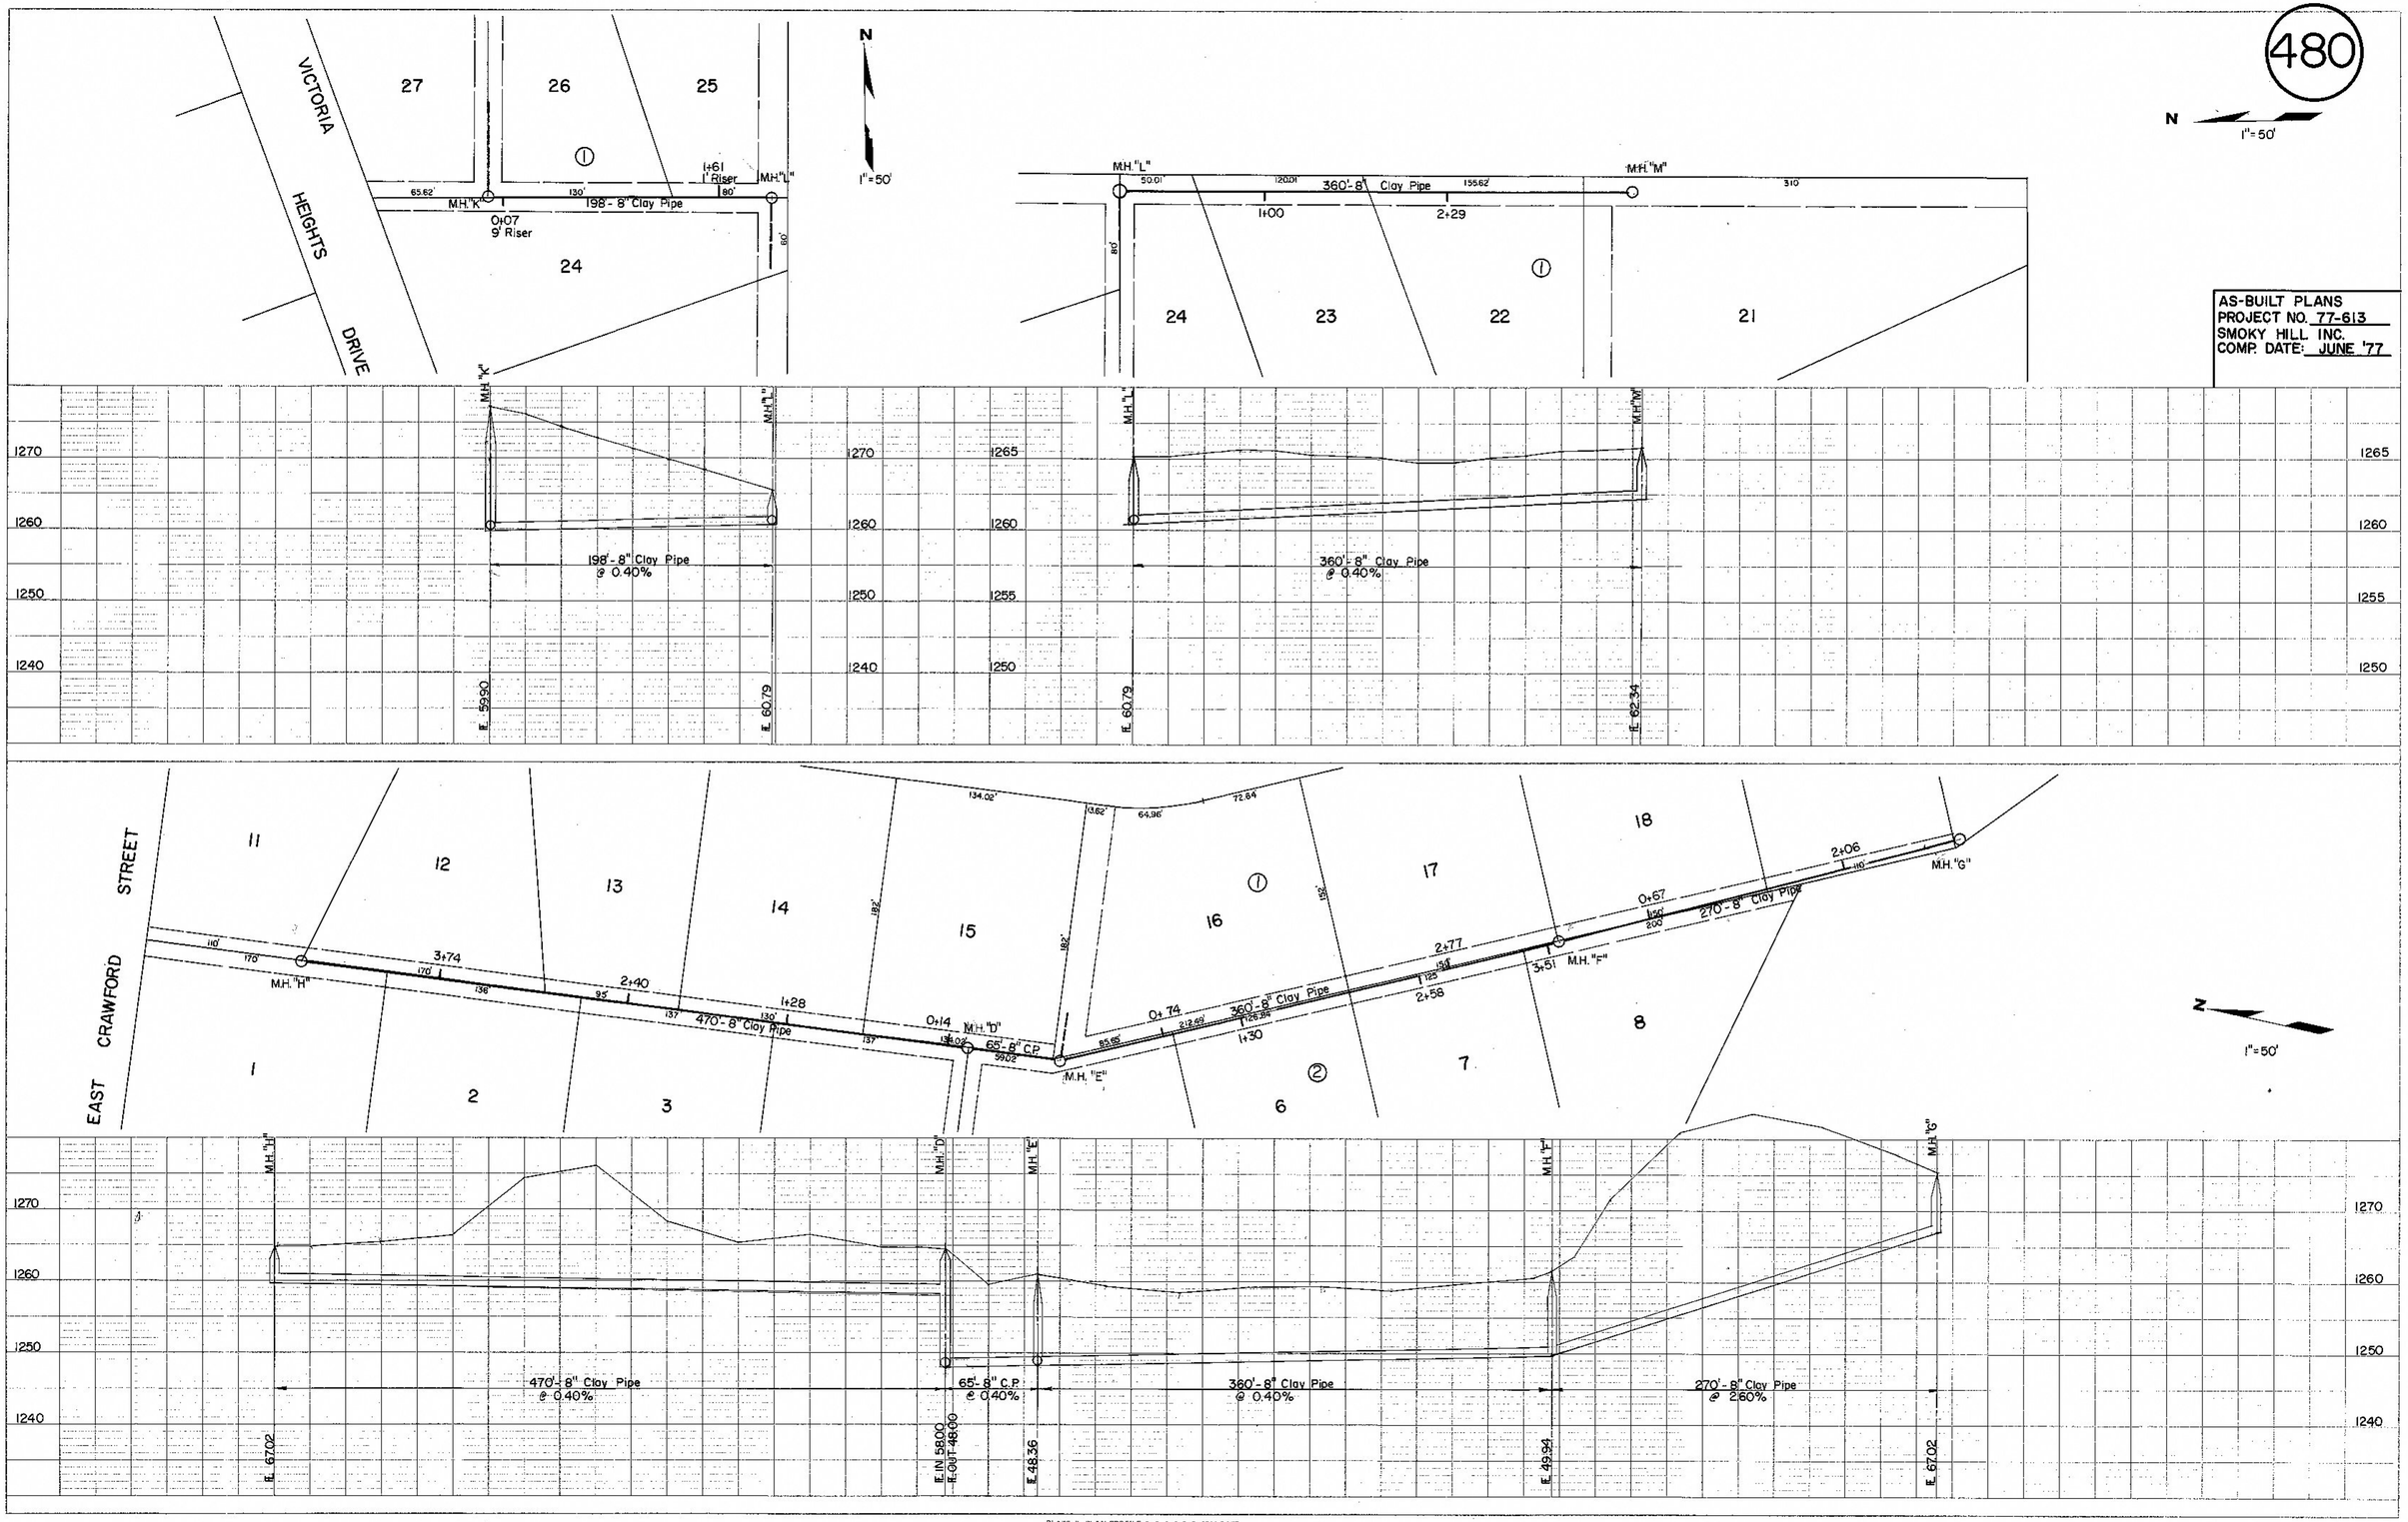

AS-BUILT PLANS
PROJECT NO. 77-613
SMOKY HILL INC.
COMP. DATE: JUNE '77

PLAN
NOTE BOOK
NO.
SURVEYED
PLOTTED
ALIGNMENT CHECKED
RT. OF WAY DEDICATED
BY
DATE

PROFILE
NOTE BOOK
NO.
SURVEYED
PLOTTED
GRADES CHECKED
BRIDGE NO.
STRUCTURE NOTE NO. CHK'D.
BY
DATE

PLATE 2 PLAN-PROFILE O. P. R. & R. E. STANDARD
100% RAG DEEPROOF VELLUM—MADE AND PRINTED IN U. S. A.
LUDLOW DIETZGEN CO.