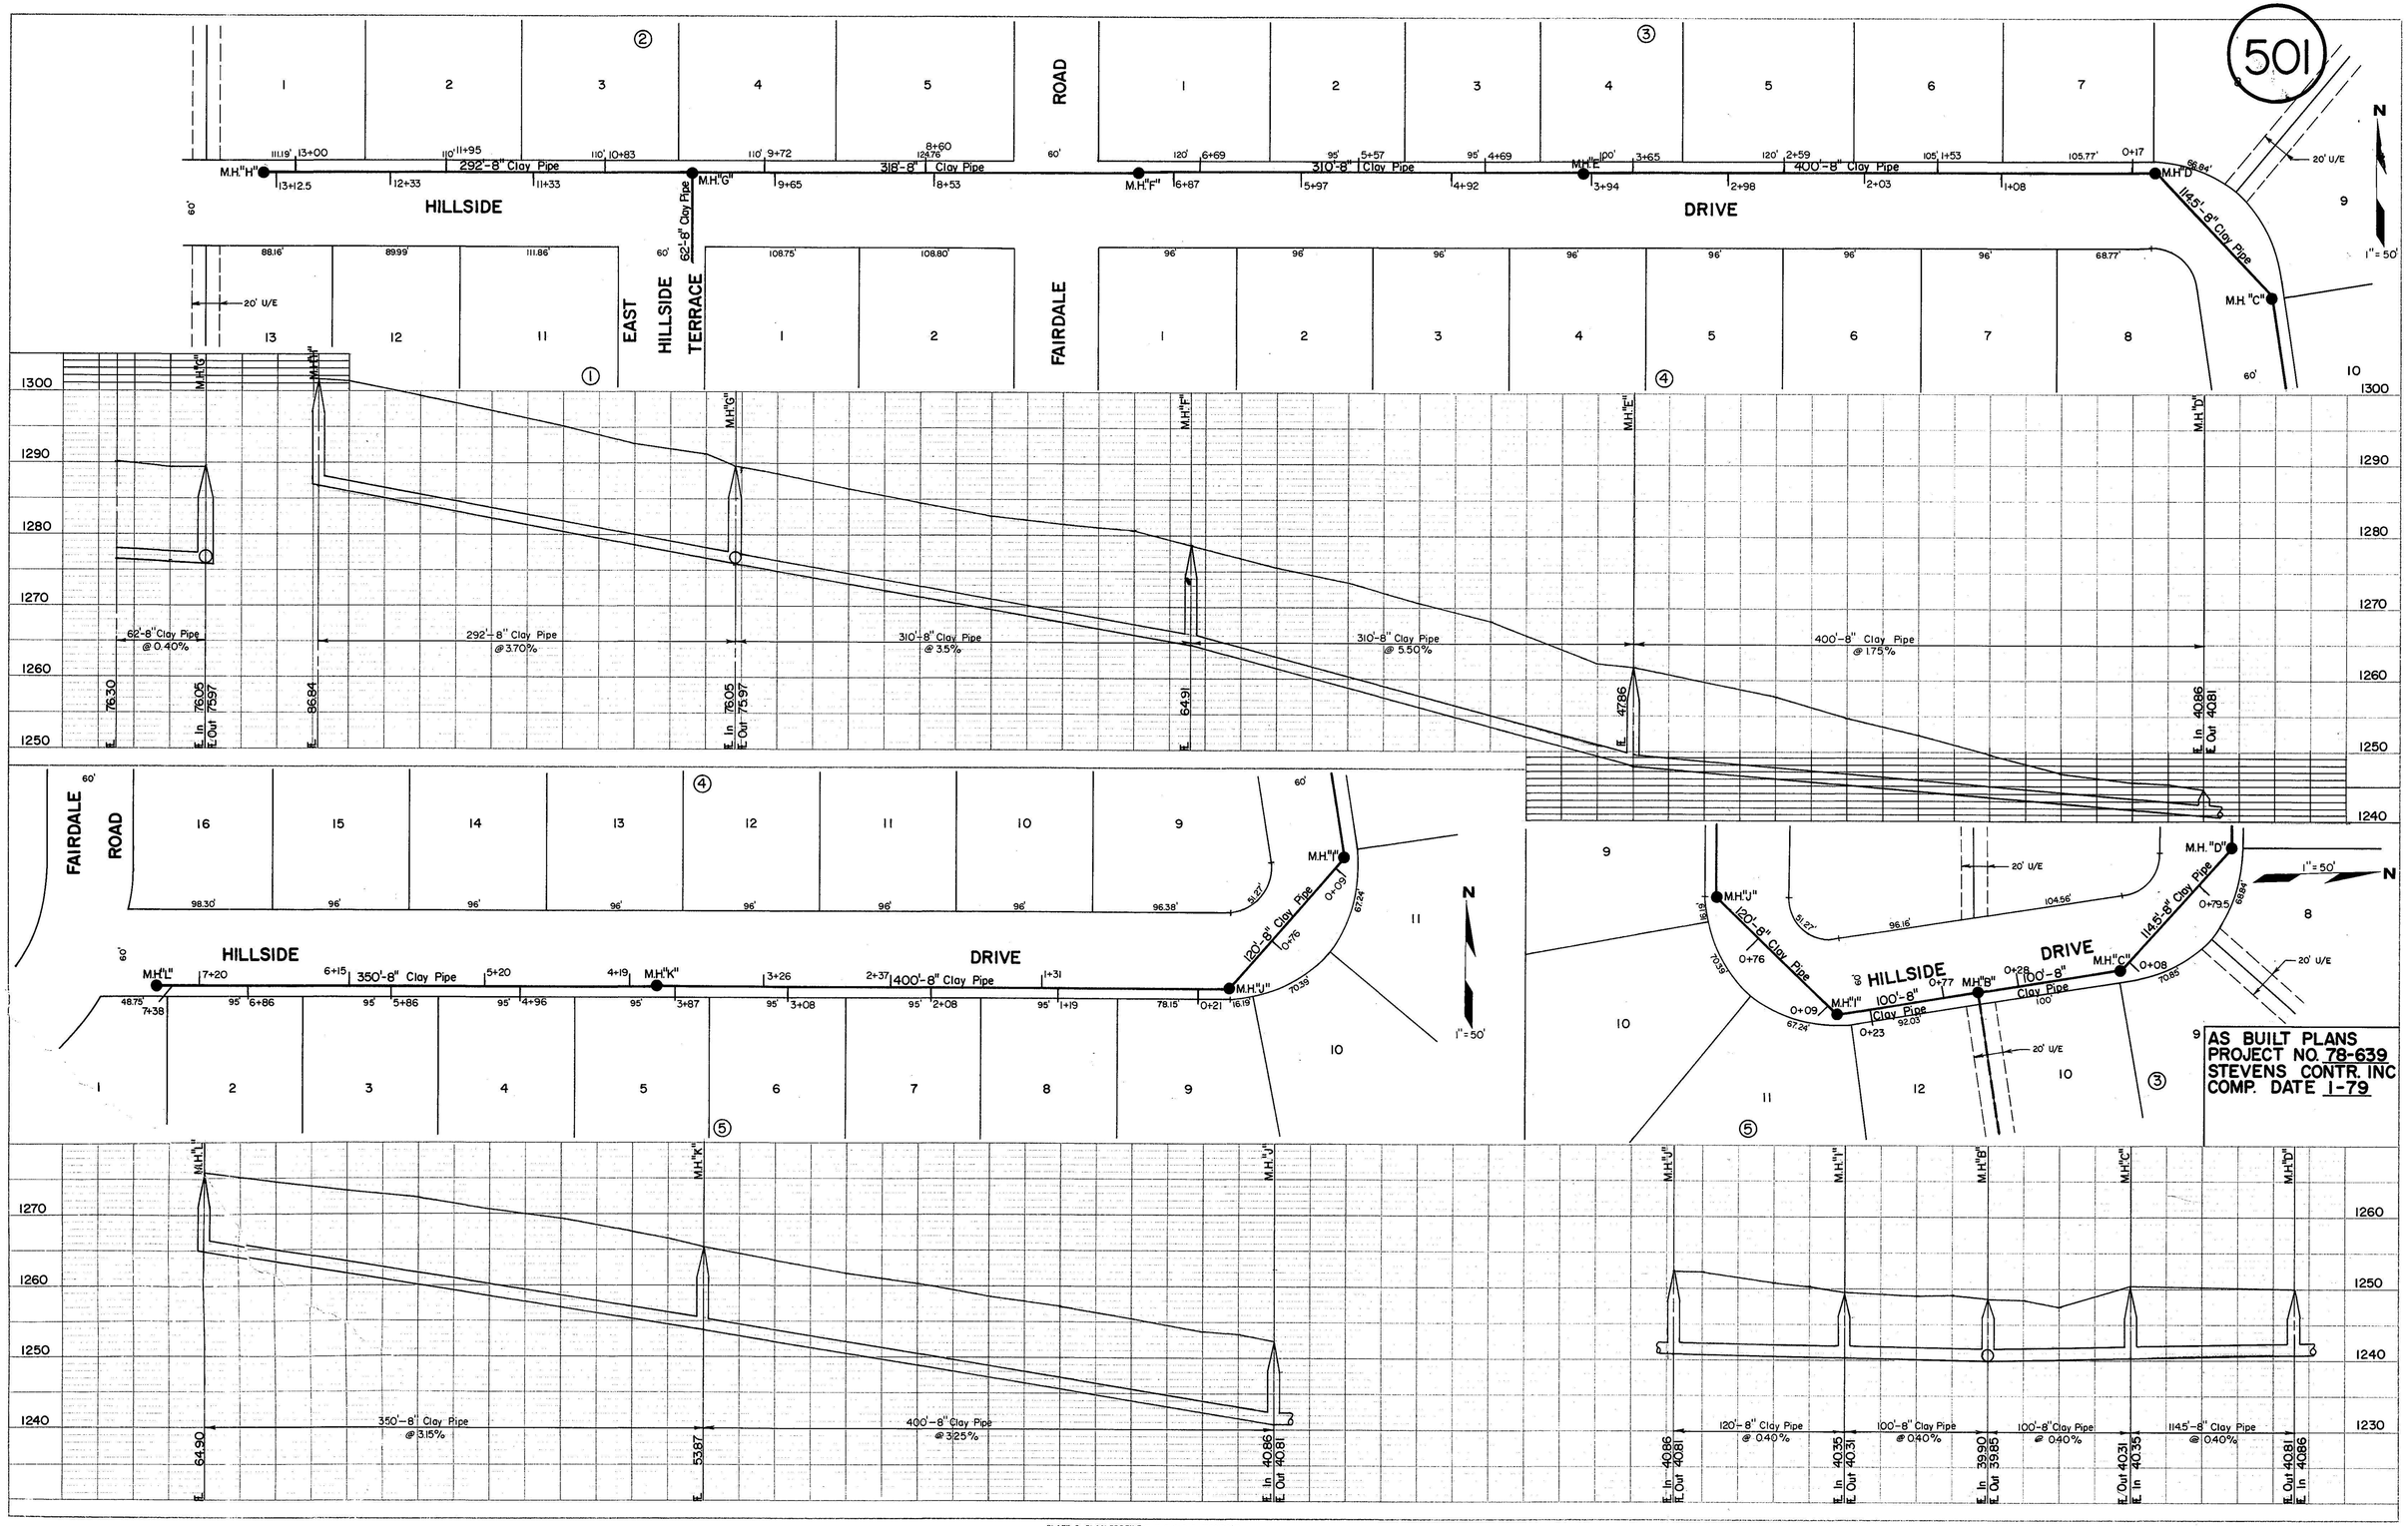

AS BUILT PLANS
PROJECT NO. 78-639
STEVENS CONTR. INC
COMP. DATE 1-79

PLATE 2 PLAN-PROFILE O. P. R. & R. E. STANDARD
100% RAG AGEPROOF VELLUM—MADE AND PRINTED IN U. S. A.
EUGENE DIETZGEN CO.