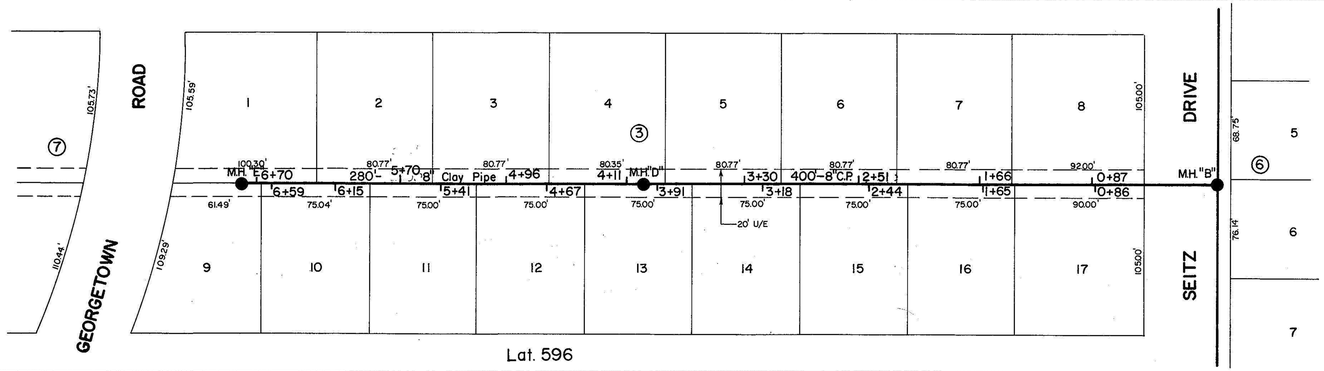

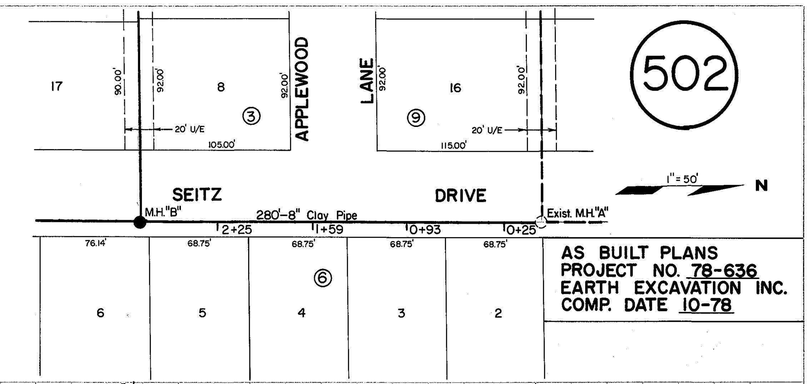

502

AS BUILT PLANS
PROJECT NO. 78-636
EARTH EXCAVATION INC.
COMP. DATE 10-78

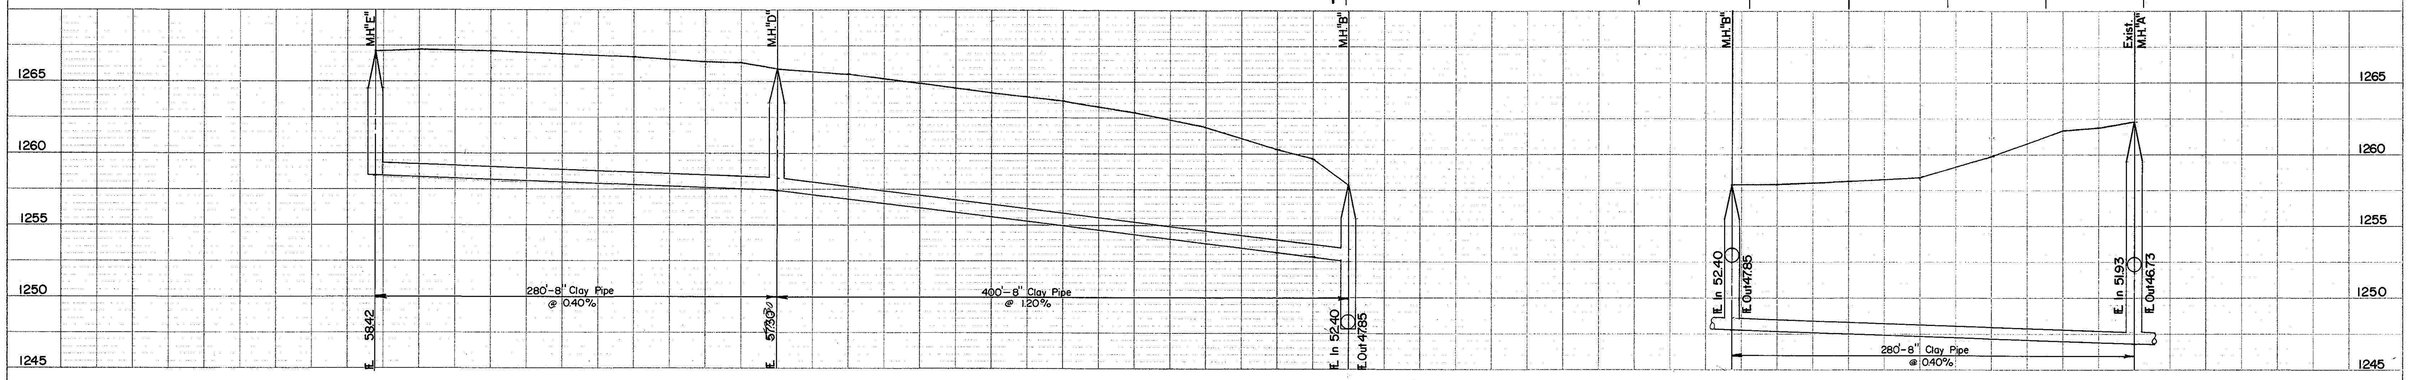

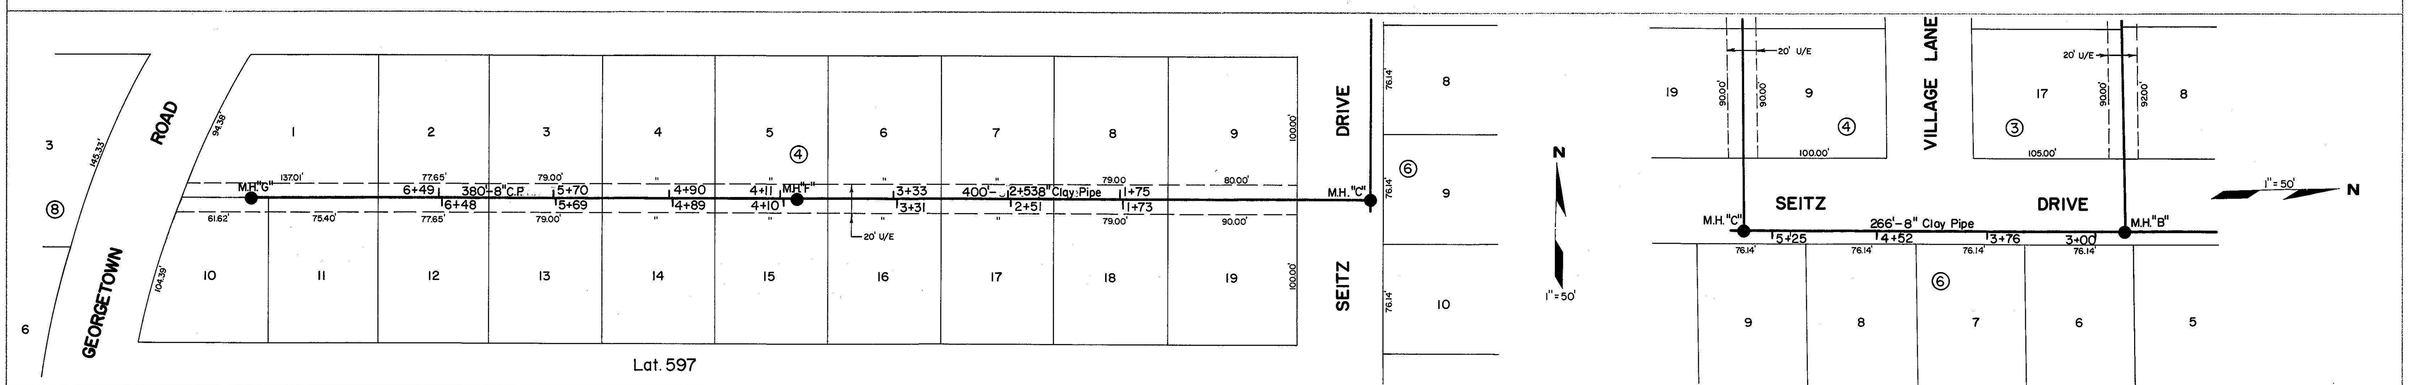

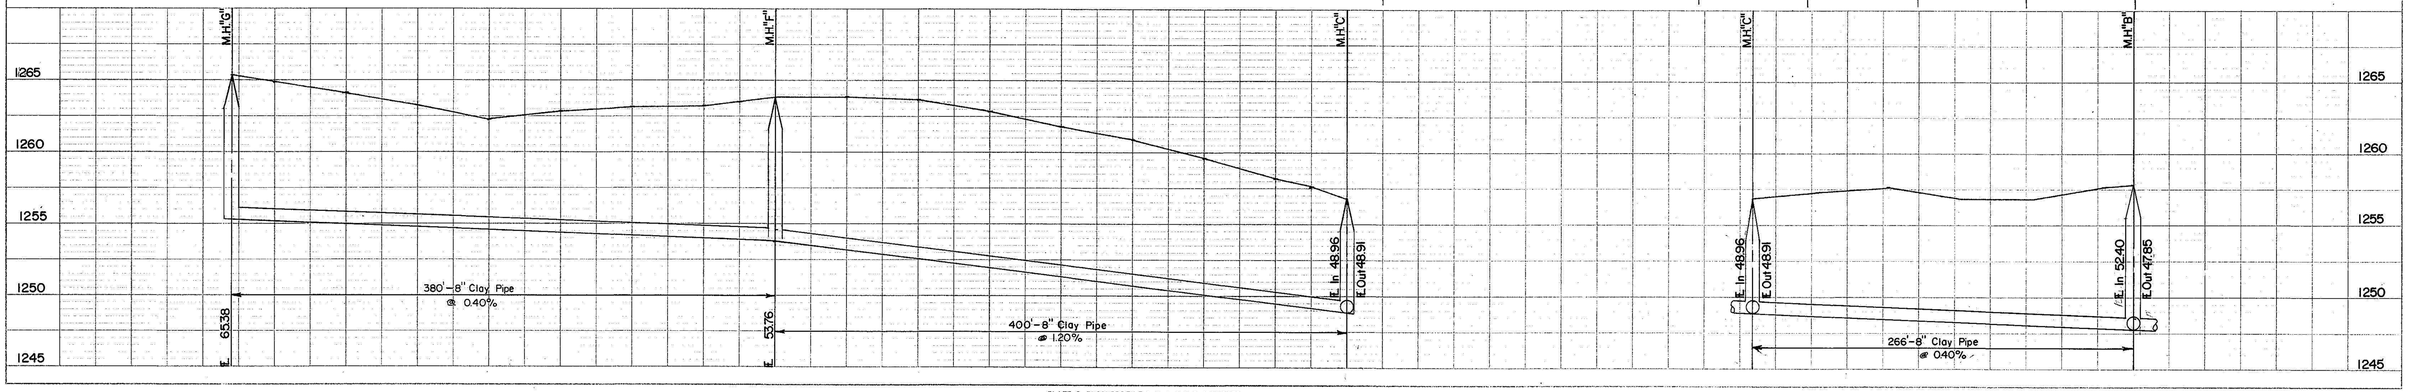

PLAN — SURVEYED, PLOTTED, NOTE BOOK, ALIGNMENT CHECKED, RT. OF WAY CHECKED, NO. — BY — DATE

PROFILE — SURVEYED, PLOTTED, NOTE BOOK, GRADES CHECKED, STRUCTURE NOTATIONS CHKD., NO. — BY — DATE

PLATE 2 PLAN-PROFILE O. P. R. & R. E. STANDARD
100% RAG ACEPROOF VELLUM—MADE AND PRINTED IN U. S. A.
EUGENE DIETZGEN CO.