503

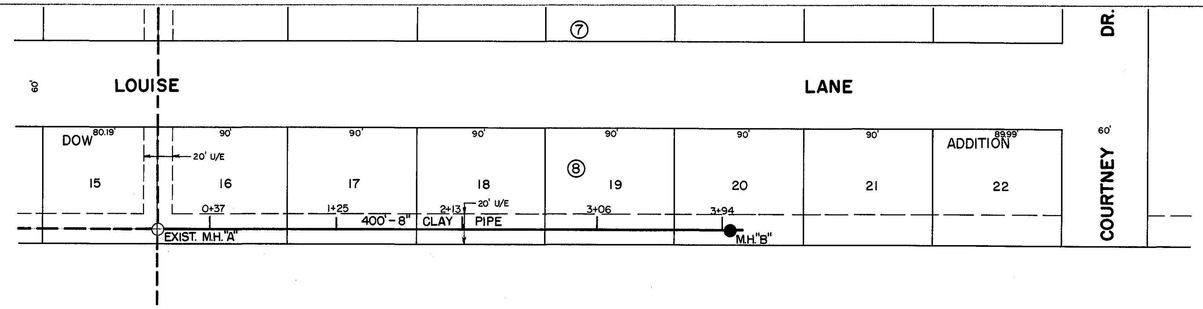

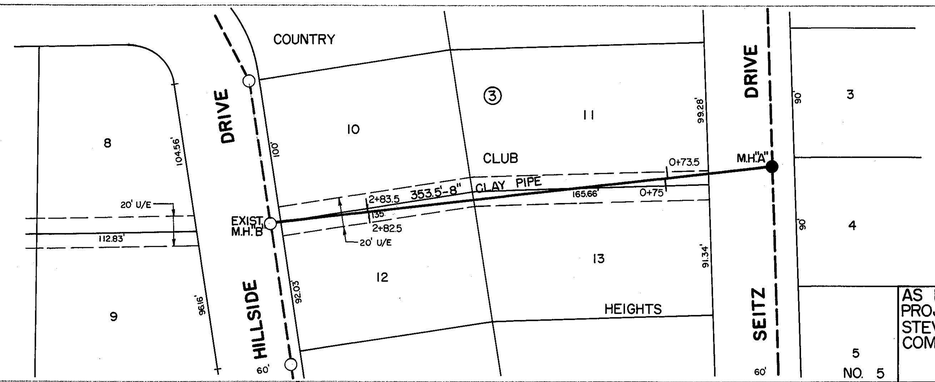

AS BUILT PLANS
PROJECT NO. 78-639
STEVENS CONSTR.
COMP. DATE 1-79

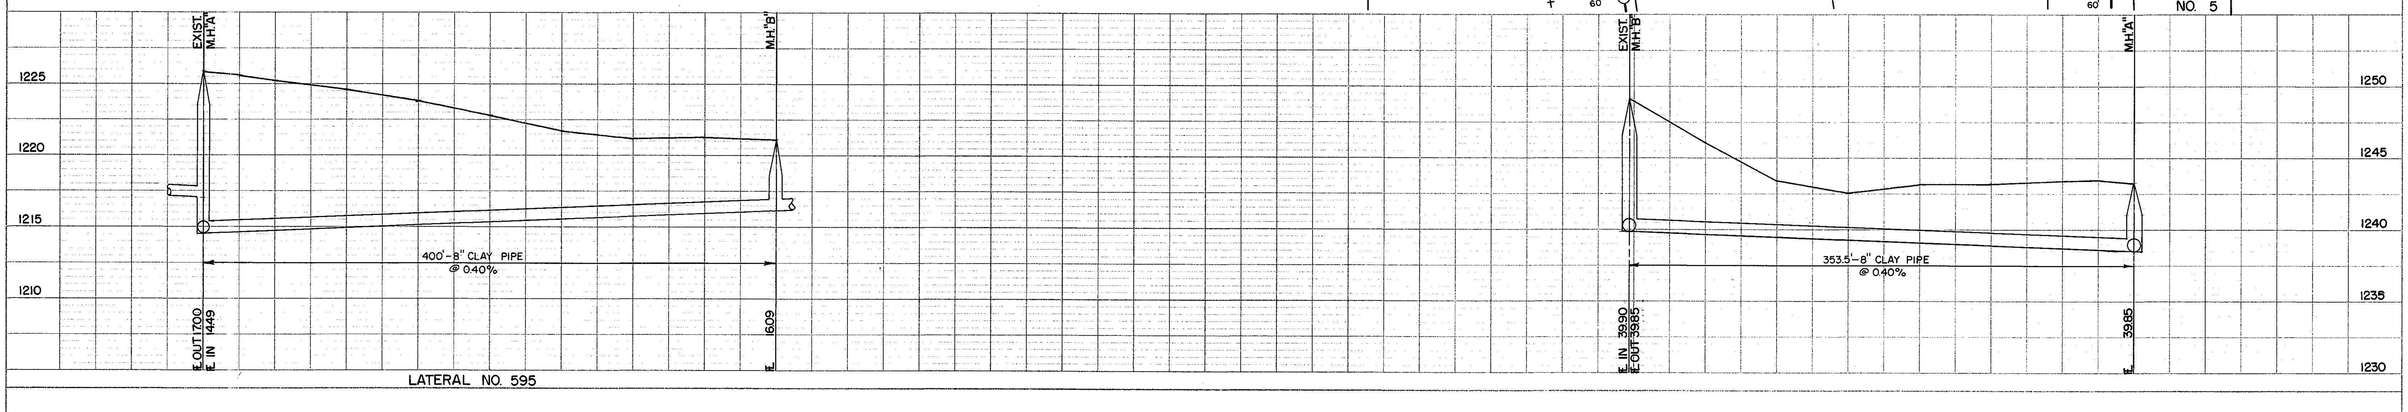

LATERAL NO. 595

PLAN
NOTE BOOK
NO.
SURVEYED
PLOTTED
ALIGNMENT CHECKED
RT. OF WAY CHECKED
BY
DATE

PROFILE
NOTE BOOK
NO.
SURVEYED
PLOTTED
GRADES CHECKED
B. Ms. NOTED
STRUCTURE NOTES CHKD.
BY
DATE

PLATE 2 PLAN-PROFILE O. P. R. & R. E. STANDARD
100% RAG ACCEPROOF VELLUM—MADE AND PRINTED IN U. S. A.
EUGENE DIETZGEN CO.