505

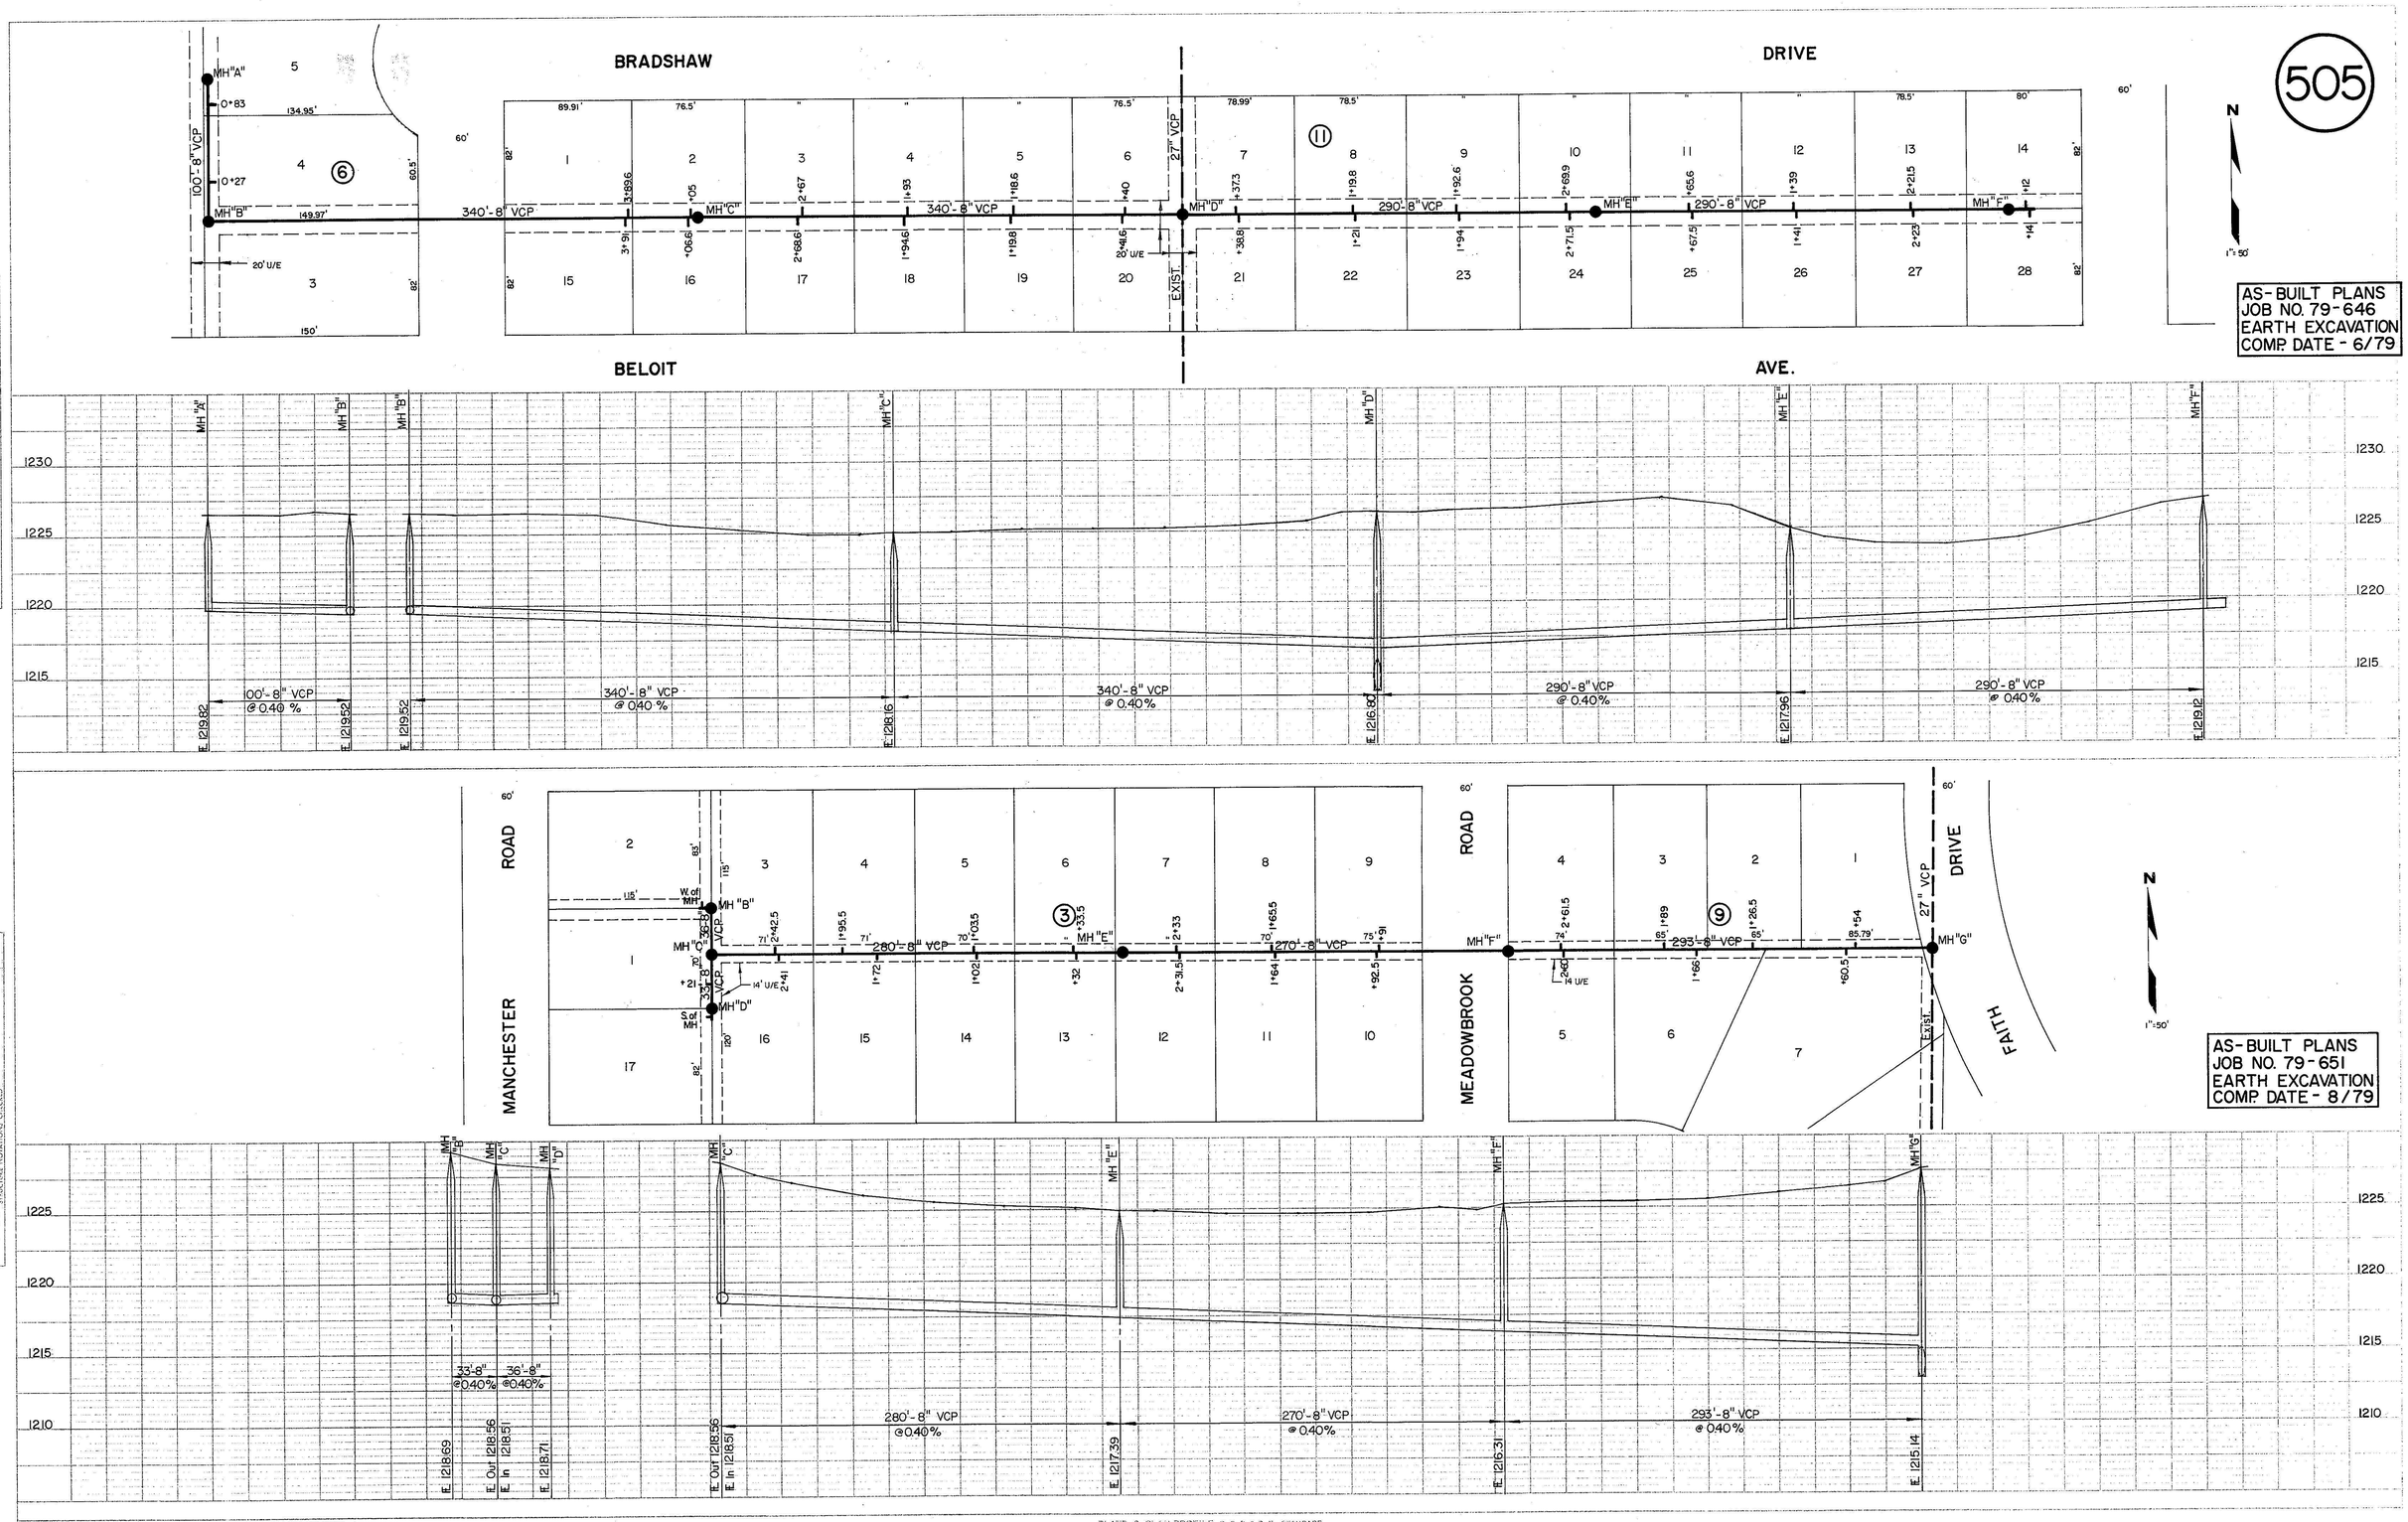

PLAN PROFILE
SURVEYED
PLOTTED
COORD. CHECKED
NOTE BOOK
ALIGNMENT CHECKED
ST. OF WAY CHECKED
No.
DATE
BY

PLATE 2—PLAN PROFILE O. P. R. & R. C. STANDARD
100% RAG — MADE AND PRINTED IN U. S. A.
NATIONAL TRACING PAPER DIVISION
I. E. A. CO., INC. INDIANAPOLIS, INDIANA