506

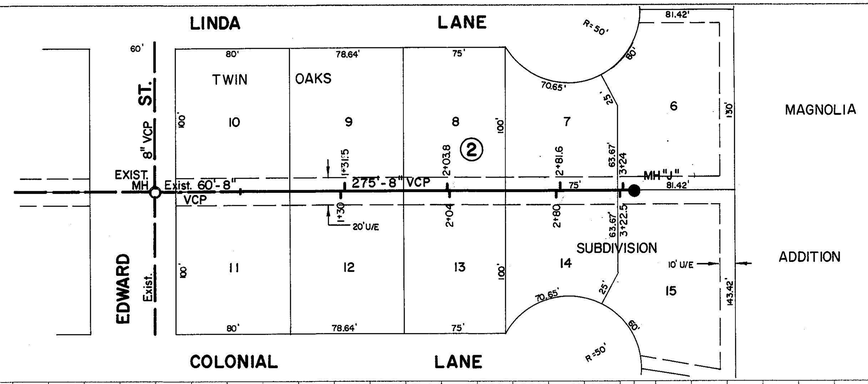

AS-BUILT PLANS
JOB NO. 79-646
EARTH EXCAVATION
COMP. DATE-6/79

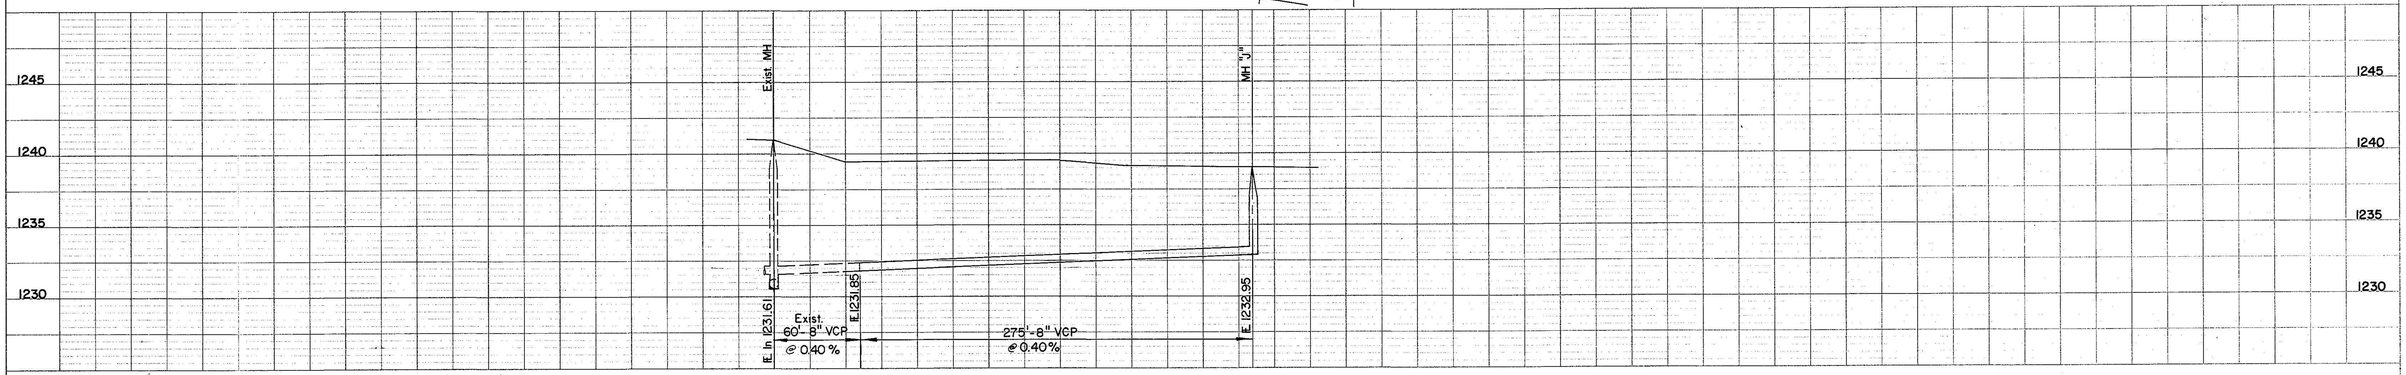

PLAN		BY	DATE
NOTE BOOK NO.	SURVEYED		
	PLOTTED		
	ALIGNMENT CHECKED		
	VERT. DIM. CHECKED		

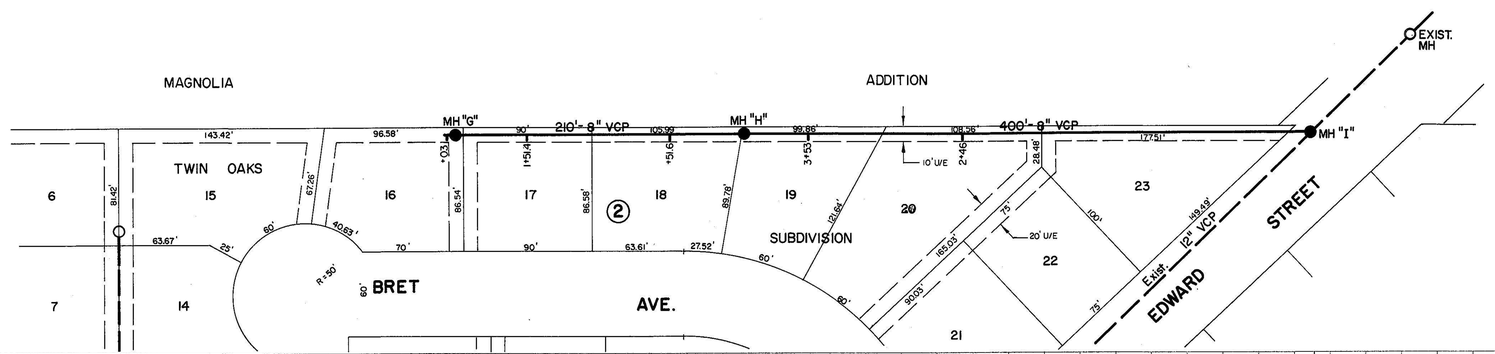

AS-BUILT PLANS
JOB NO. 79-646
EARTH EXCAVATION
COMP. DATE-6/79

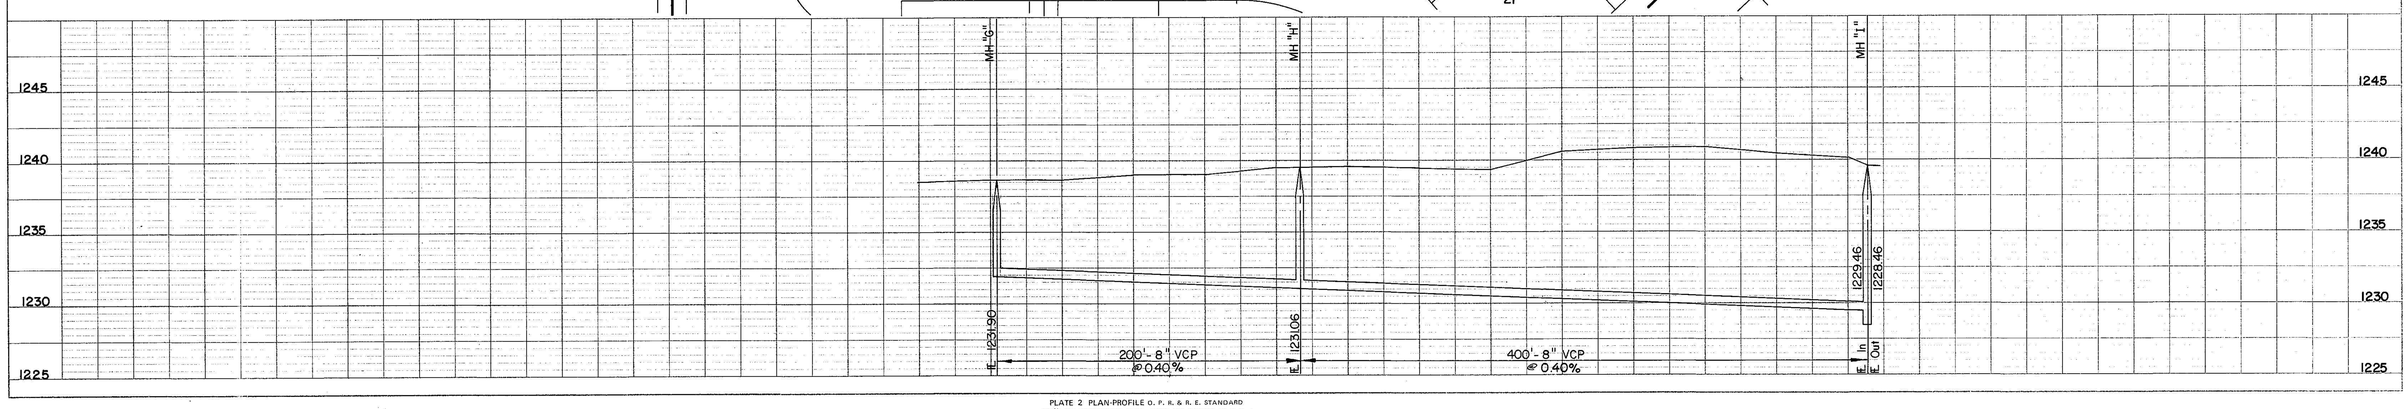

PROFILE		BY	DATE
NOTE BOOK NO.	SURVEYED		
	PLOTTED		
	GRADES CHECKED		
	B.M. & ELEVATIONS		
	STRUCTURE NOTA NS CH'KD		