507

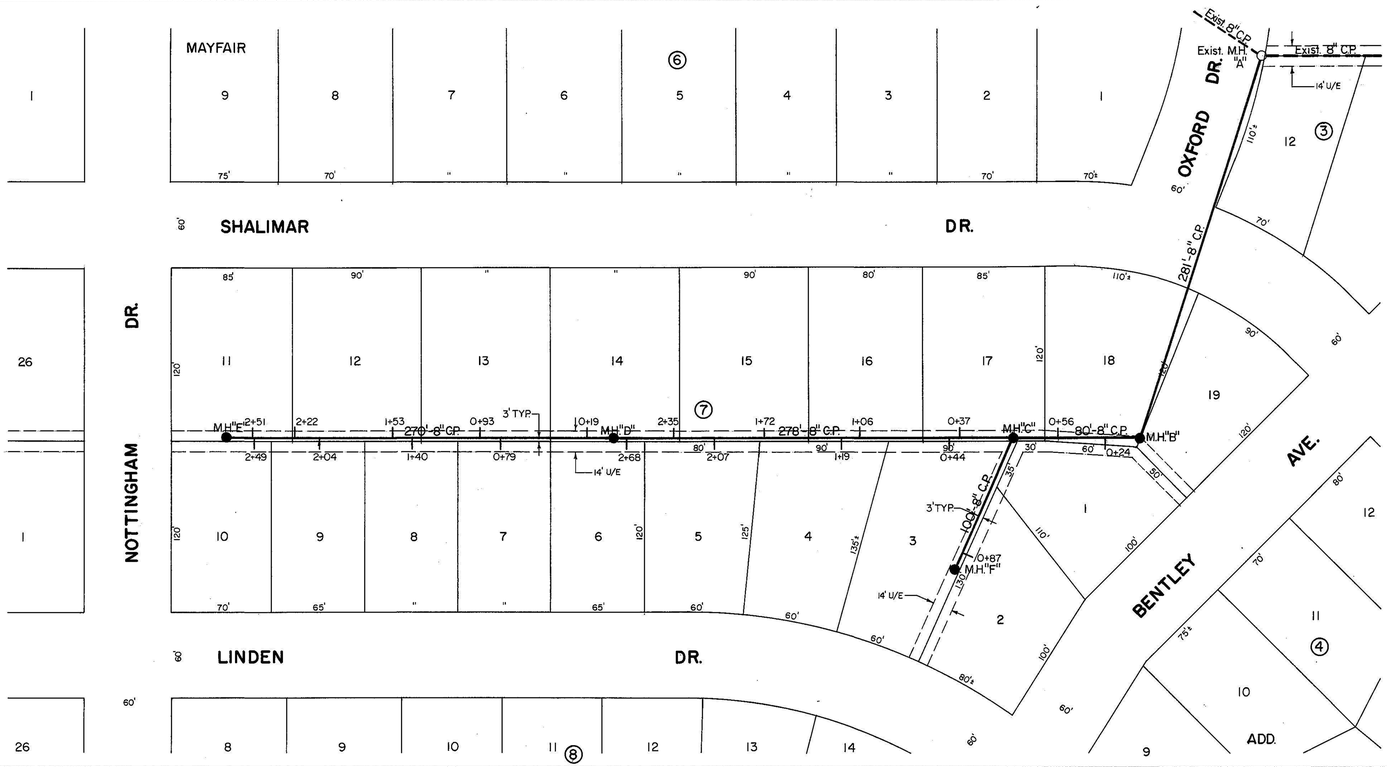

AS-BUILT PLANS
JOB NO. 79-642
UMSCHEID TRENCHING
COMP. DATE 8-79

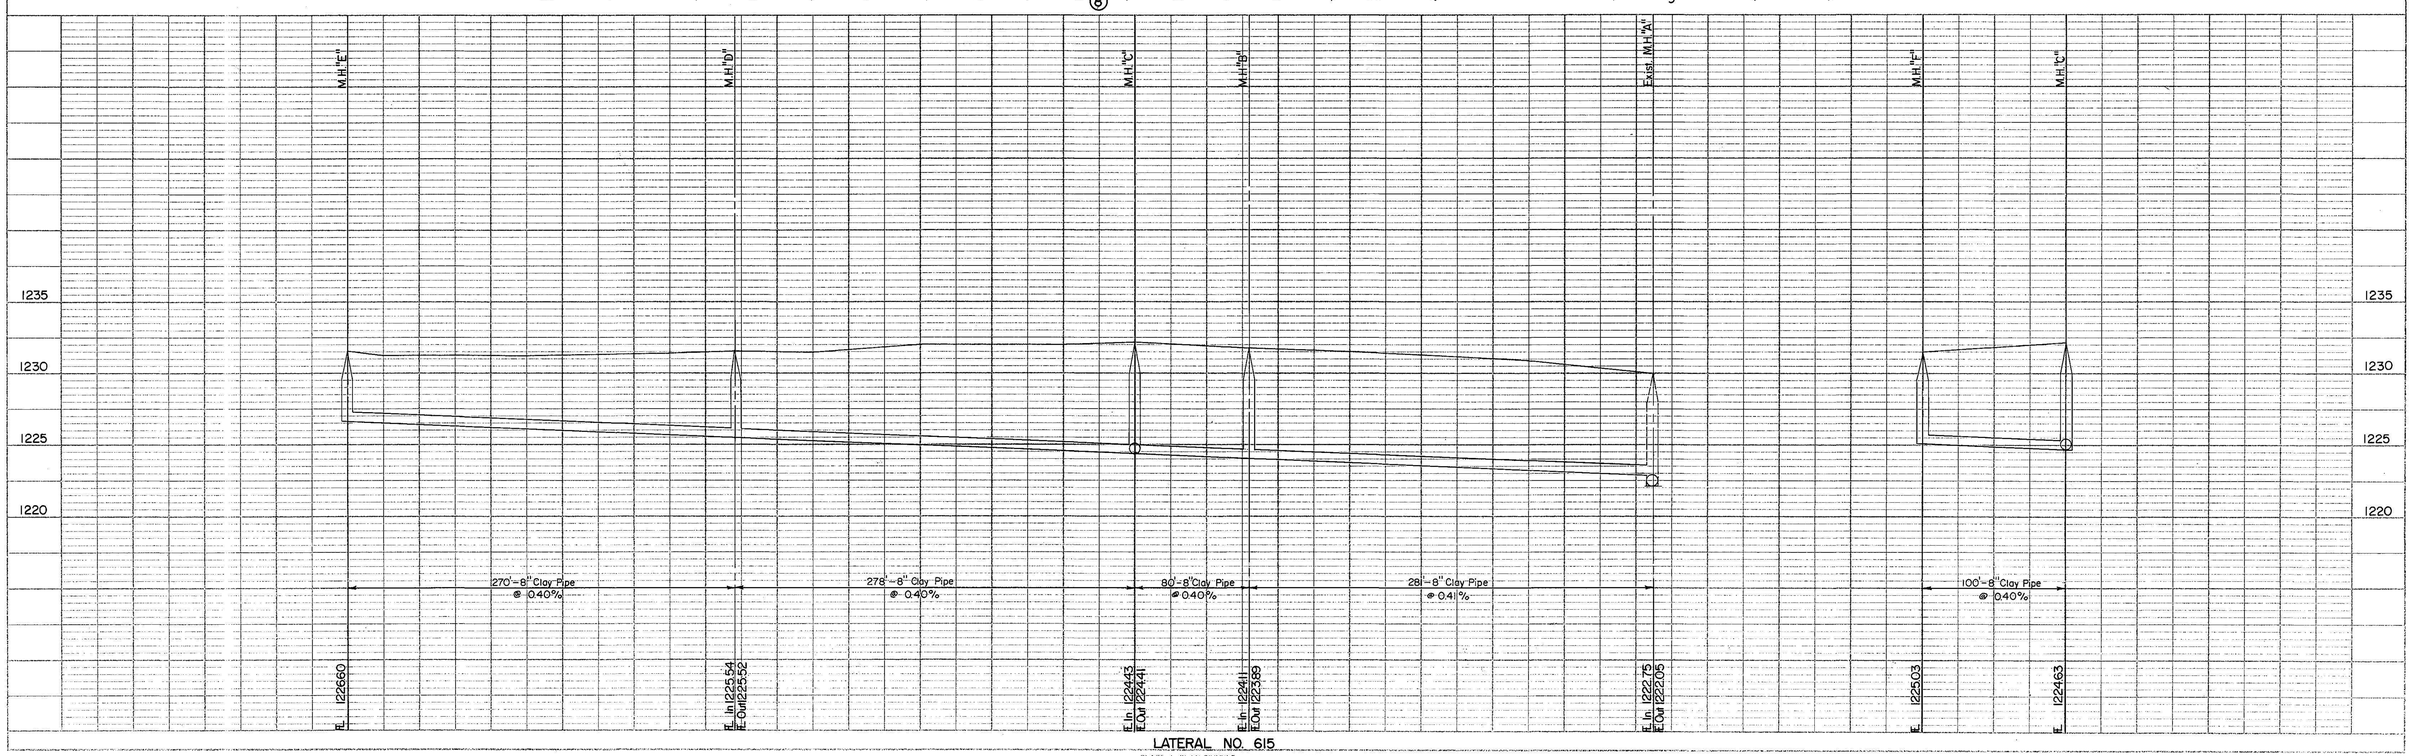

LATERAL NO. 615

PLAN
SURVEYED
PLOTTED
ALIGNMENT CHECKED
RT. OF WAY CHECKED
NOTE BOOK
NO.
BY
DATE

PROFILE
SURVEYED
PLOTTED
GRADES CHECKED
BY
STRUCTURE NOTATNS CH'KD.
NOTE BOOK
NO.
BY
DATE

PLATE 1 PLAN-PROFILE D. P. R. & R. E. STANDARD
100% RAG PAPER—MADE AND PRINTED IN U.S.A.
LITHO IN. DIETZGEN CO.