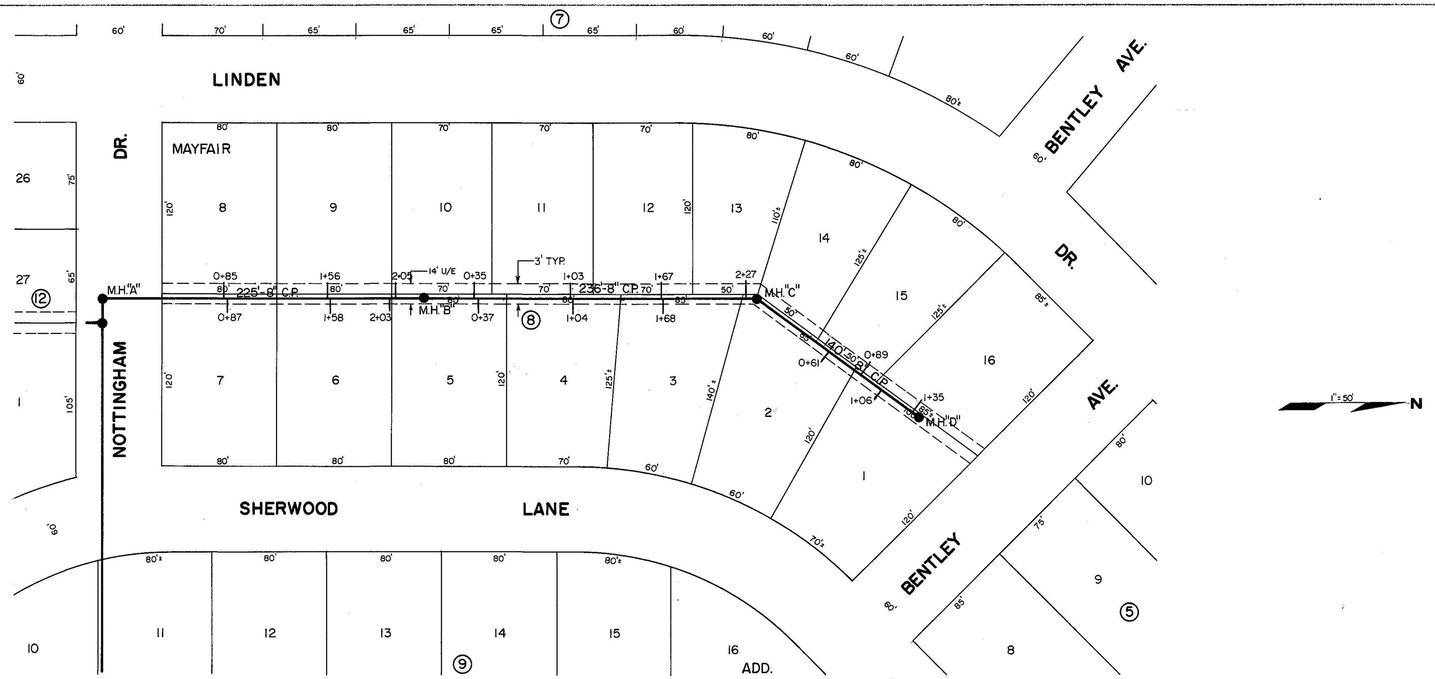

508

AS-BUILT PLANS
JOB NO. 79-642
UMSCHEID TRENCHING
COMP. DATE 8-79

PLAN
NOTE BOOK
NO.
SURVEYED
PLOTTED
ALIGNMENT CHECKED
R/W OR EASEMENT CHECKED
BY
DATE

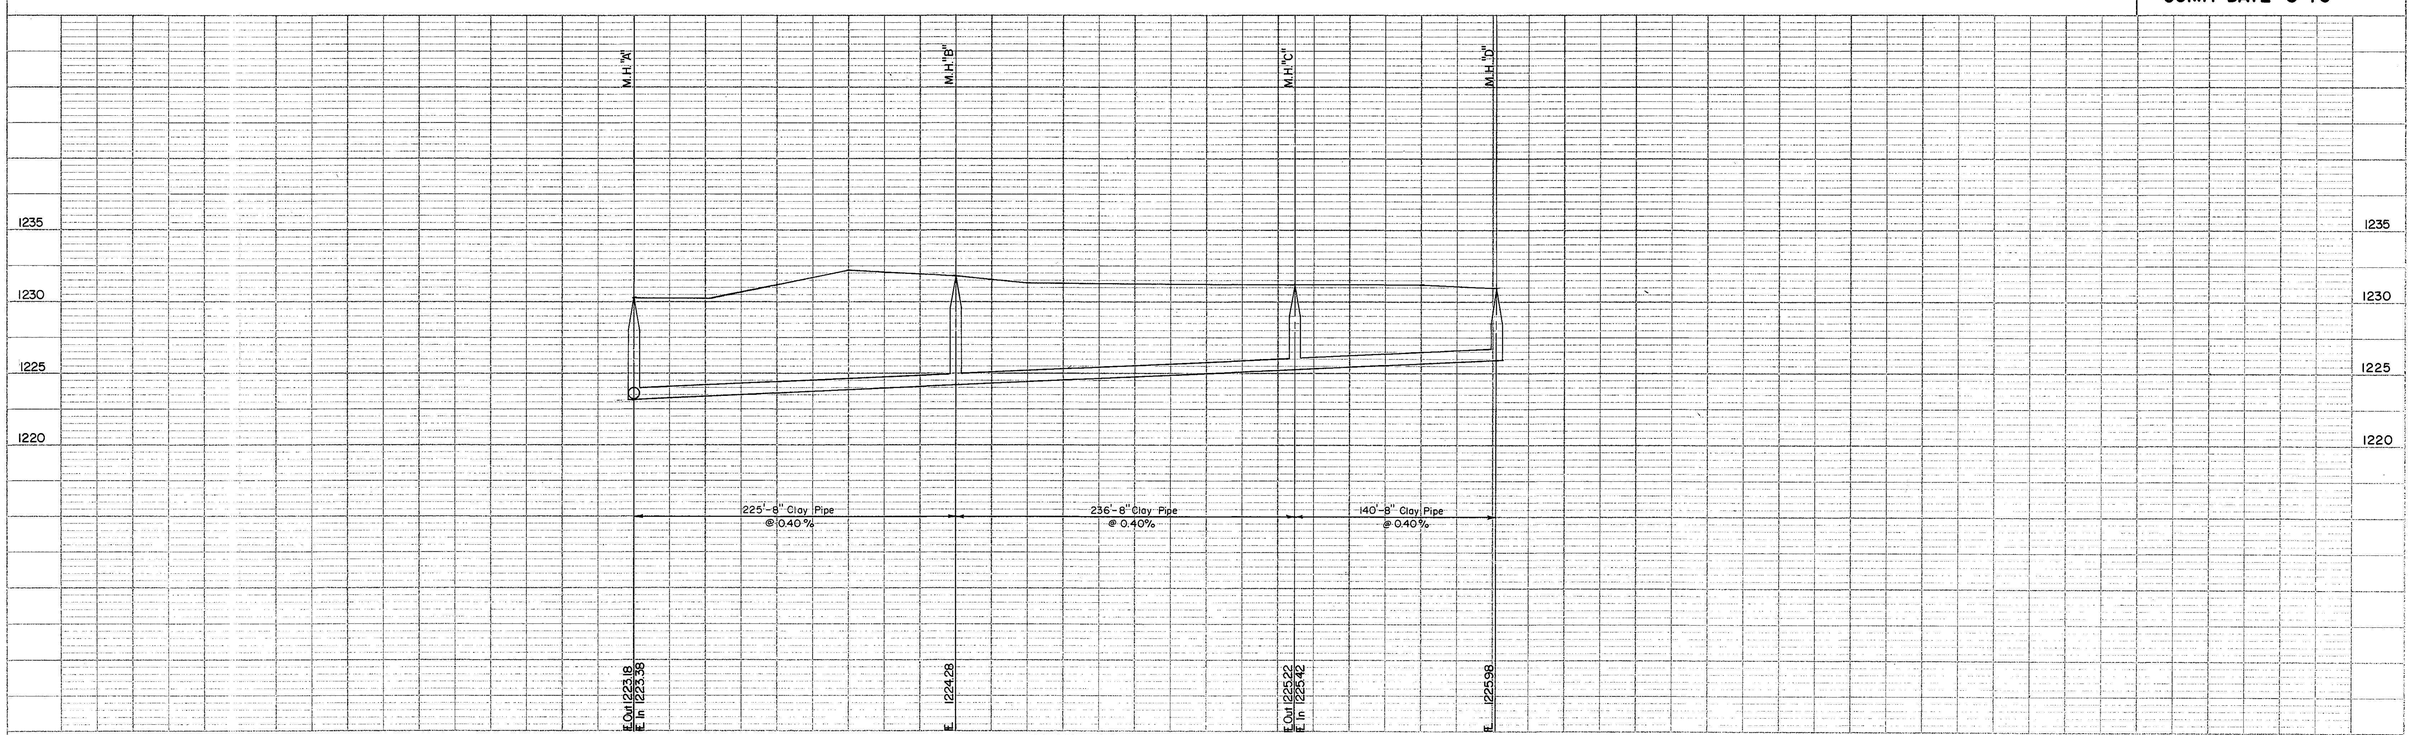

LATERAL NO. 616

PROFILE
NOTE BOOK
NO.
SURVEYED
PLOTTED
HORIZ. & VERT. CHECKED
R. W. & EASE.
STRUCTURE NOTATIONS CHKD.
BY
DATE

PLATE 1 PLAN-PROFILE O. P. R. & R. L. STANDARD
100% RAG PAPER—MADE AND PRINTED IN U.S.A.
EUGENE DIETZGEN CO.