509

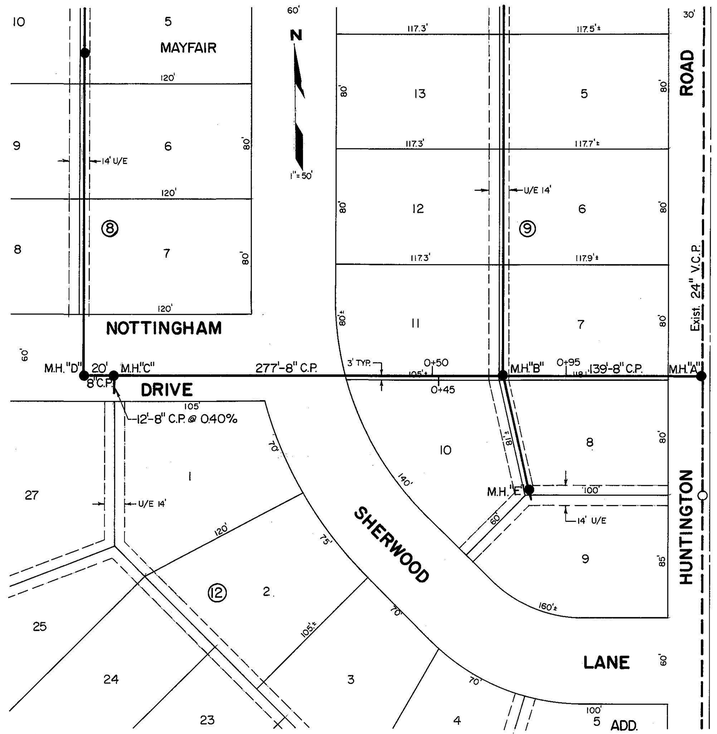

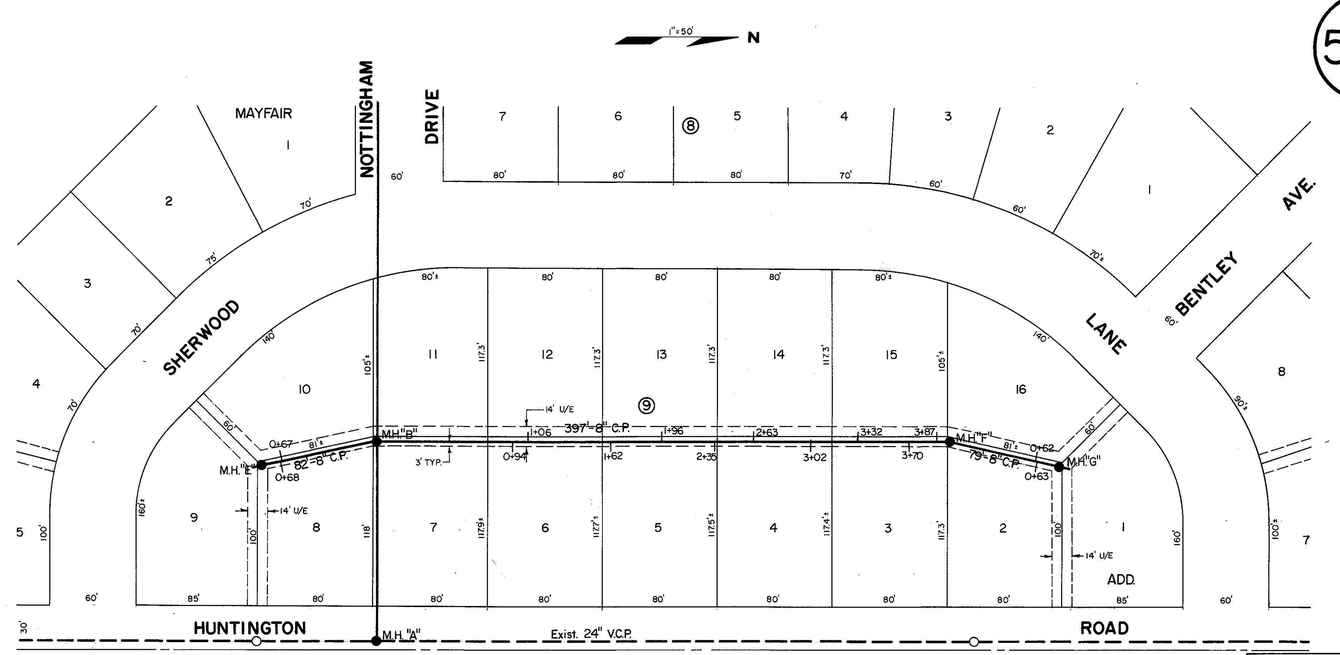

AS-BUILT PLANS
JOB NO. 79-642
UMSCHEID TRENCHING
COMP. DATE 8-79

PLAN
SURVEYED
PLOTTED
ALIGNMENT CHECKED
RT. OF WAY CHECKED
NOTE BOOK
NO.
BY
DATE

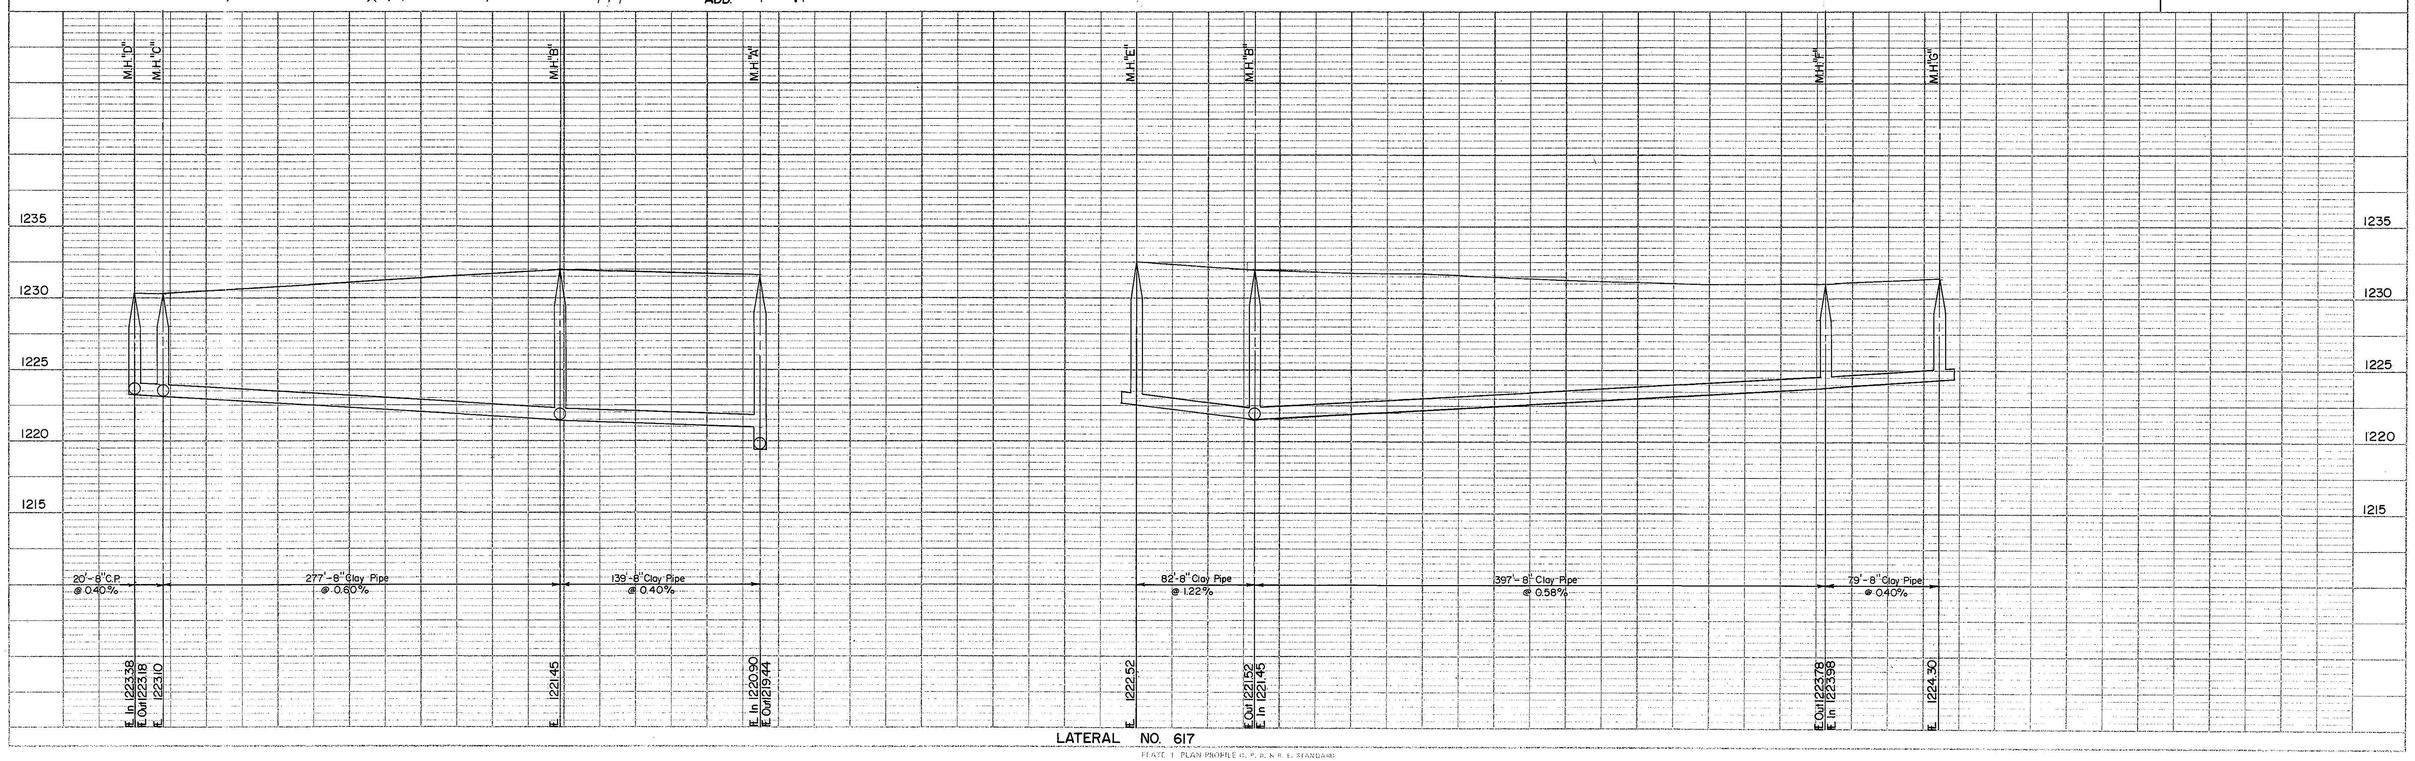

PROFILE
SURVEYED
PLOTTED
GRADES CHECKED
O. M. NOTED
STRUCTURE NOTES CHECKED
NOTE BOOK
NO.
BY
DATE

LATERAL NO. 617

PLATE 1 PLAN PROFILE C. F. & I. STANDARD
100 EXCELSIOR MADE AND PRINTED IN U.S.A.
EUGENE DIETZGEN CO.