510

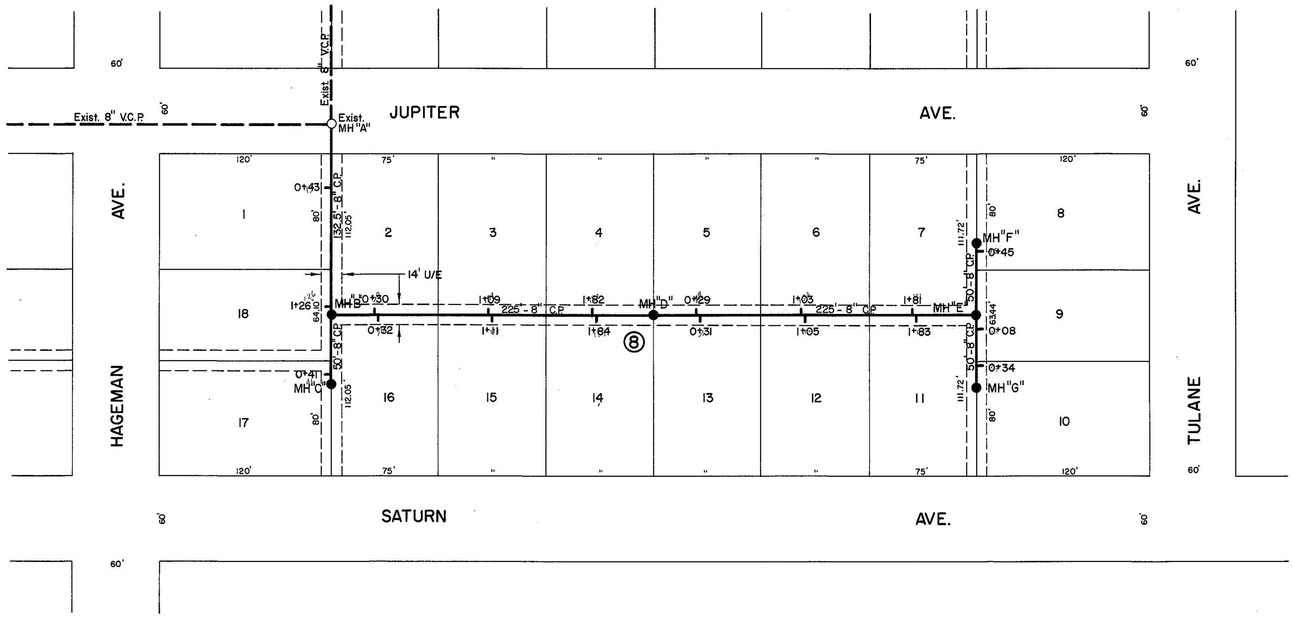

N

1" = 50'

AS-BUILT PLANS
JOB NO. 79-652
STEVENS CONTRACTORS
COMP. DATE - AUG. 1979

LATERAL NO. 610

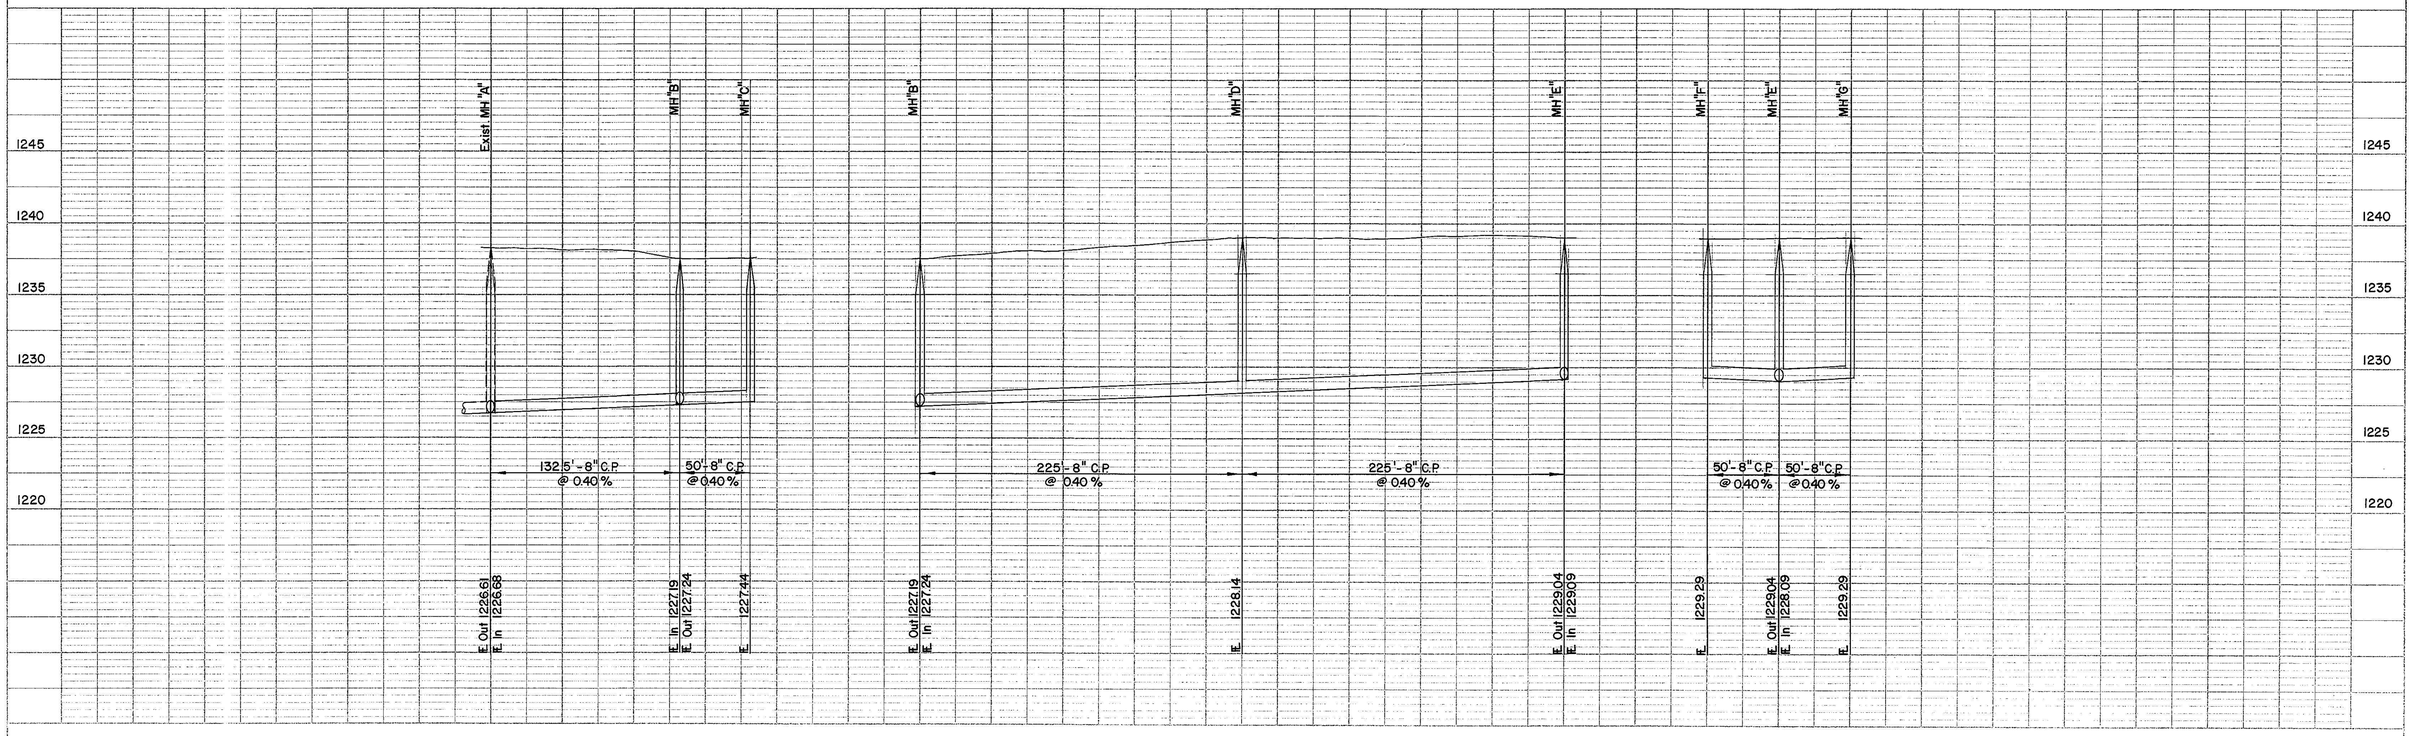

PLAN | SURVEYED | PLOTTED | ALIGNMENT CHECKED | ST. OF PAT CHECKED | NOTE BOOK | NO. | BY | DATE

PROFILE | SURVEYED | PLOTTED | GRADES CHECKED | PROFILE CHECKED | STRUCTURE NOTATIONS CH'KD. | NOTE BOOK | NO. | BY | DATE

PLATE 1 PLAN PROFILE S.A.N.S.G.E.I. STANDARD
100 RAG PAPER - MADE AND PRINTED IN U.S.A.
EUGENE DIETZGEN CO.