511

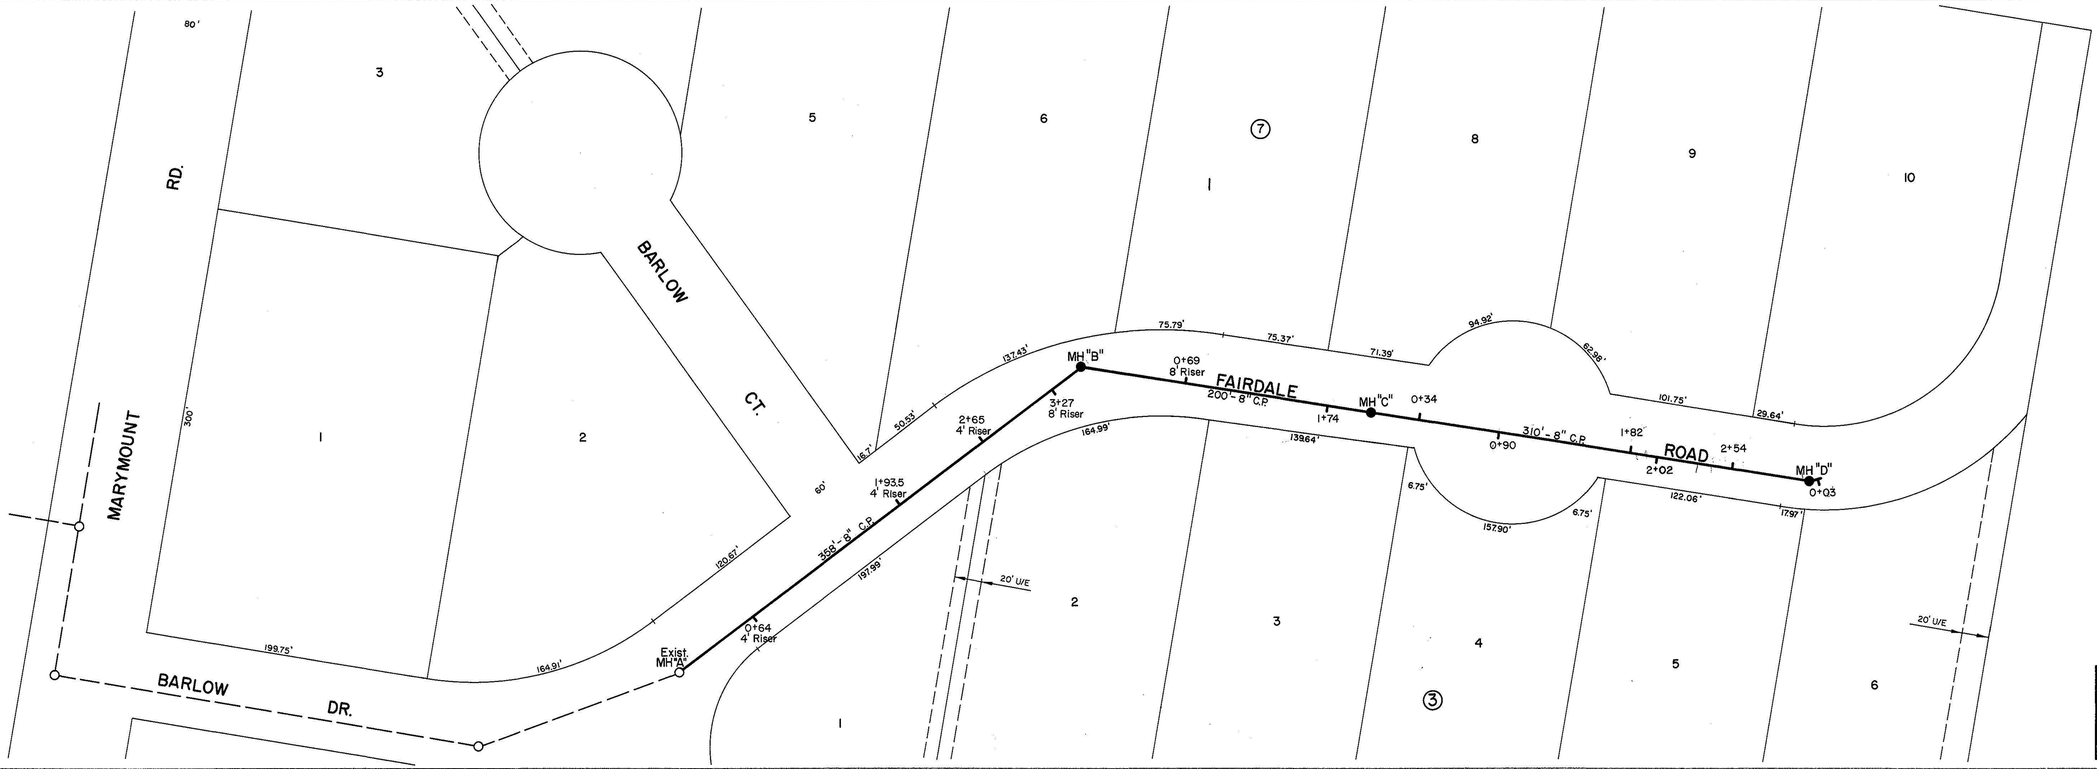

AS-BUILT PLANS
JOB NO. 79-652
STEVENS CONTR.
COMP. DATE, 8-79

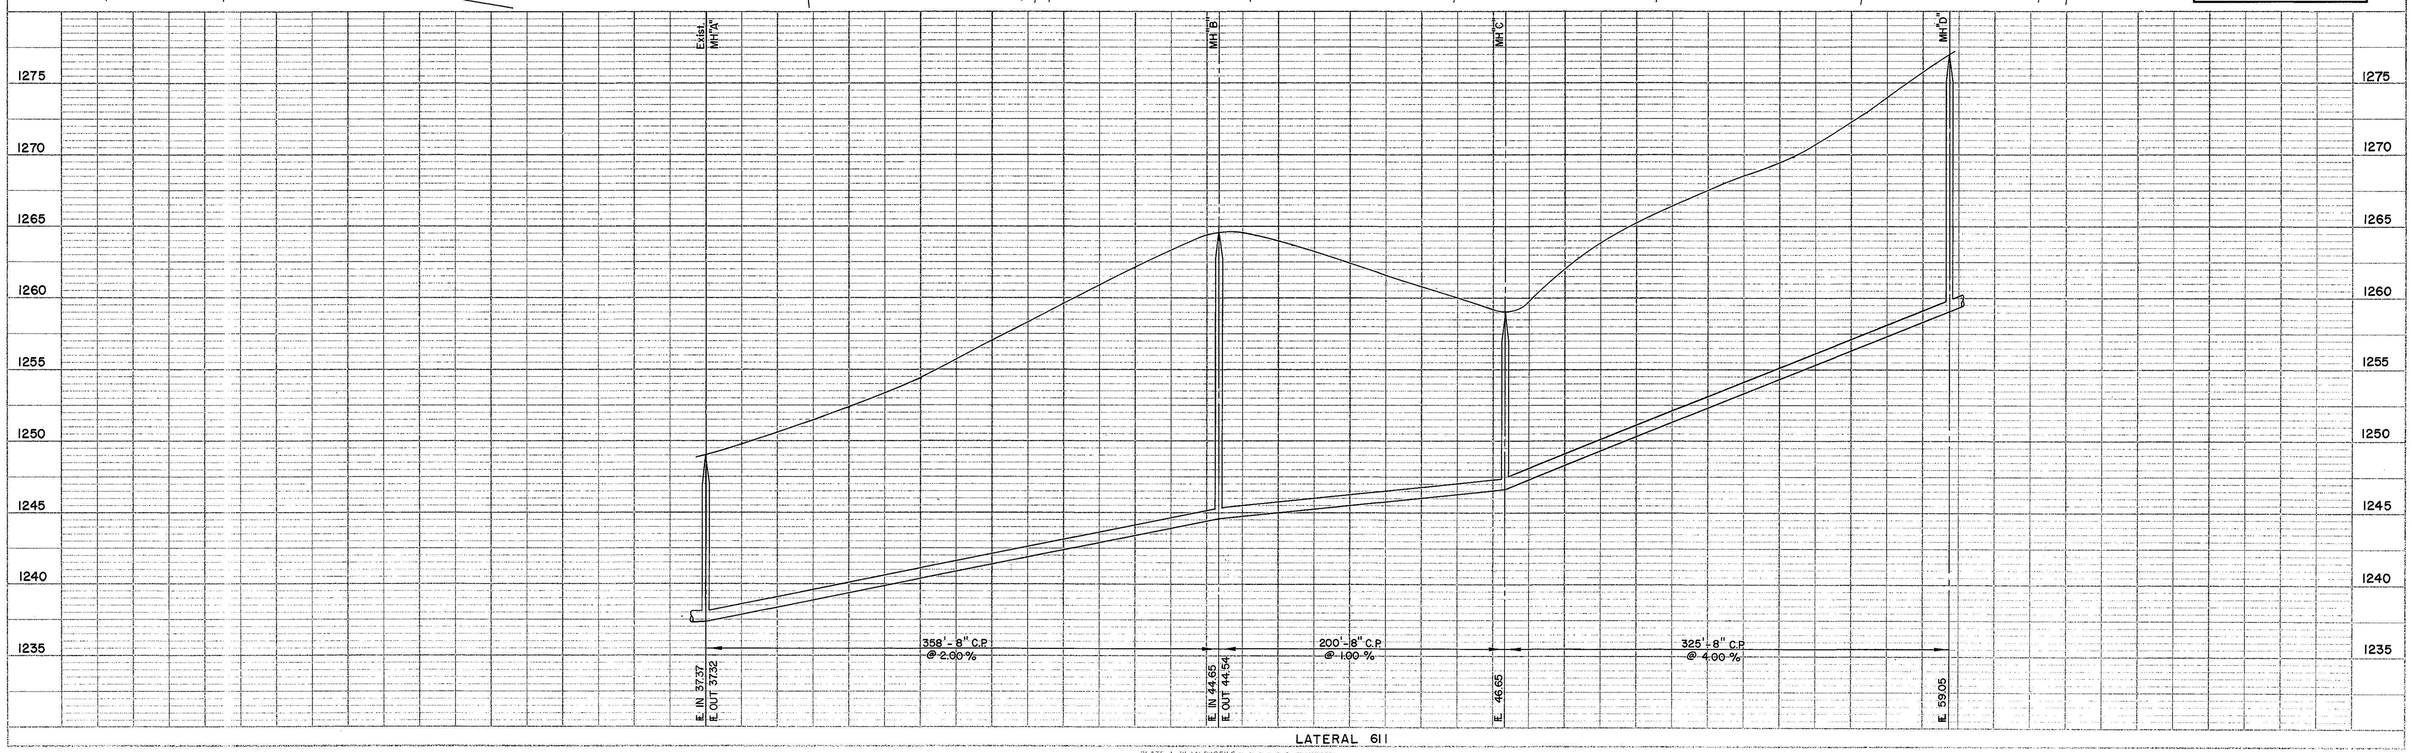

LATERAL 611

PLAN
NOTE BOOK
NO.
SURVEYED
PLOTTED
ALIGNMENT CHECKED
RT. OF WAY CHECKED
BY
DATE

PROFILE
NOTE BOOK
NO.
SURVEYED
PLOTTED
GRADES CHECKED
R/W & UTILITIES
STRUCTURE NOTATIONS CH'KD.
BY
DATE

PLATE 1 PLAN-PROFILE U. P. K. & R. E. STANDARD
100 RAG PAPER - MADE AND PRINTED IN U.S.A.
EUGENE DIETZGEN CO.