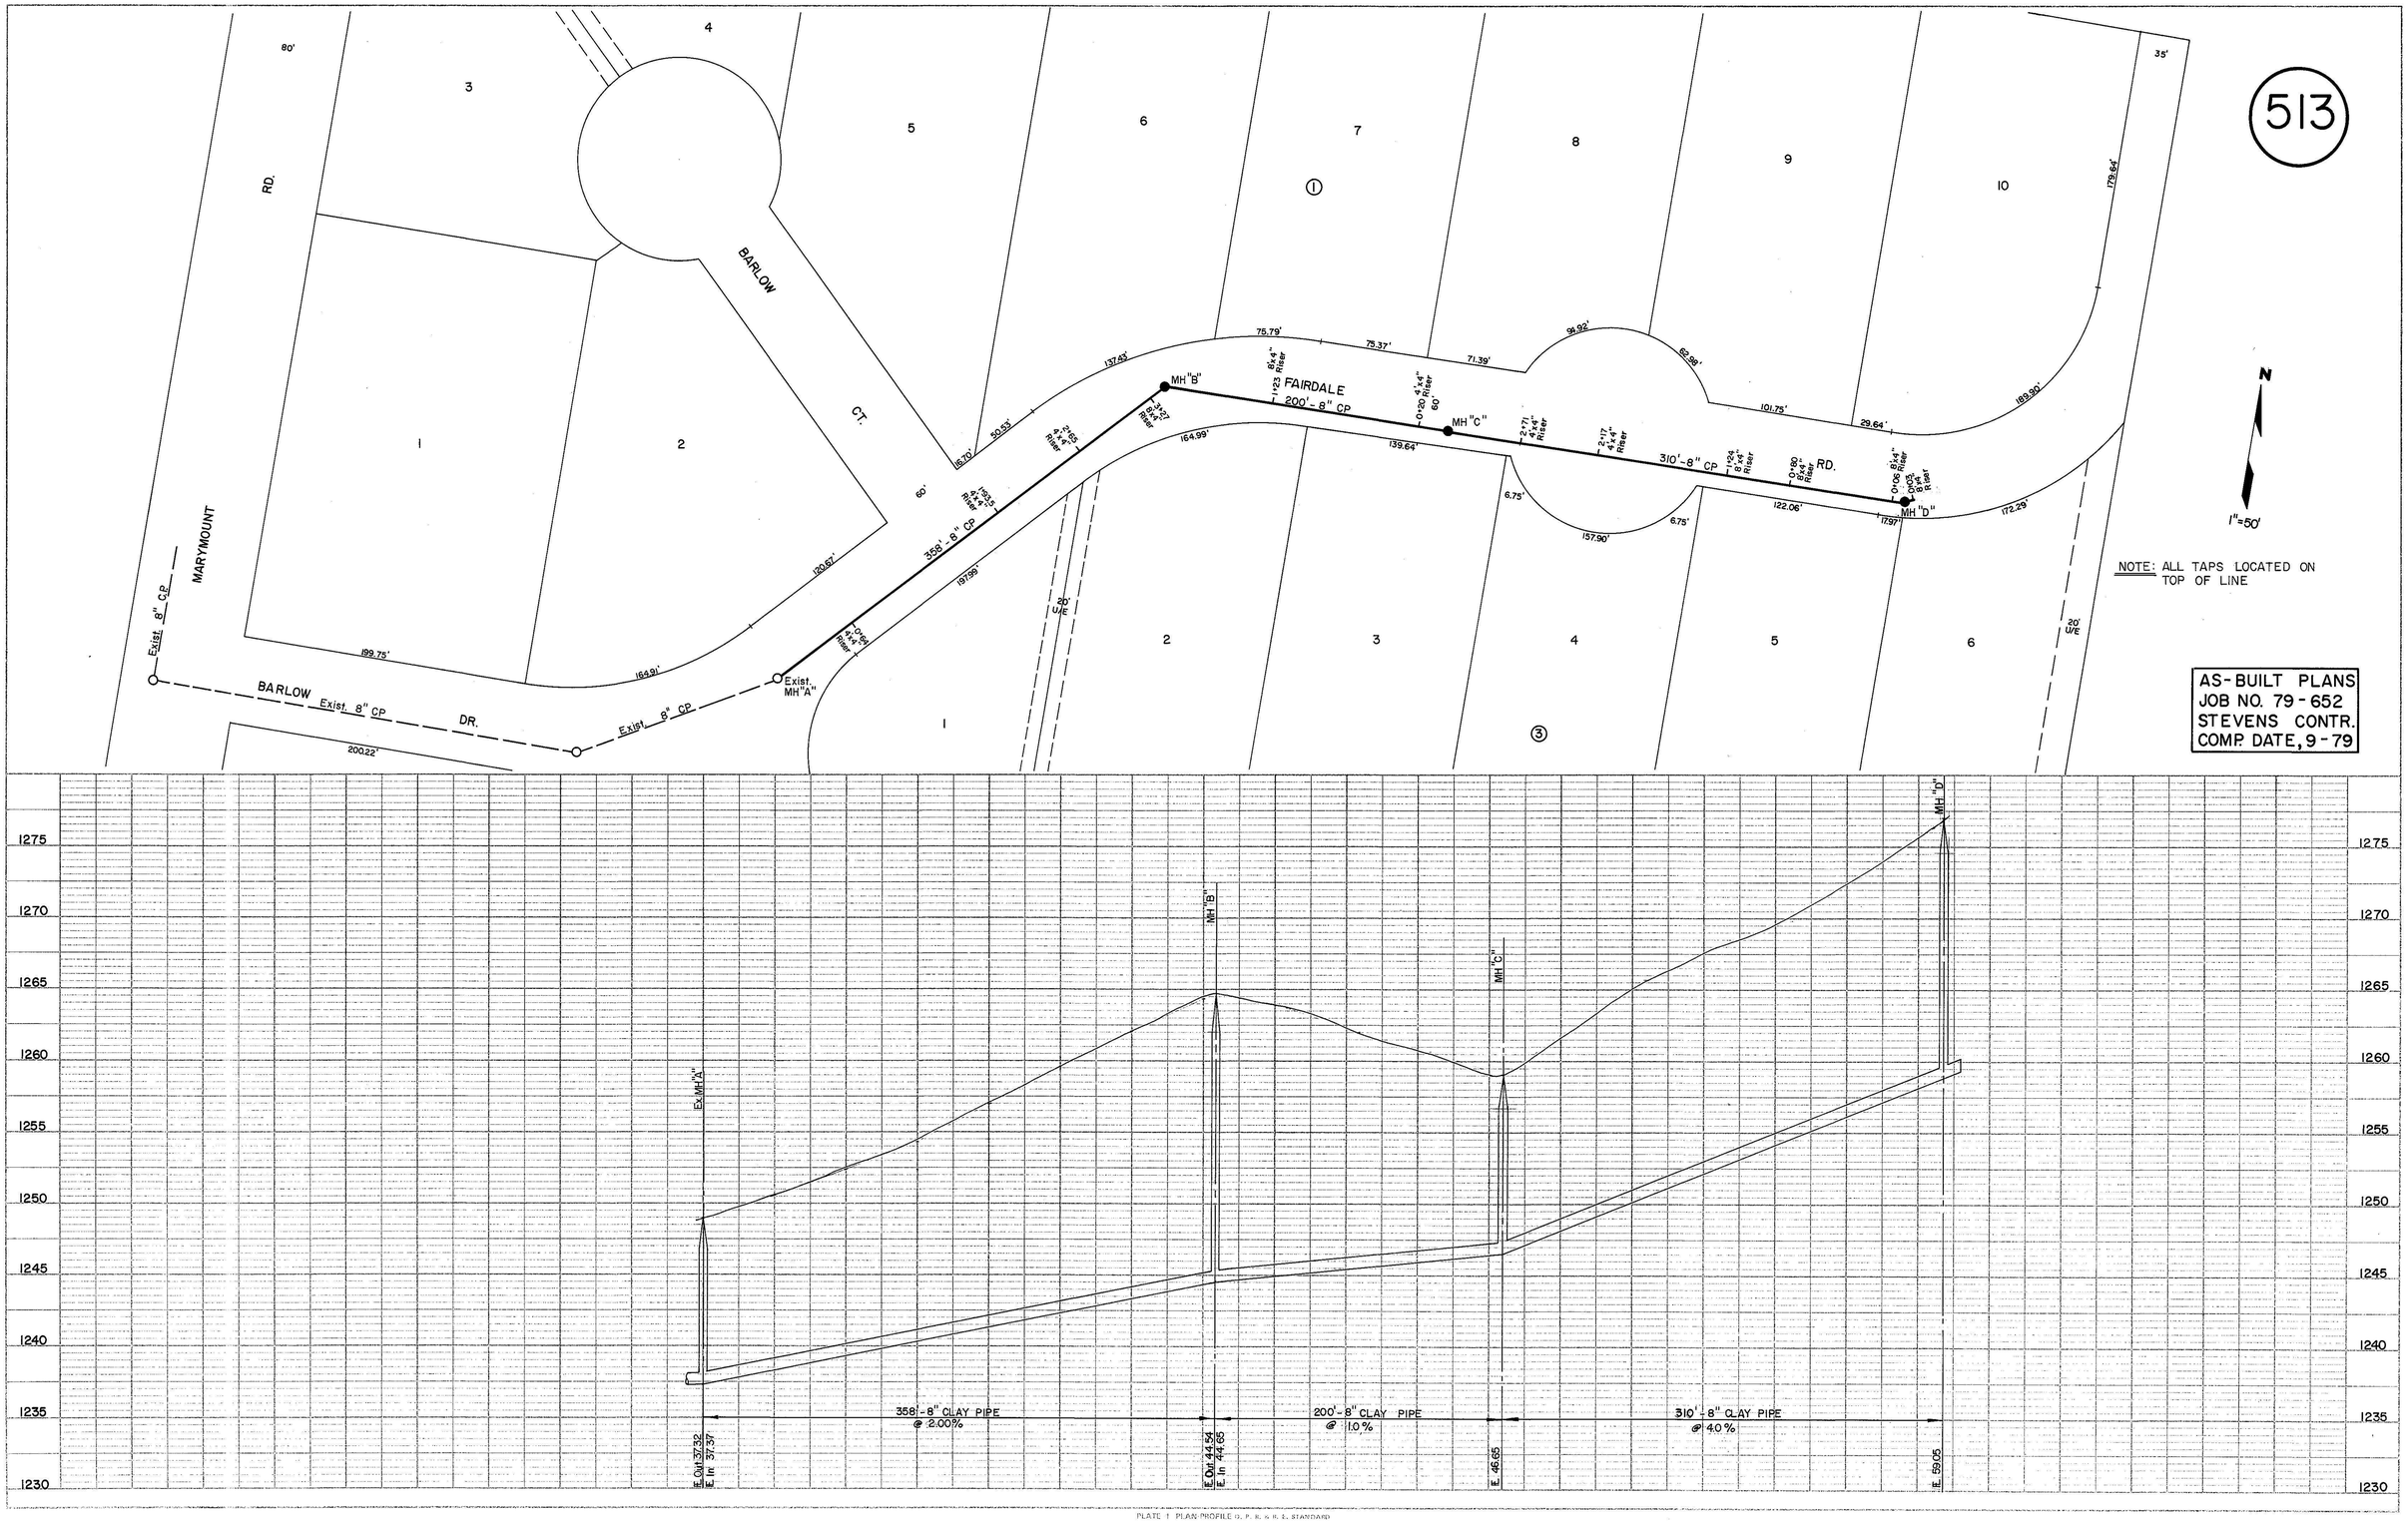
513
MARYMOUNT RD.
BARLOW CT.
BARLOW DR.
FAIRDALE RD.
Exist. 8" CP
Exist. 8" CP
Exist. 8" CP
Exist. MH "A"
MH "B"
MH "C"
MH "D"
358'-8" CP
200'-8" CP
310'-8" CP
80'
35'
179.64'
189.30'
172.29'
29.64'
101.75'
62.38'
98.92'
71.39'
75.37'
75.79'
137.43'
50.53'
16.70'
164.99'
139.64'
6.75'
157.90'
6.75'
122.06'
17.97'
197.99'
120.67'
164.91'
199.75'
200.22'
60'
50' U/E
20' U/E
N
1"=50'
NOTE: ALL TAPS LOCATED ON TOP OF LINE
AS-BUILT PLANS
JOB NO. 79-652
STEVENS CONTR.
COMP. DATE, 9-79
PLAN
NOTE BOOK
NO.
SURVEYED
PLOTTED
ALIGNMENT CHECKED
AS-BUILT PLAN PREPARED
BY
DATE
PROFILE
NOTE BOOK
NO.
SURVEYED
PLOTTED
GRADES CHECKED
AS-BUILT PLAN
STRUCTURE NOTATIONS CHECKED
BY
DATE
1275
1270
1265
1260
1255
1250
1245
1240
1235
1230
EX. MH "A"
MH "B"
MH "C"
MH "D"
358'-8" CLAY PIPE @ 2.00%
200'-8" CLAY PIPE @ 1.0%
310'-8" CLAY PIPE @ 4.0%
E Out 37.32
E In 37.37
E Out 44.54
E In 44.65
E 46.65
E 59.05