514

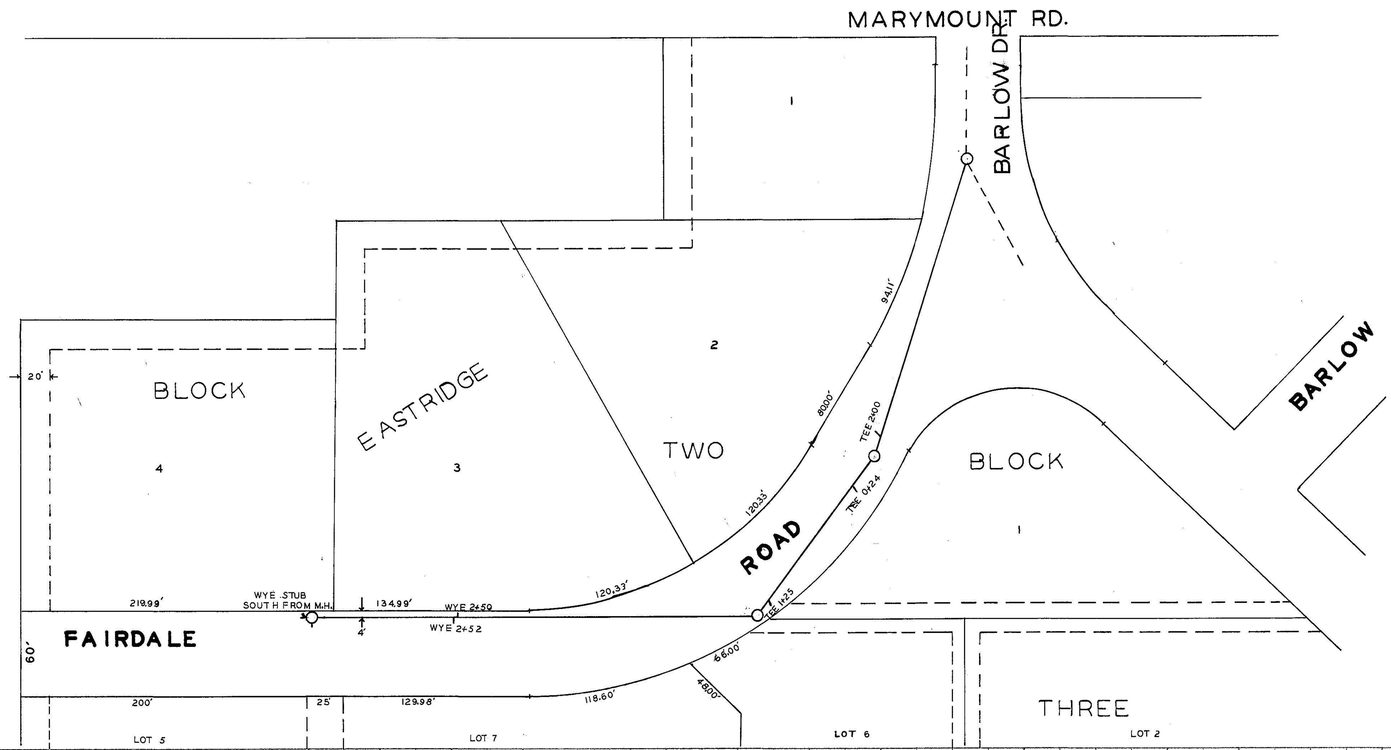

AS-BUILT PLANS
JOB NO. 80-671
STEVENS CONTR.
COMP. DATE 1-80

PLAN			
NOTE BOOK	SURVEYED		DATE
	PLOTTED		
	ALIGNMENT CHECKED		
NO.	RT. OF WAY CHECKED		

LATERAL NO. 618

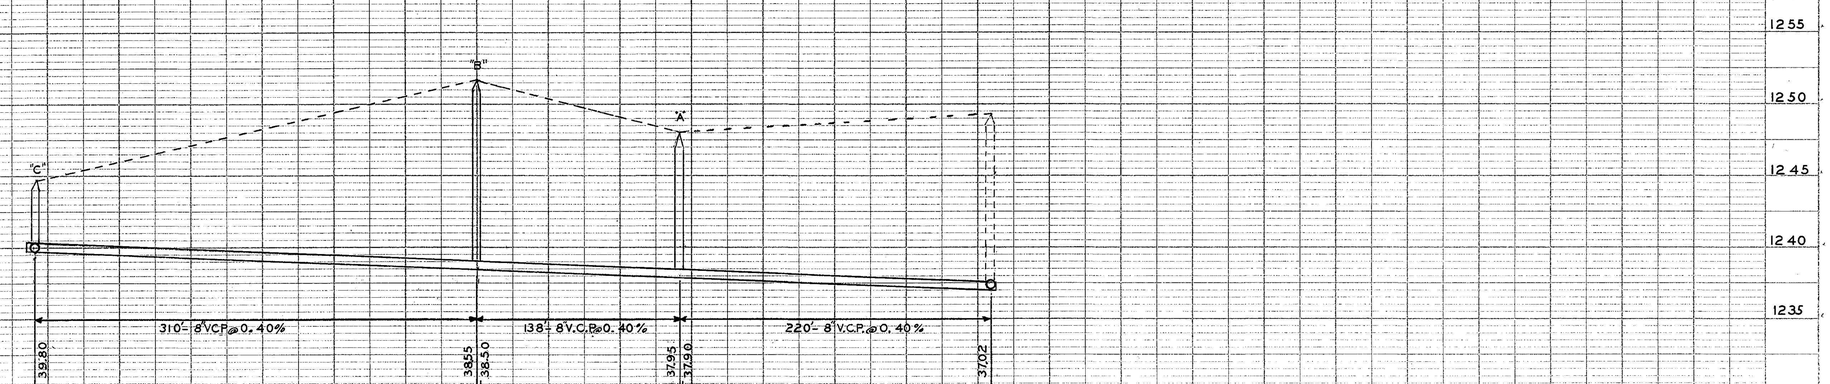

PROFILE			
NOTE BOOK	SURVEYED		DATE
	PLOTTED		
	GRADES CHECKED		
	O. K. NOTED		
NO.	STRUCTURE WORKING DRWG.		

PLATE 1 PLAN PROFILE O. P. R. & R. STANDARD
THE ARU PAPER-TAPE AND PRINTED IN U.S.A.
BURLE BLETZGER CO.