SHEET 2 OF 8

515

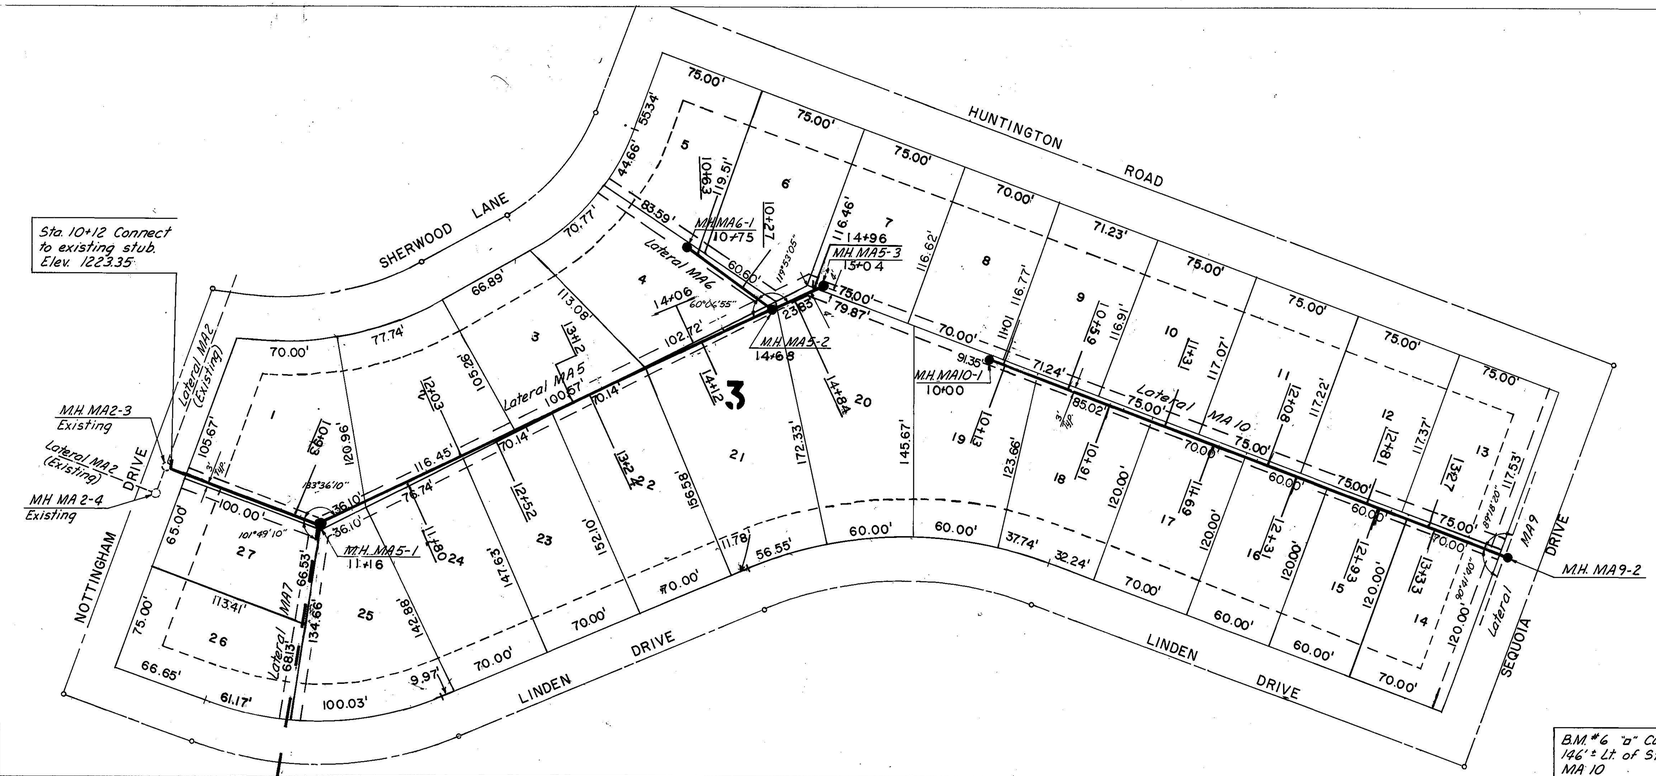

ASBUILT
JOB 80-674
ARKANSAS CON.
COMP. DATE 6/81

B.M. #5 RR Spike in Power Pole @ SW corner of Shalimar Drive & Nottingham Drive. Elev. 1231.93

B.M. #6 "a" Cut on conc. M.H. apron 146'± Lt. of Sta. 10+40 Lateral MA 10 Elev. 1234.14

Profile Scale: Horiz. 1" = 50' Vert. 1" = 5'

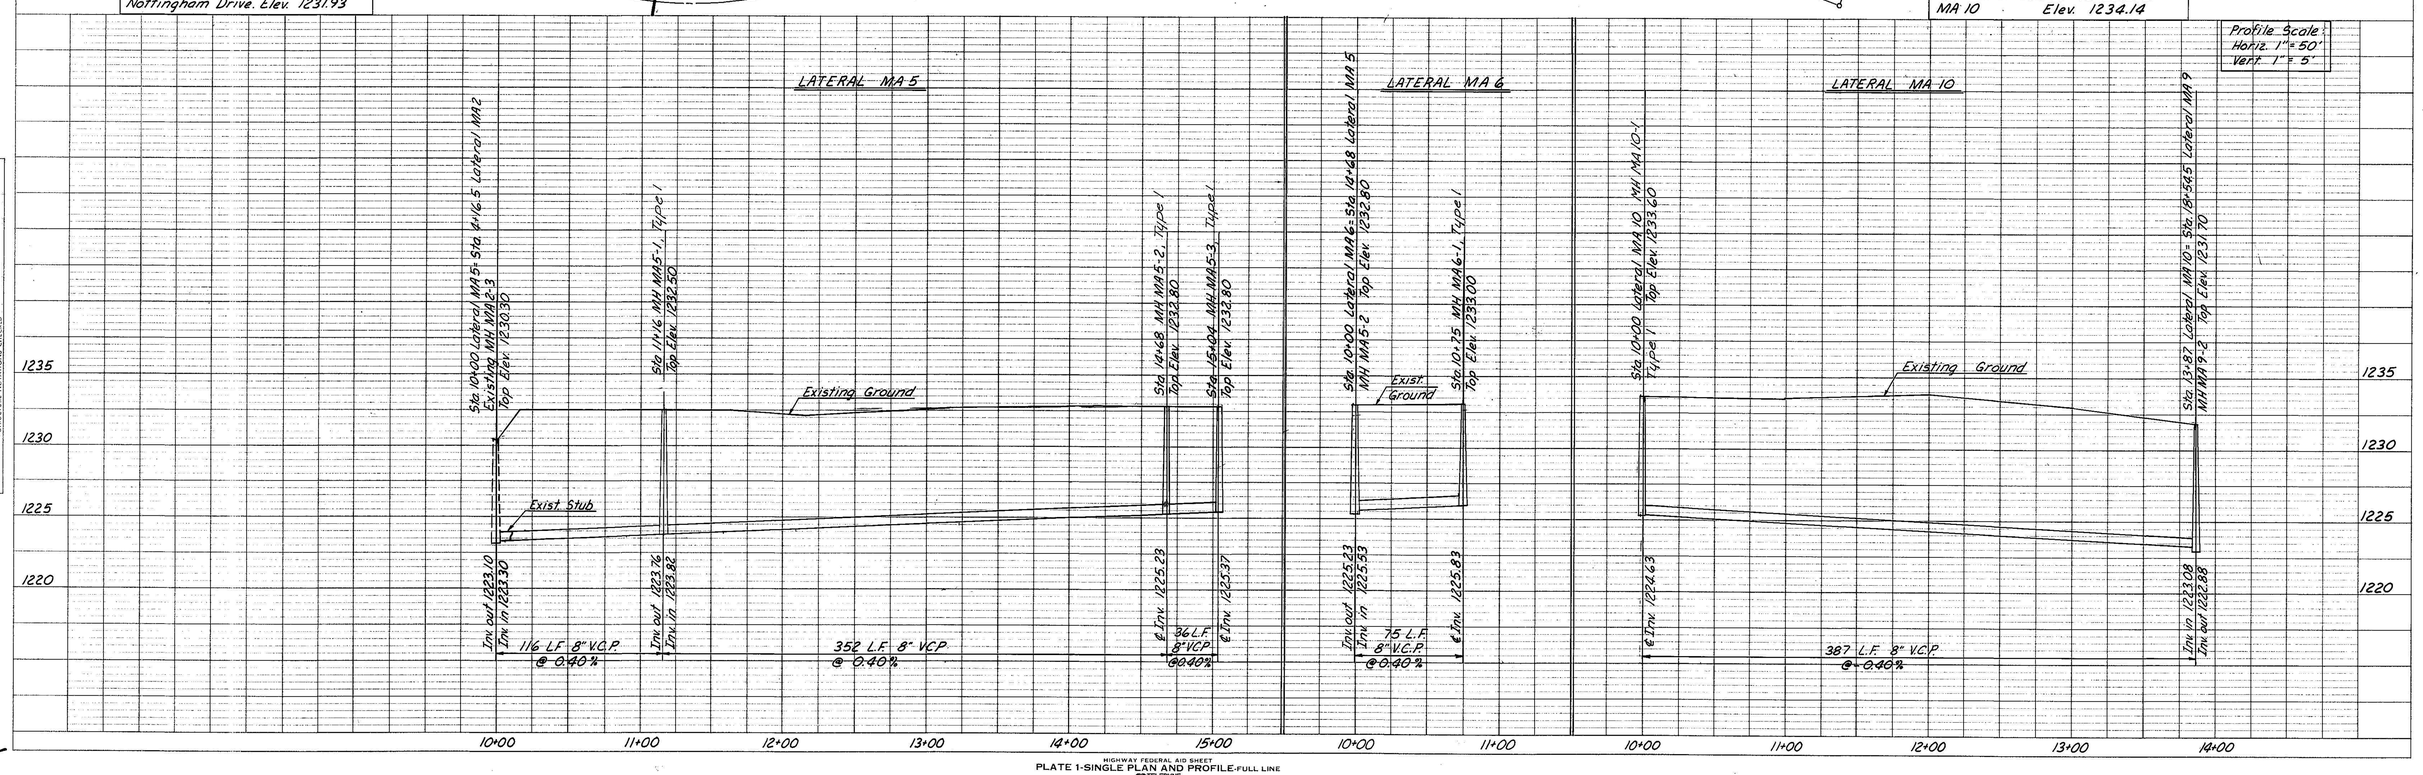

PLAN SURVEYED PLOTTED NOTE BOOK ALIGNMENT CHECKED No. BT. OF WAY CHECKED BY DATE

PROFILE SURVEYED PLOTTED NOTE BOOK GRADES CHECKED No. B. M.'s NOTED STRUCTURE NOTATIONS CHECKED BY DATE