SHEET 3 OF 8

516

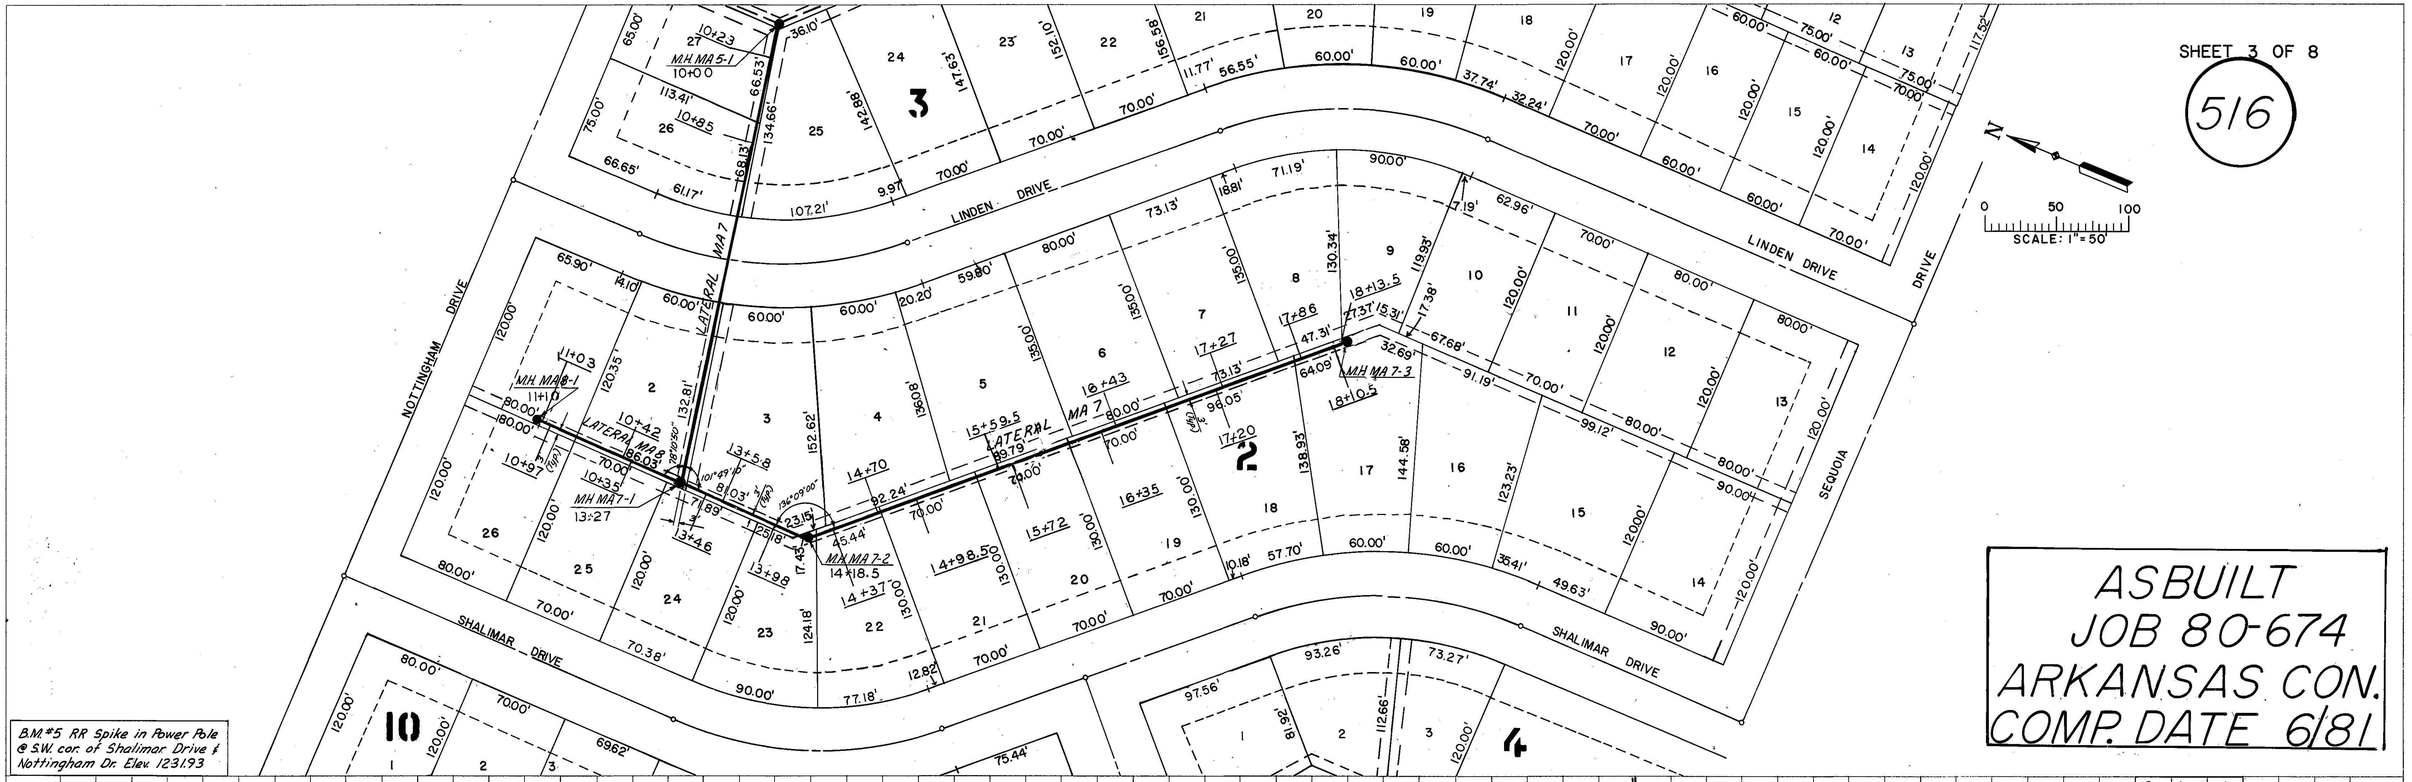

ASBUILT
JOB 80-674
ARKANSAS CON.
COMP. DATE 6/81

B.M. #5 RR Spike in Power Pole @ S.W. cor. of Shalimar Drive & Nottingham Dr. Elev. 1231.93

PLAN
NOTE BOOK

PROFILE
NOTE BOOK
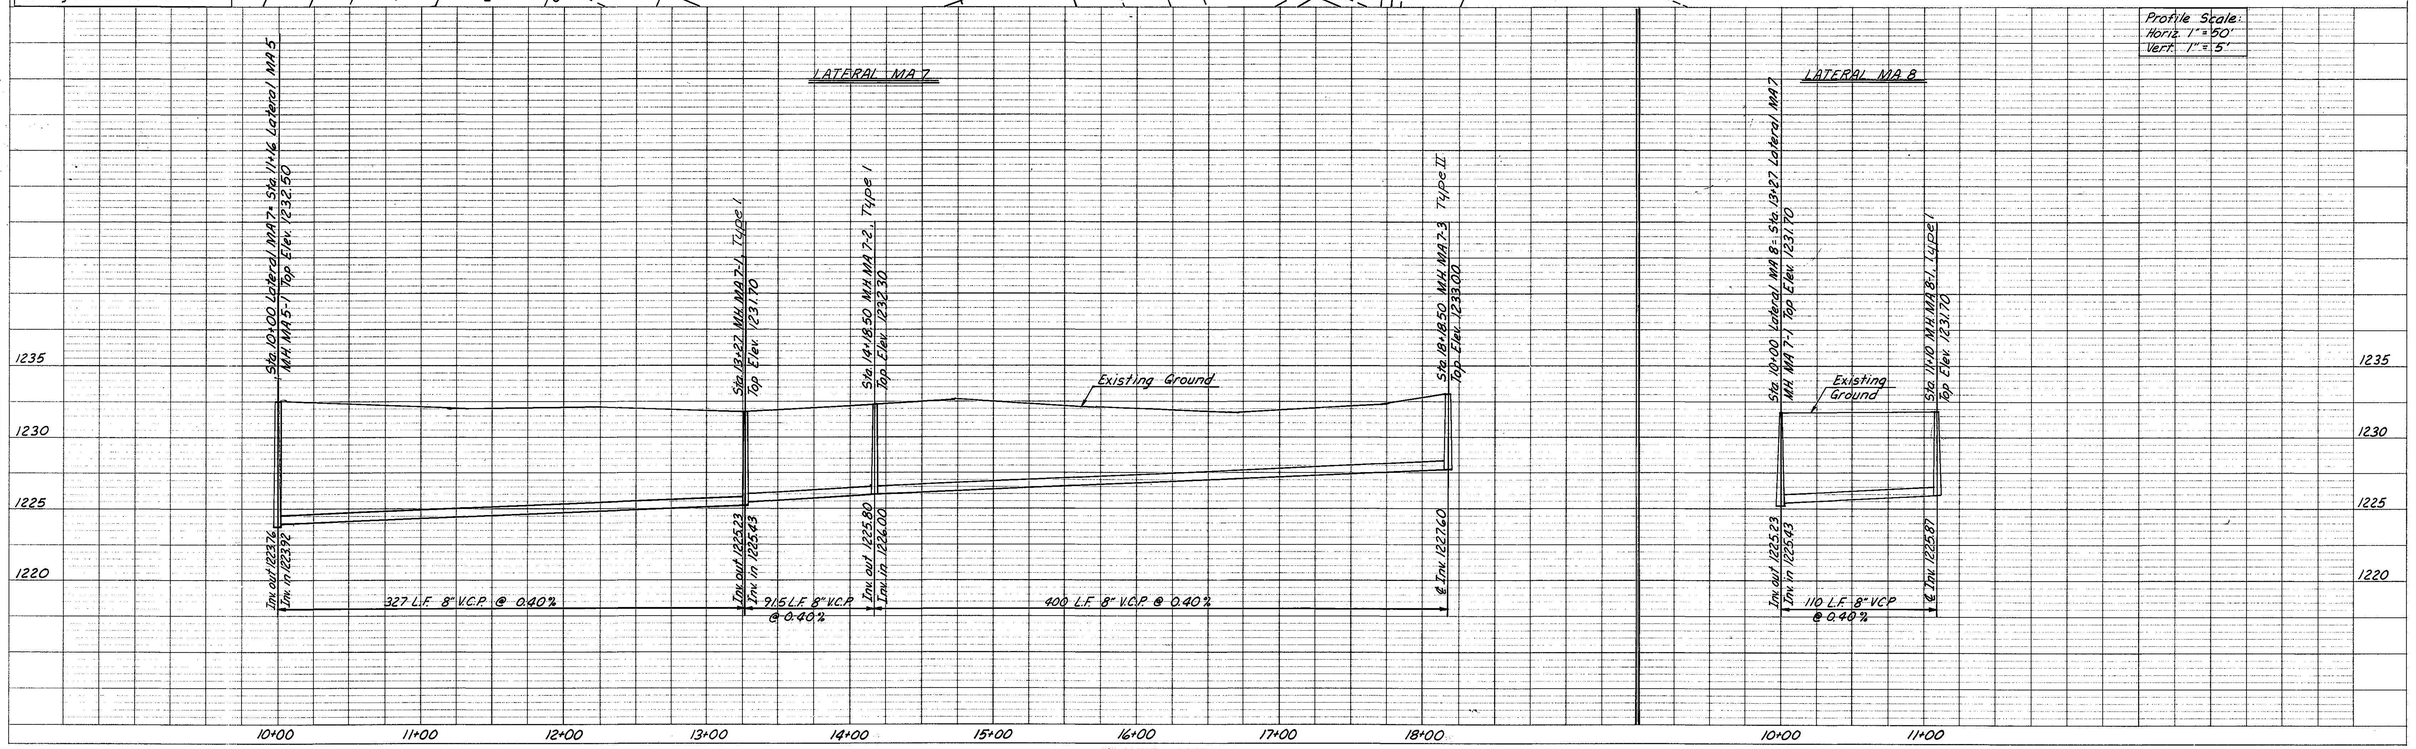
Profile Scale:
Horiz. 1" = 50'
Vert. 1" = 5'