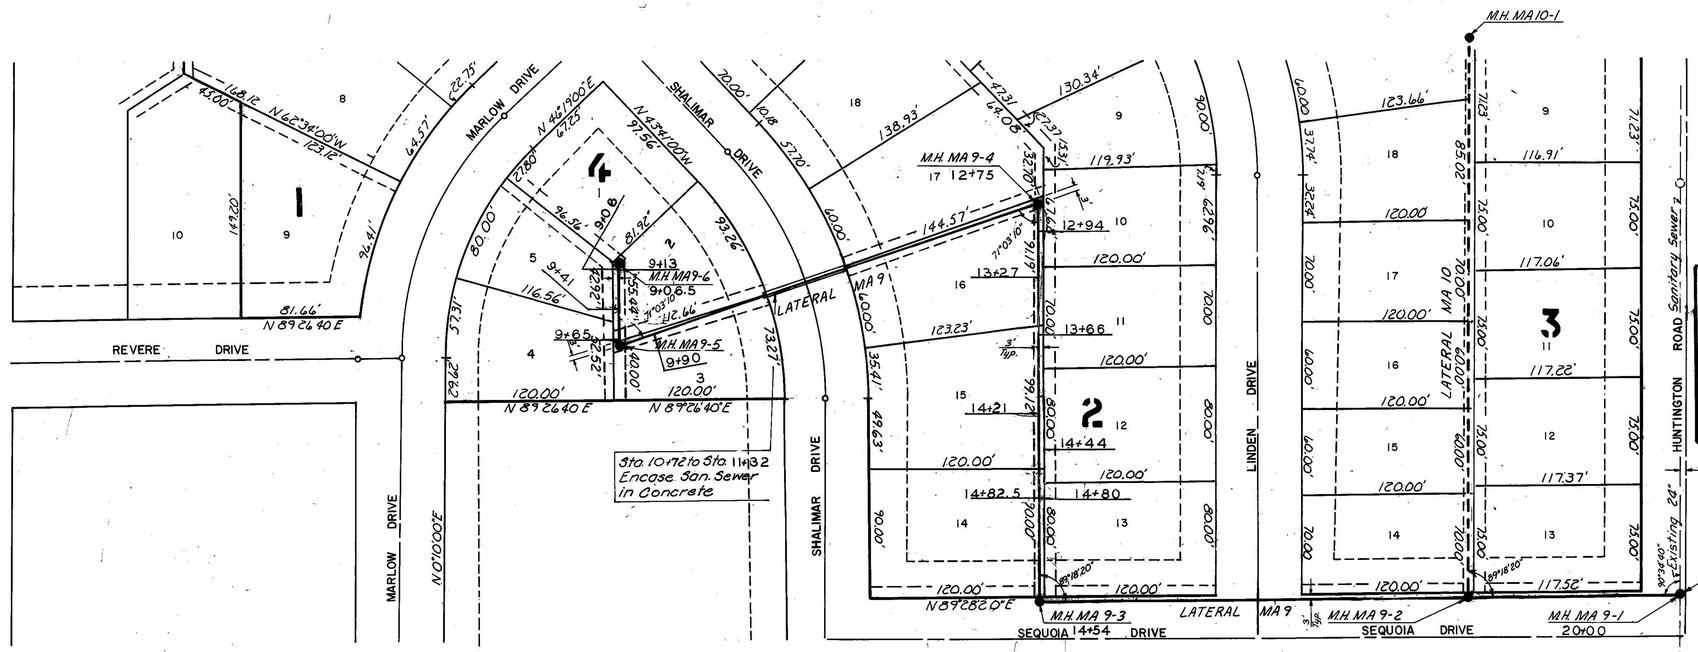


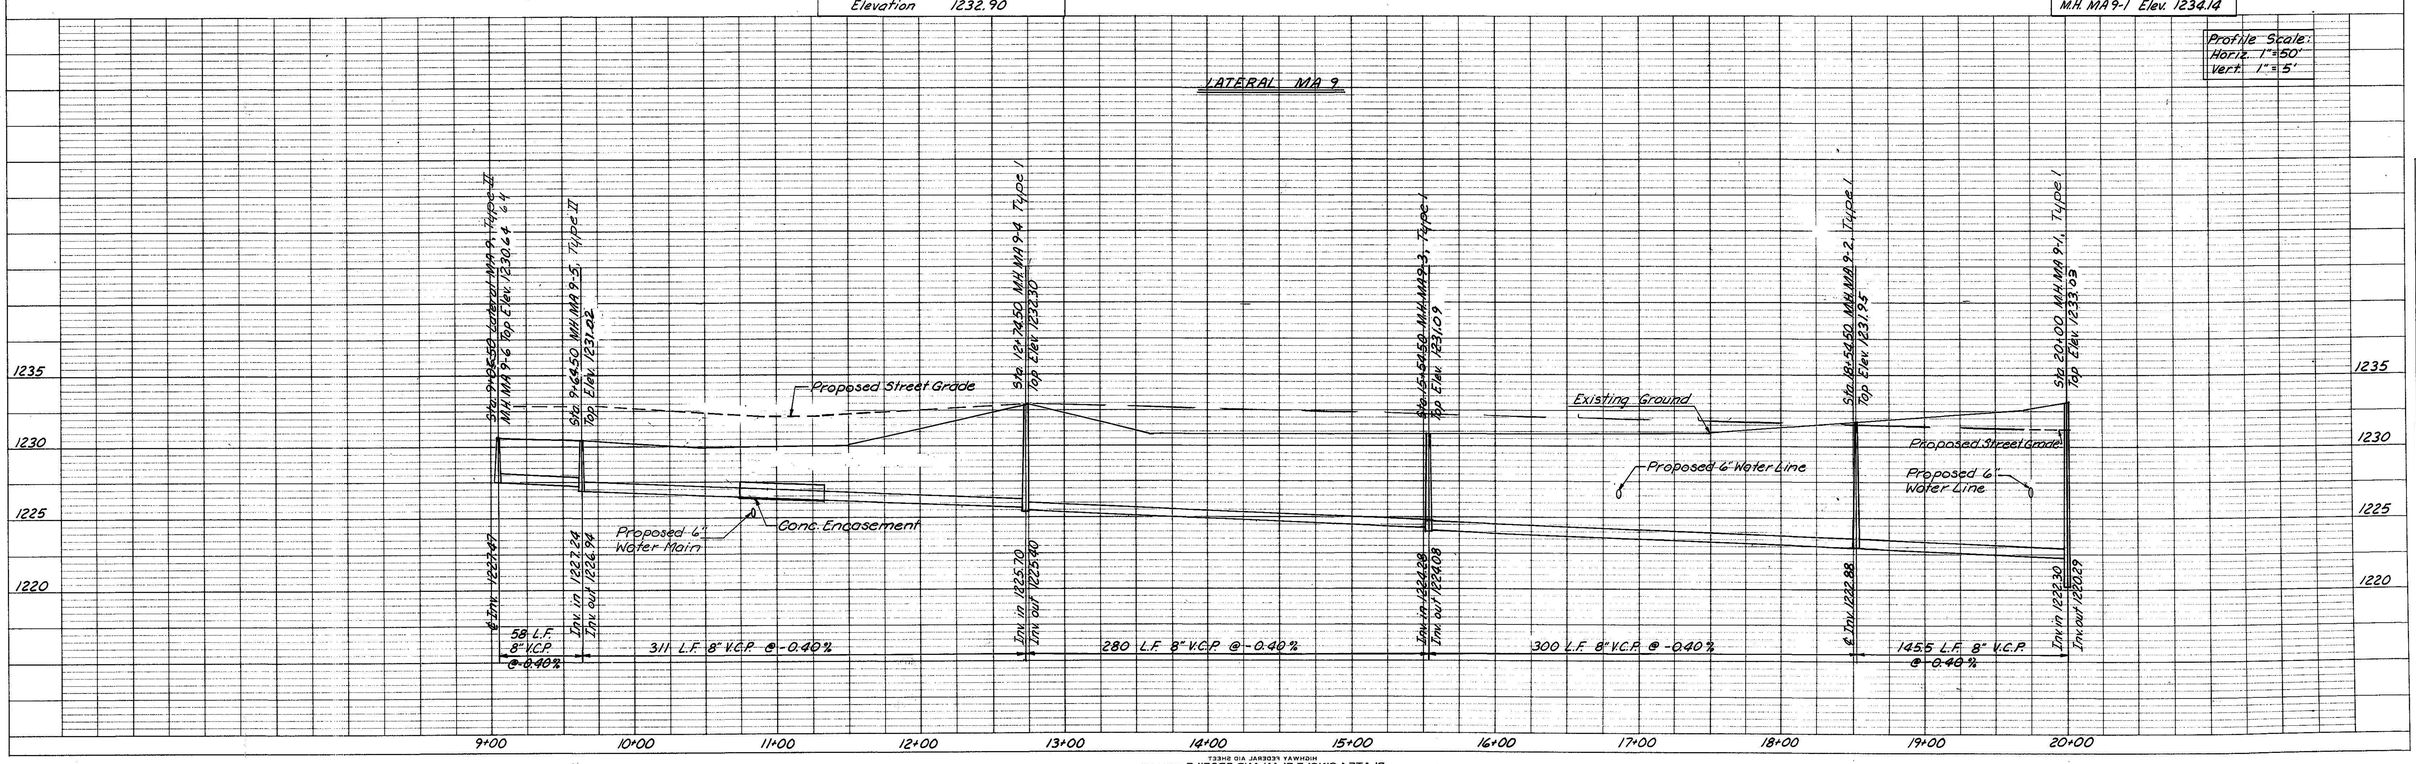


PLATE 1-SINGLE PLAN AND PROFILE-FULL LINE
HIGHWAY FEDERAL AID SHEET
PRINTED IN U.S.A.