518

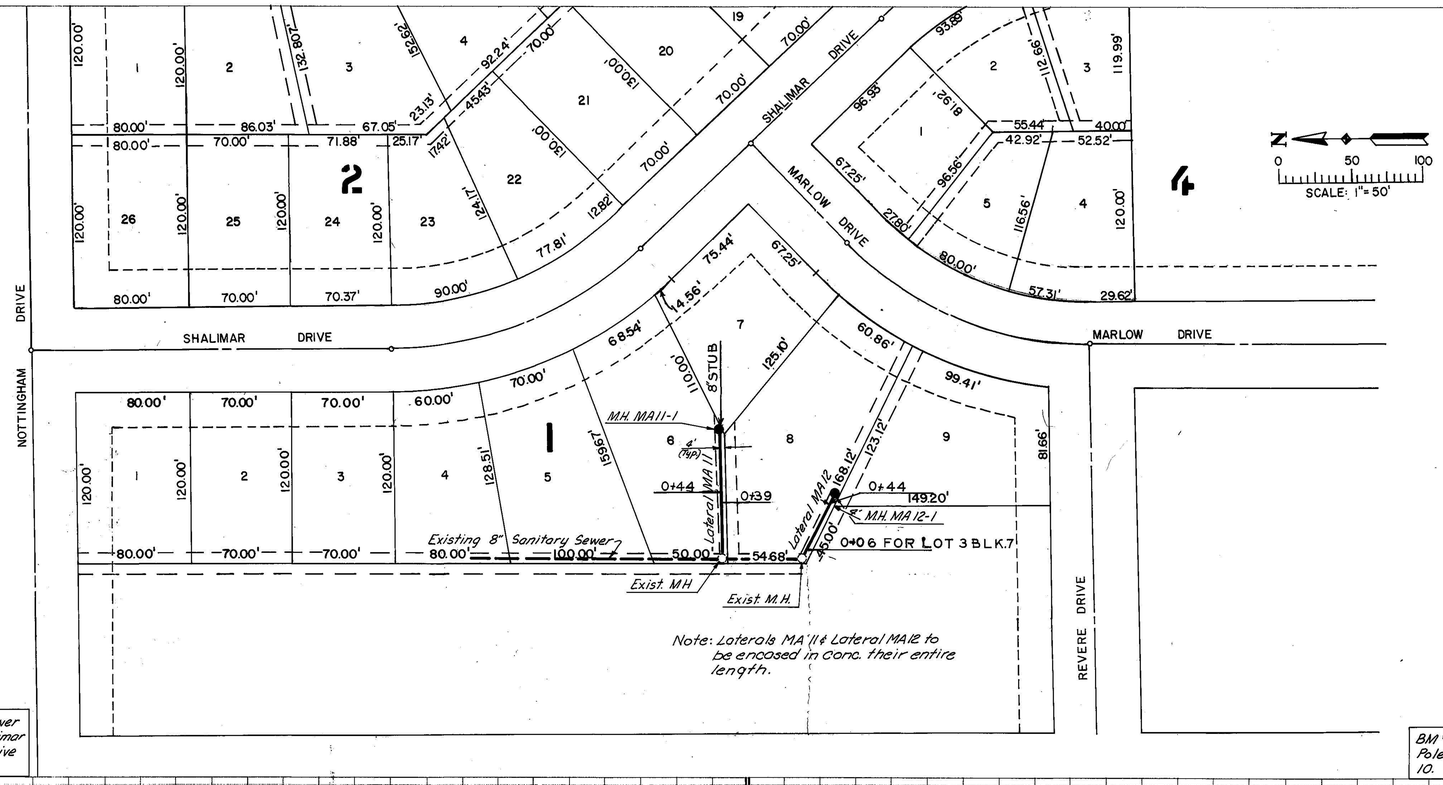

BM #5 RR Spike in Power Pole @ S.W. Cor. of Shalimar Drive & Nottingham Drive Elevation 1231.93

BM #8 RR Spike in T.V. Cable Pole @ S.W. Cor. Lot 8 Block 10. Elevation 1232.90

ASBUILT
JOB 80-674
ARKANSAS CON.
COMP. DATE 6/81

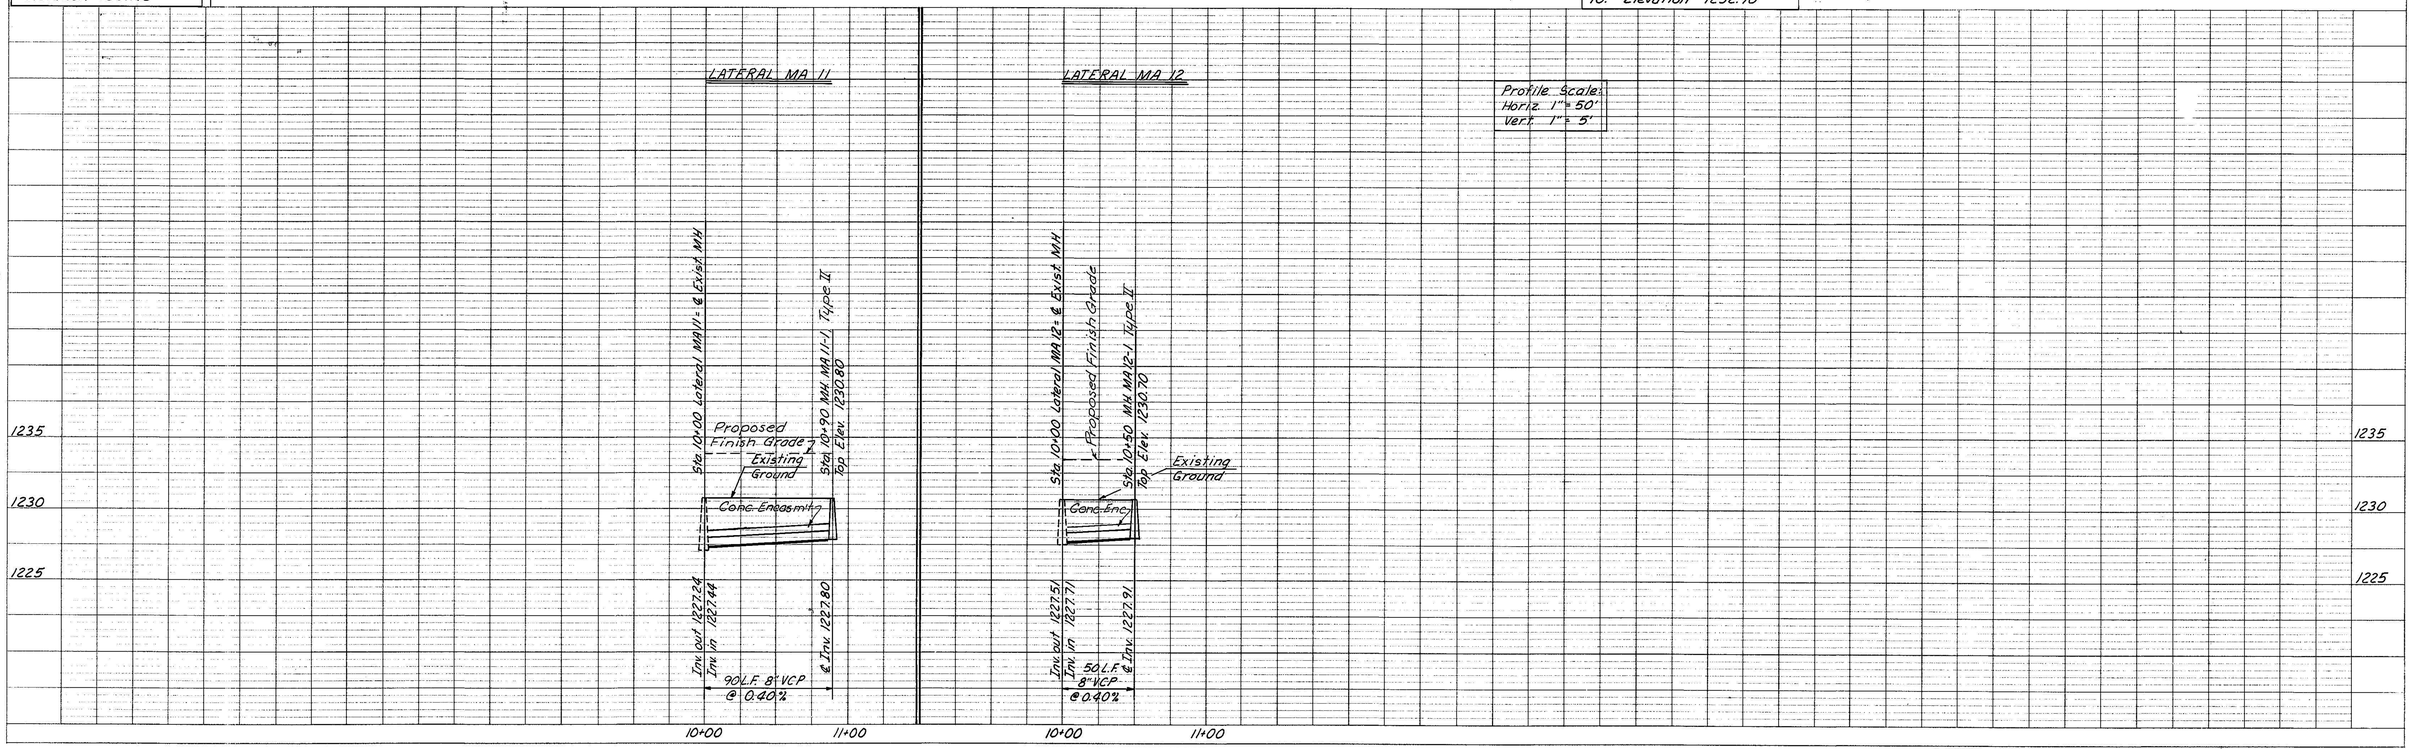

PLAN SURVEYED ... PLOTTED ... ALIGNMENT CHECKED ... RT. OF WAY CHECKED ... NOTE BOOK ... No. ... BY ... DATE

PROFILE SURVEYED ... PLOTTED ... GRADES CHECKED ... & K.I. NOTED ... STRUCTURE LOCATIONS CHECKED ... NOTE BOOK ... No. ... BY ... DATE