519

AS-BUILT PLANS
JOB NO. 82-688
STEVEN'S CONTR.
COMP. DATE 10-82

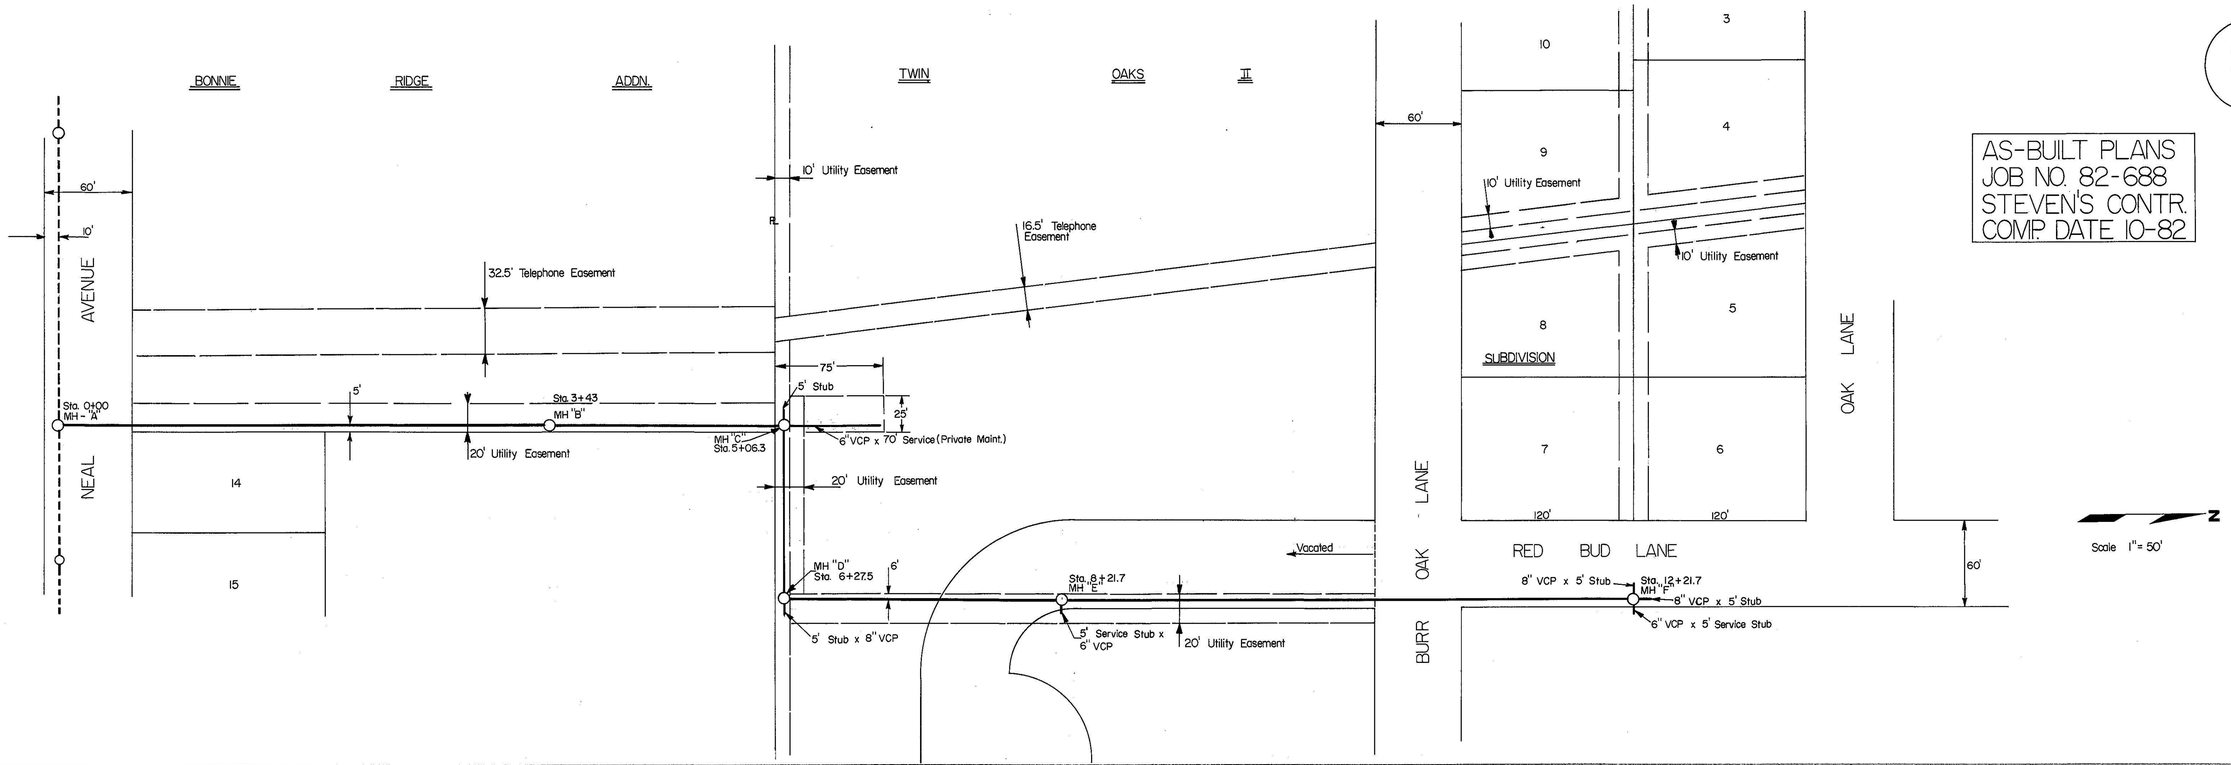

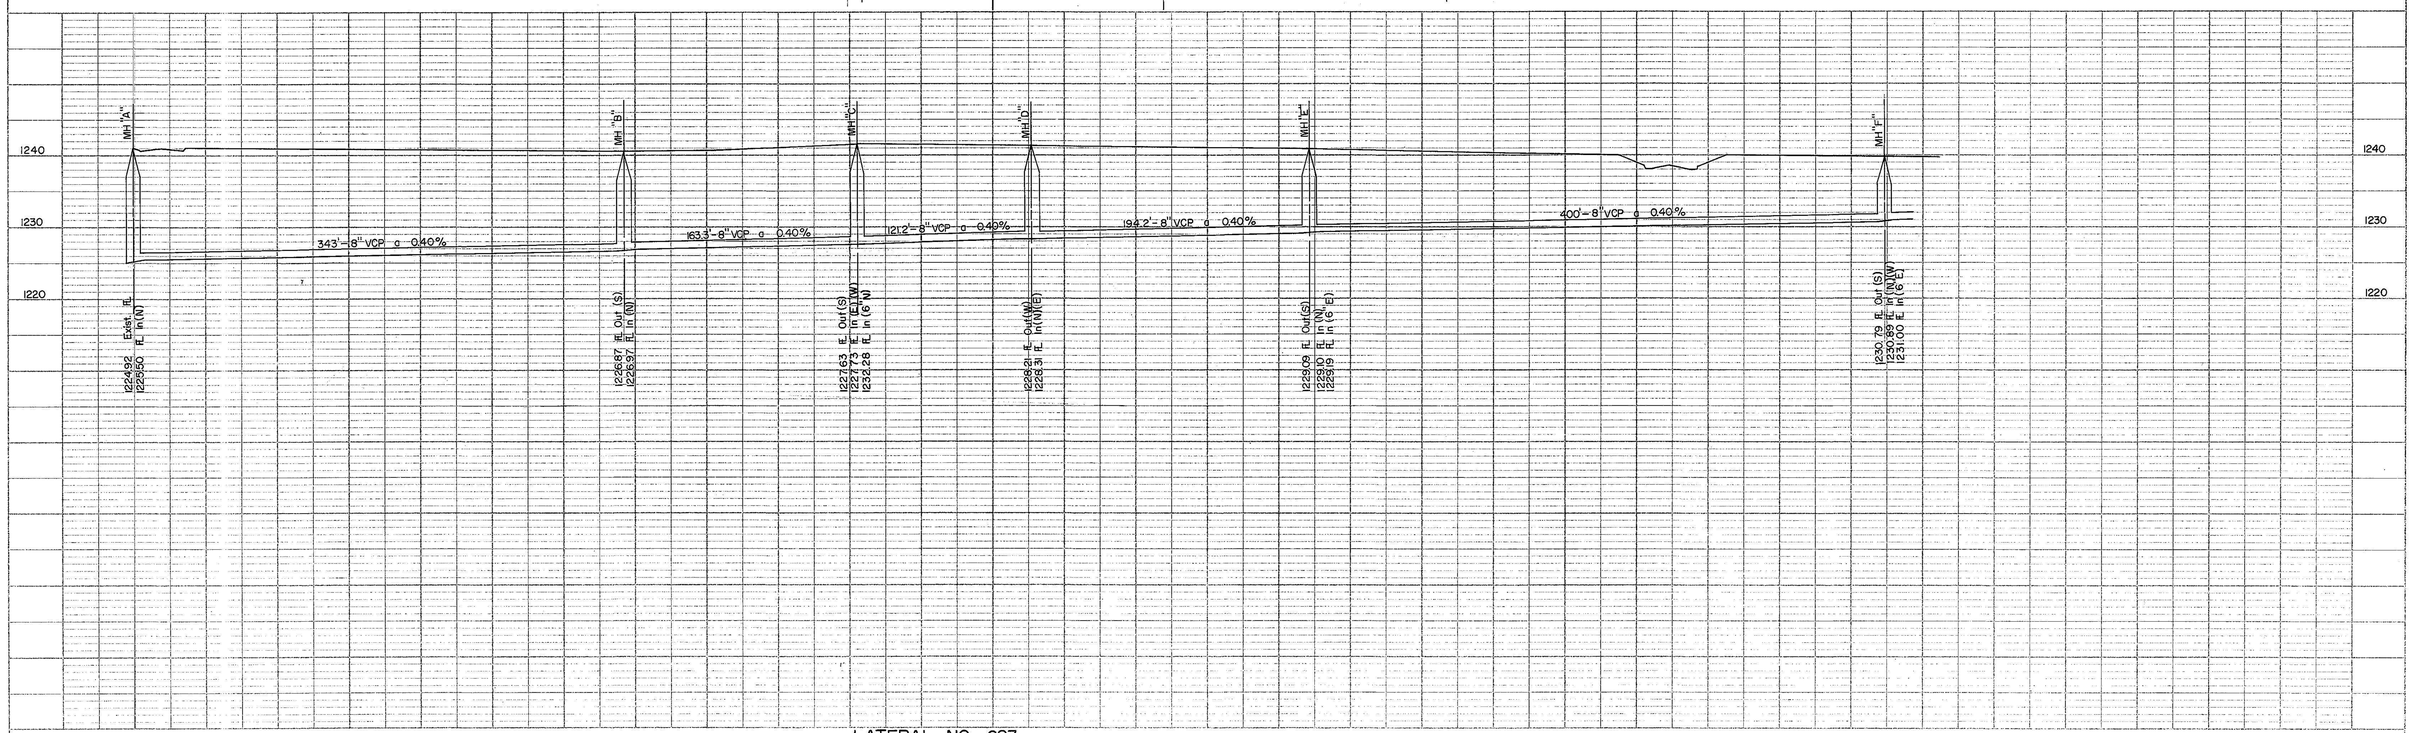

LATERAL NO. 623

PLATE 1 PLAN-PROFILE O. F. B. & R. E. STANDARD
100 RAG PAPER - MADE AND PRINTED IN U.S.A.
LEITZ & BIERZIEN CO.

PLAN
NOTE BOOK
NO.
SURVEYED
PLOTTED
ALIGNMENT CHECKED
PT. OF WAY CHECKED
BY
DATE

PROFILE
NOTE BOOK
NO.
SURVEYED
PLOTTED
GRADES CHECKED
B. M. NOTE
STRUCTURE NOTE AND CHECKED
BY
DATE