520

AS-BUILT PLANS
JOB NO. 82-688
STEVEN'S CONTR.
COMP. DATE 10-82

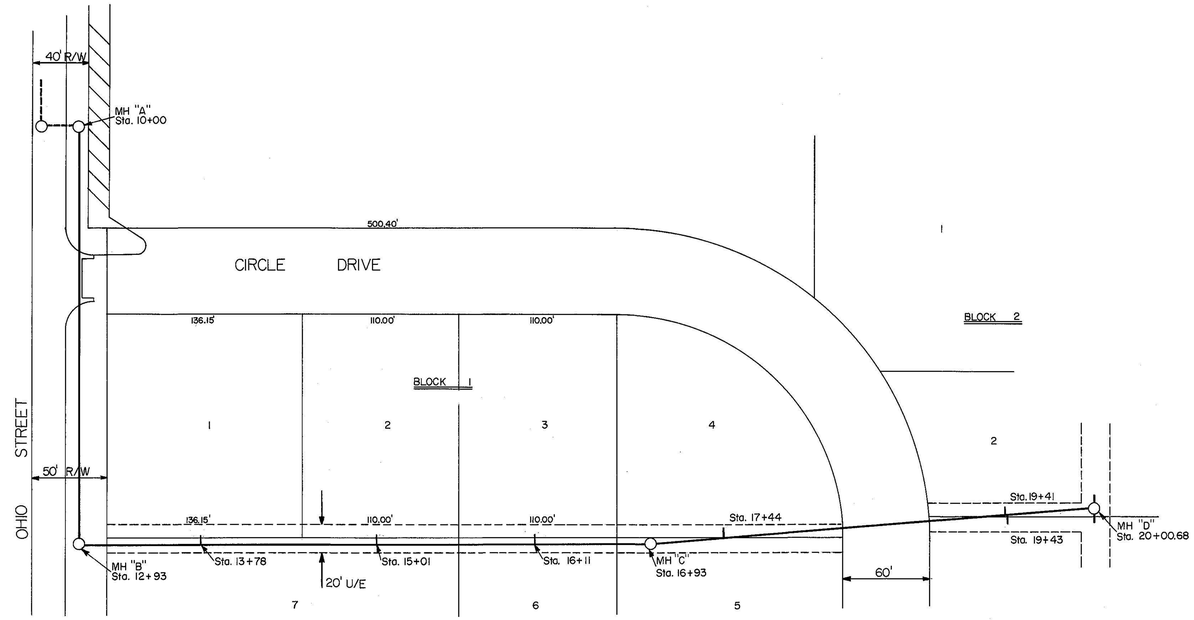

N

Scale 1"=50'

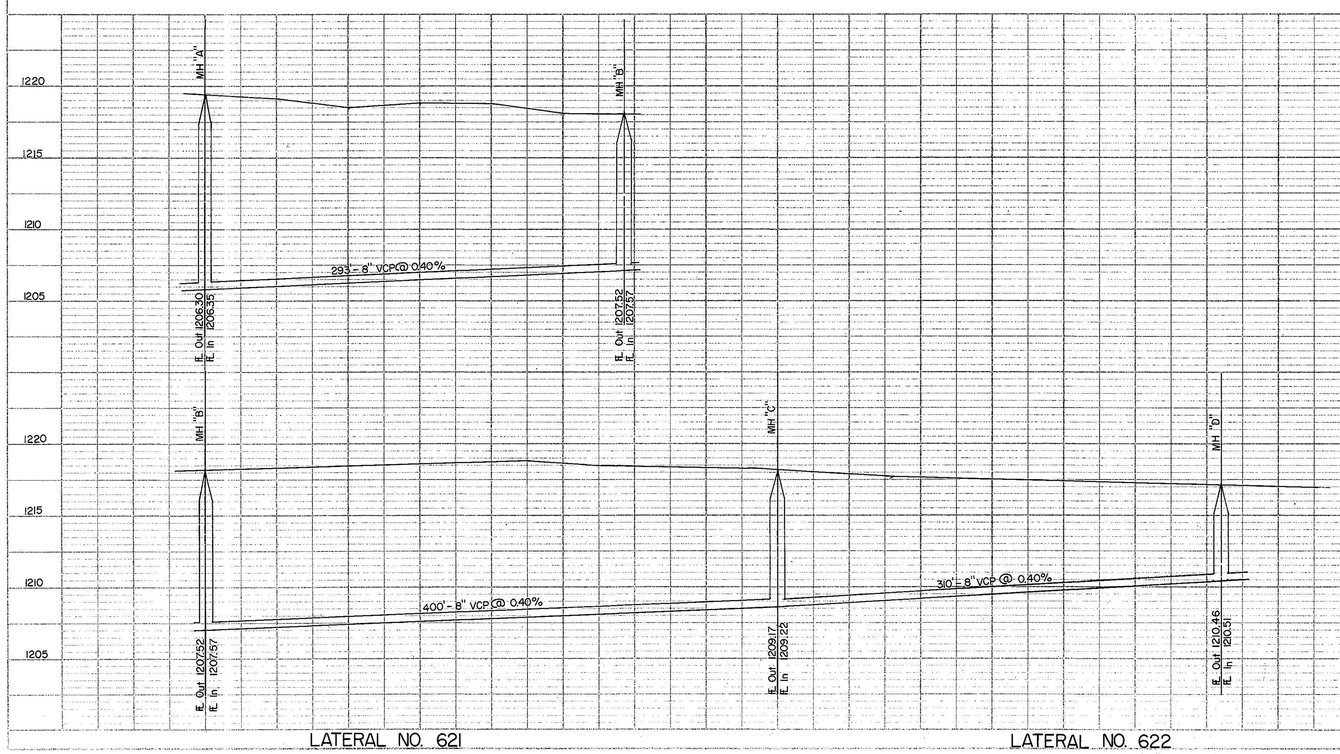

LATERAL NO. 621

LATERAL NO. 622

PLAN		BY	DATE
NOTE BOOK	SURVEYED		
	PLOTTED		
	ALIGNMENT CHECKED		
NO.	MT. OF MAP CHECKED		

PROFILE		BY	DATE
NOTE BOOK	SURVEYED		
	PLOTTED		
	GRADES CHECKED		
	MT. OF PROF.		
NO.	STRUCTURE NOTE CHECKED		

PLATE 1 PLAN-PROFILE O. P. W. C. S. STANDARD
THIS PLAN PROFILE MADE AND PRINTED ON O.S.P.
STEVENS CONTRACTING CO.