AS-BUILT PLANS
JOB NO. 82-688
STEVEN'S CONTR.
COMP. DATE 10-82

521

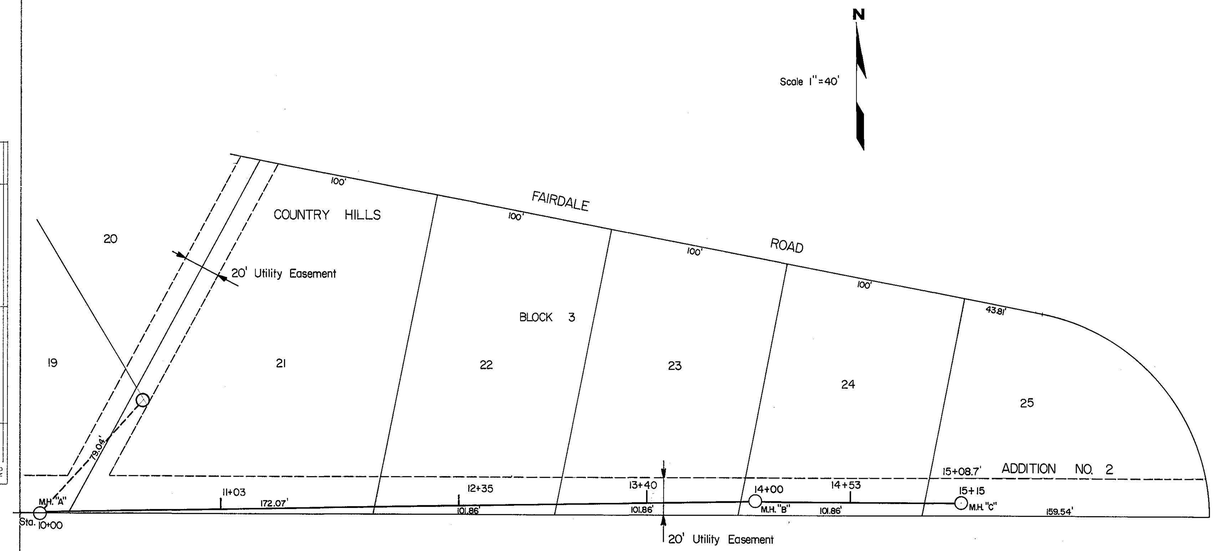

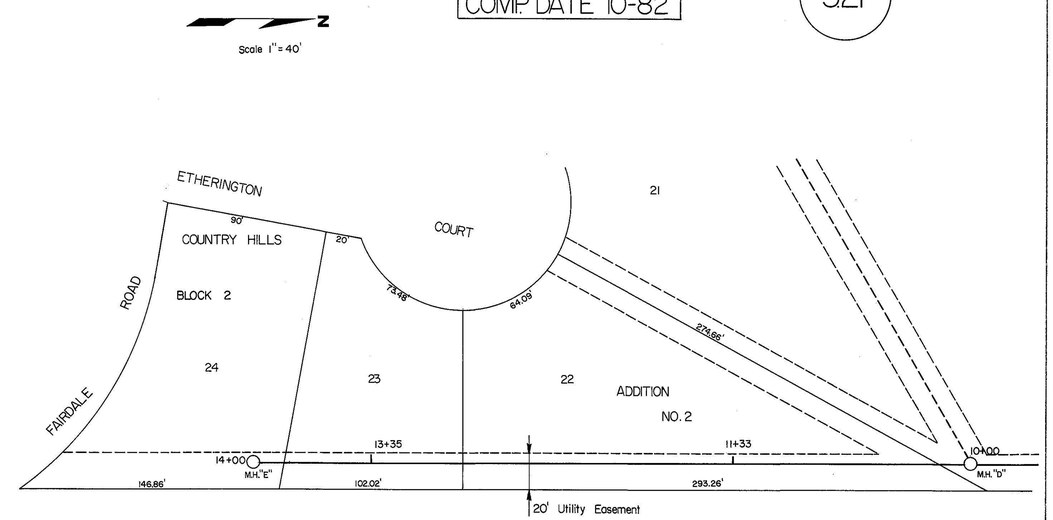

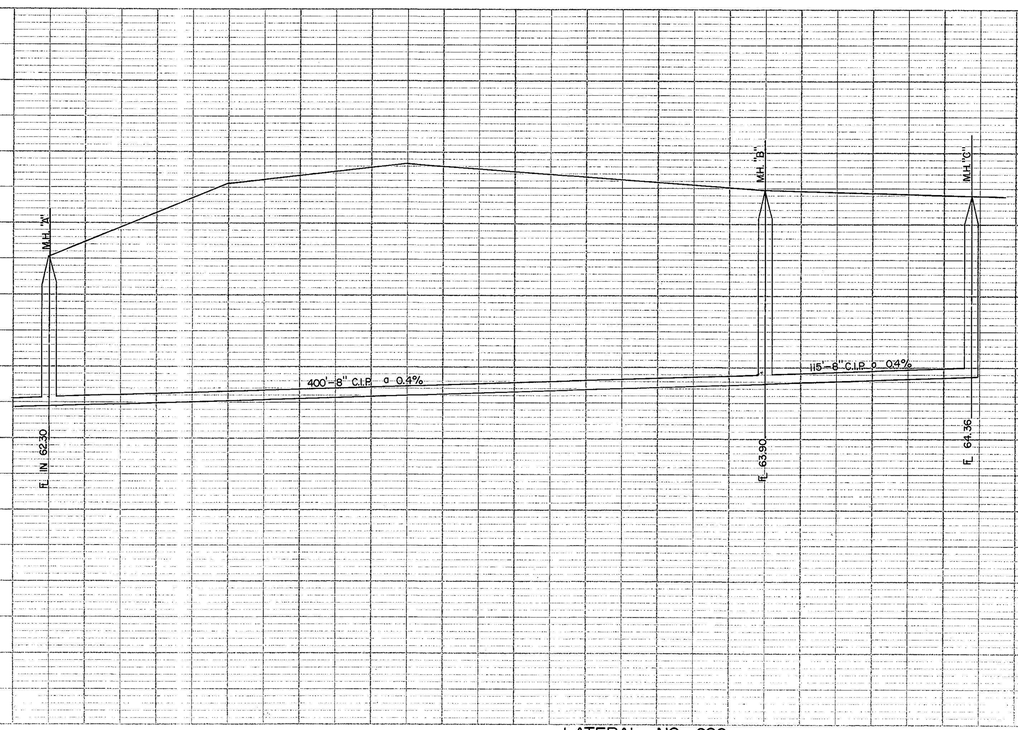

LATERAL NO. 620

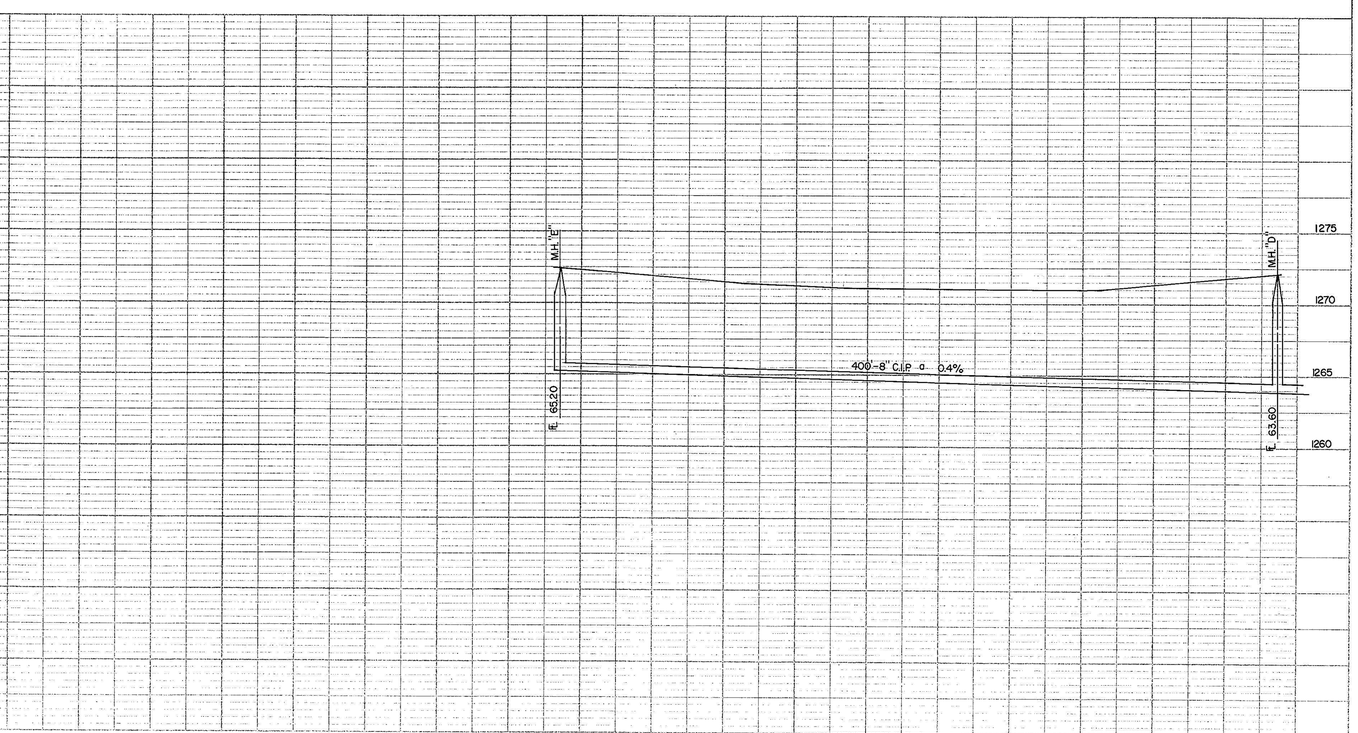

LATERAL NO. 619

PLAN					
NOTE BOOK	SURVEYED			BY	DATE
	DRAWN				
	ALIGNMENT CHECKED				
	RT. OF WAY CHECKED				
NO					

				BY	DATE
1" = 40'	MADE CHECKED				
	PROFILE CHECKED				
	STRUCTURE NOTE NO. CH. NO.				

PLATE 1 PLAN PROFILE D. P. W. G. A. L. STANDARD
THE ALL PAPER-NESS AND PRINTED IN U.S.A.
DIETZGEN-HEINZEN CO.