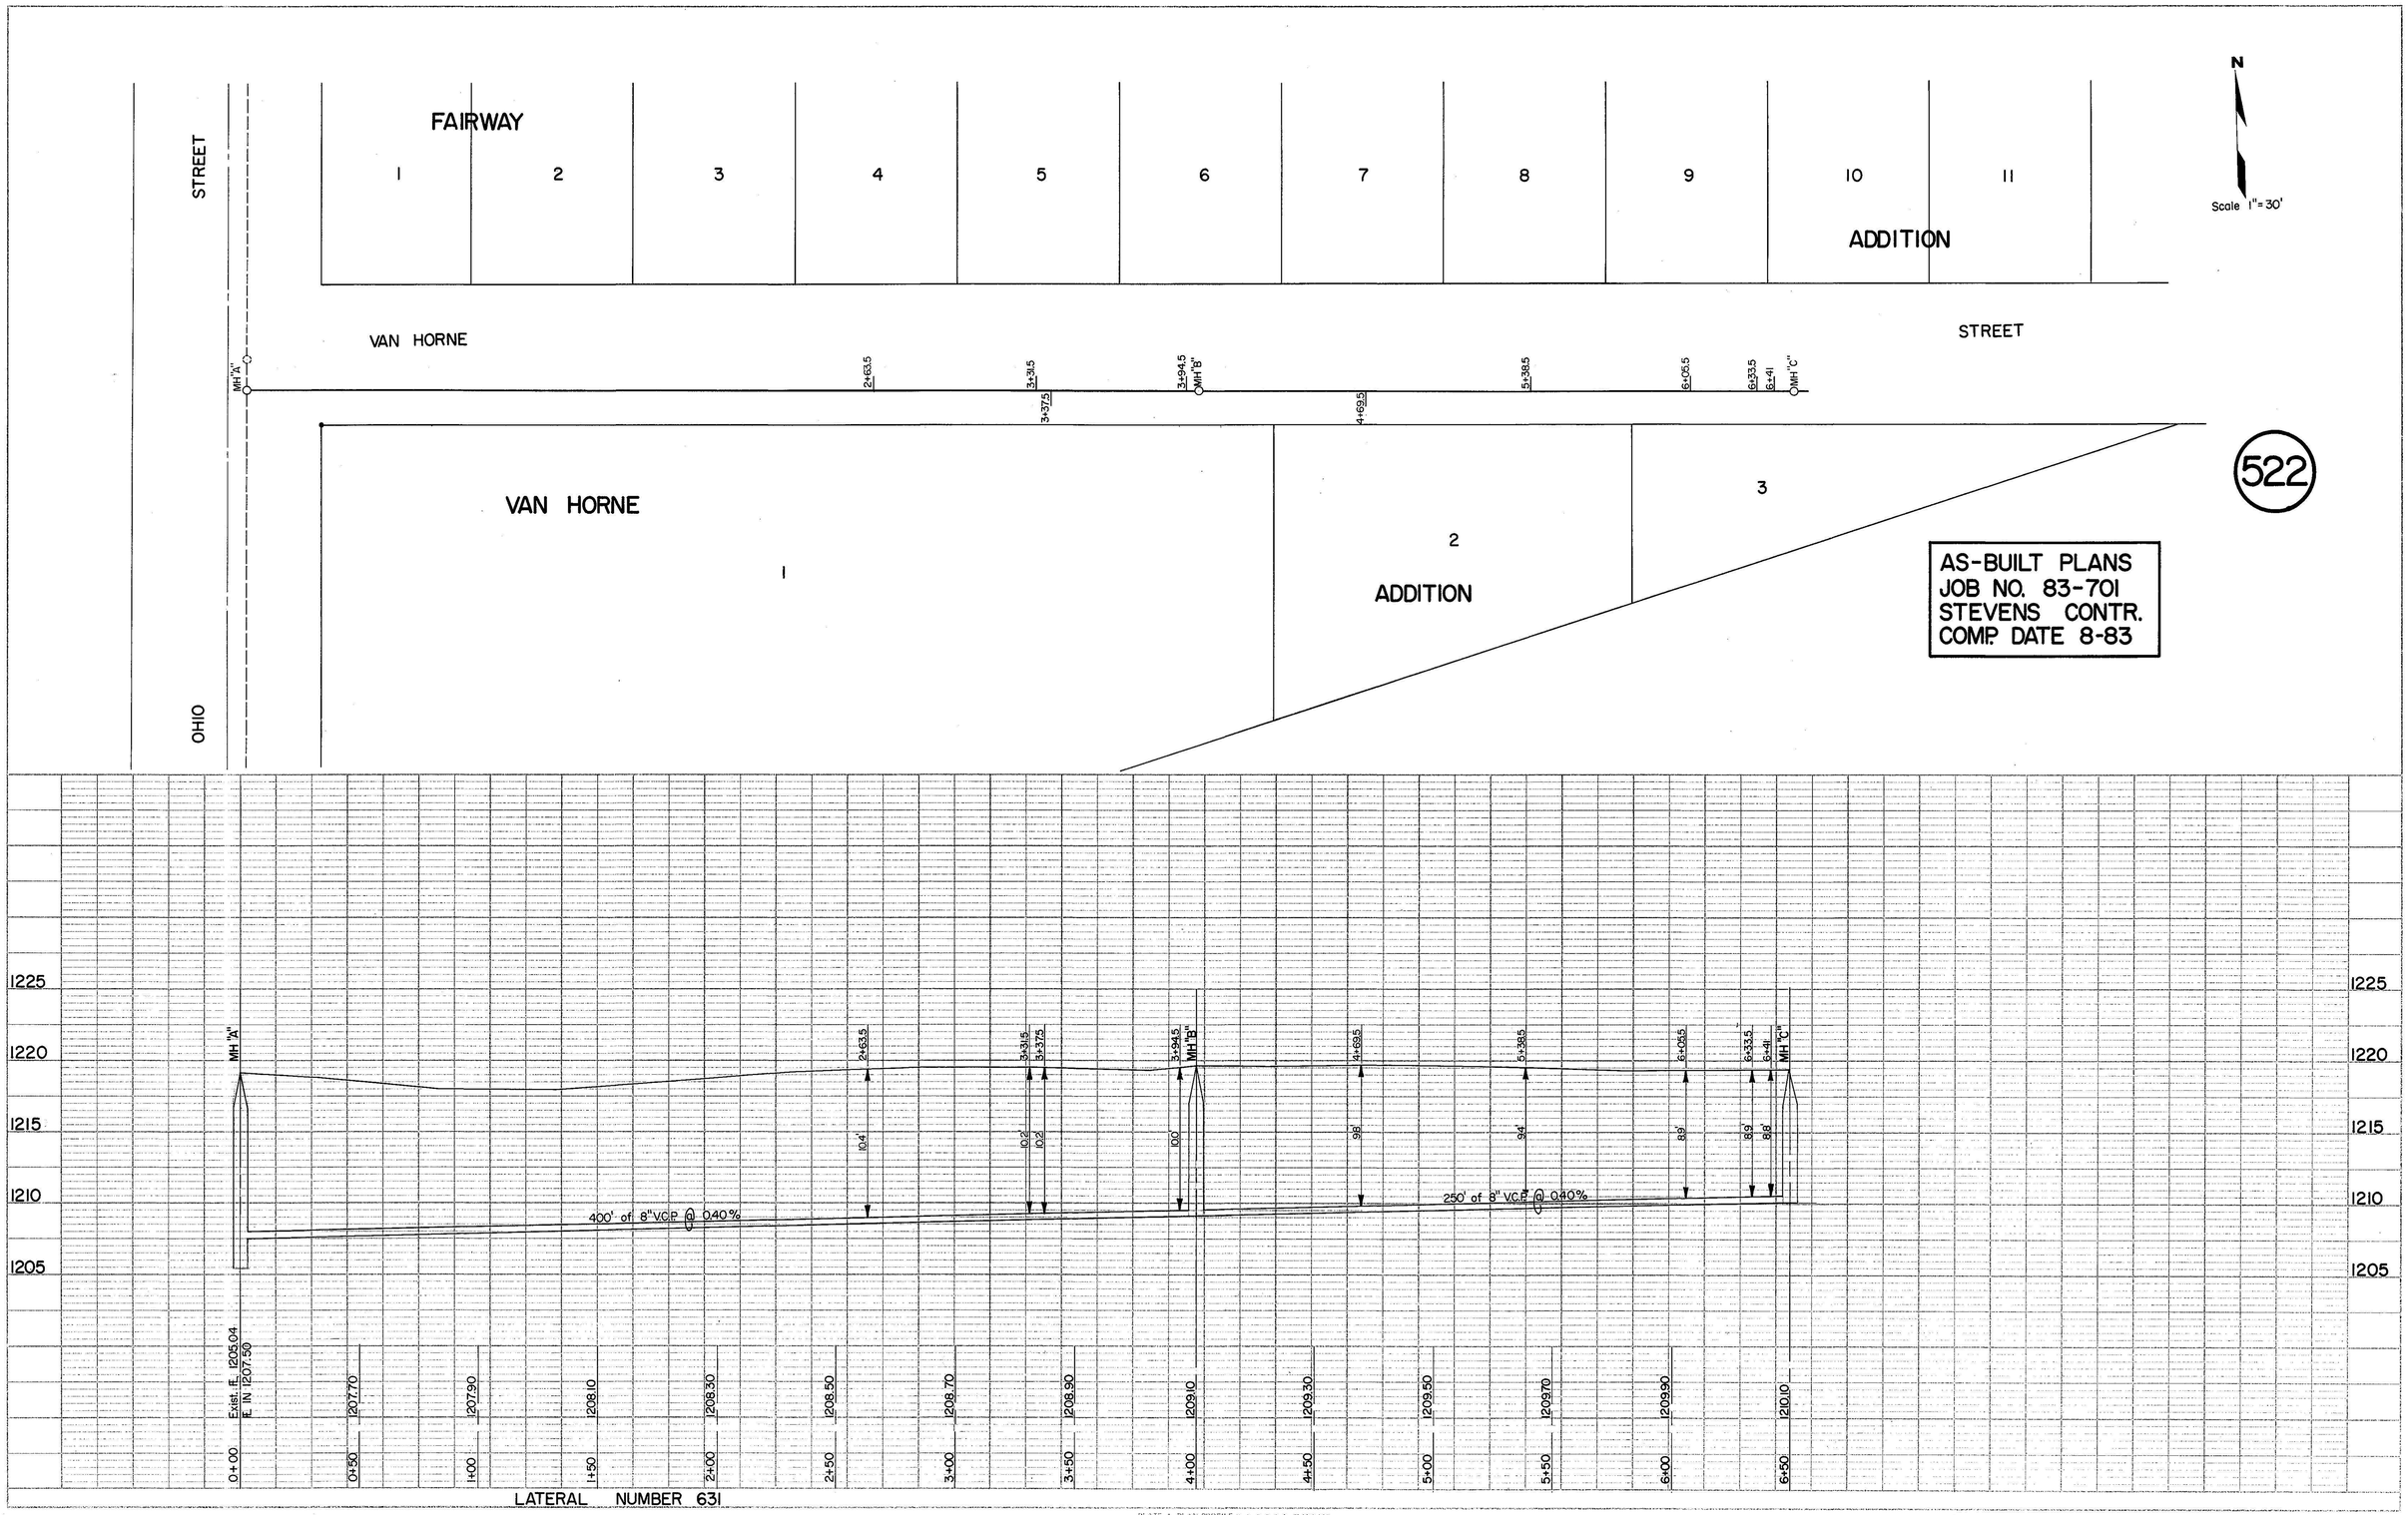

PLAN
NOTE BOOK
NO.
SURVEYED
PLOTTED
ALIGNMENT CHECKED
RT. OF WAY CHECKED
BY
DATE

PROFILE
NOTE BOOK
NO.
SURVEYED
PLOTTED
GRADES CHECKED
PROFILE CHECKED
STRUCTURE NOTE CHECKED
BY
DATE

PLATE 1 PLAN-PROFILE O. P. R. R. S. STANDARD
100% RAG PAPER—MADE AND PRINTED IN U.S.A.
LINTERS TRI-CENTRY CO.