523

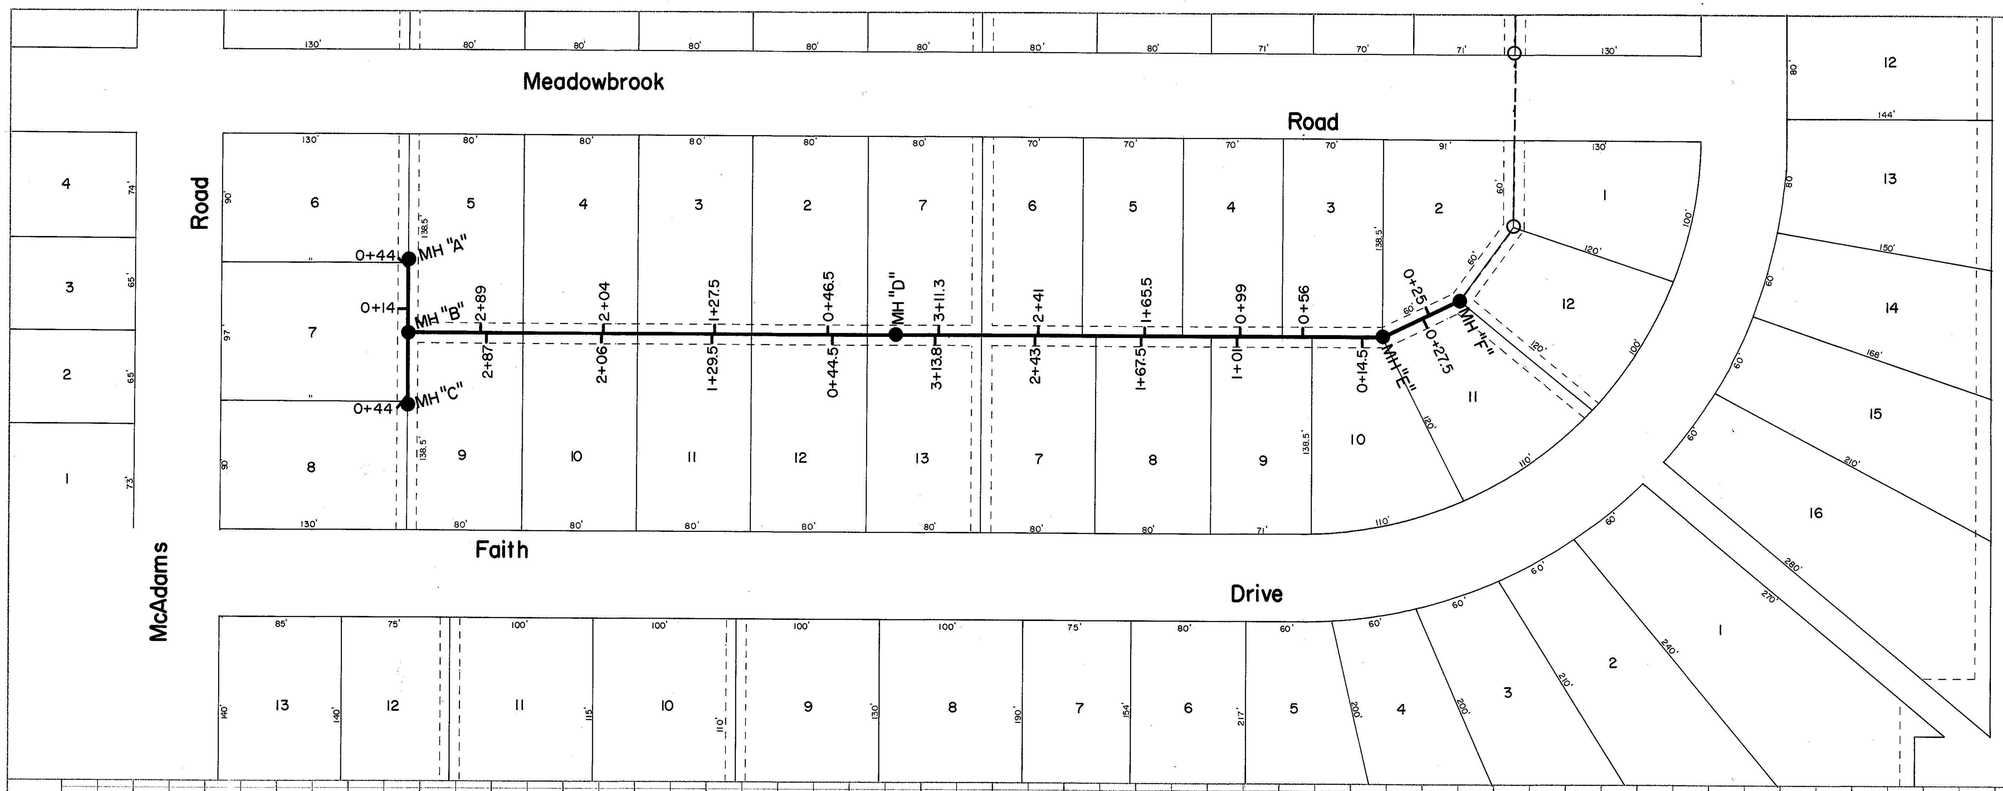

As-Built Plans
Proj. No. 84-717
Comp. Date - Feb. 85
Smoky Hill Inc.

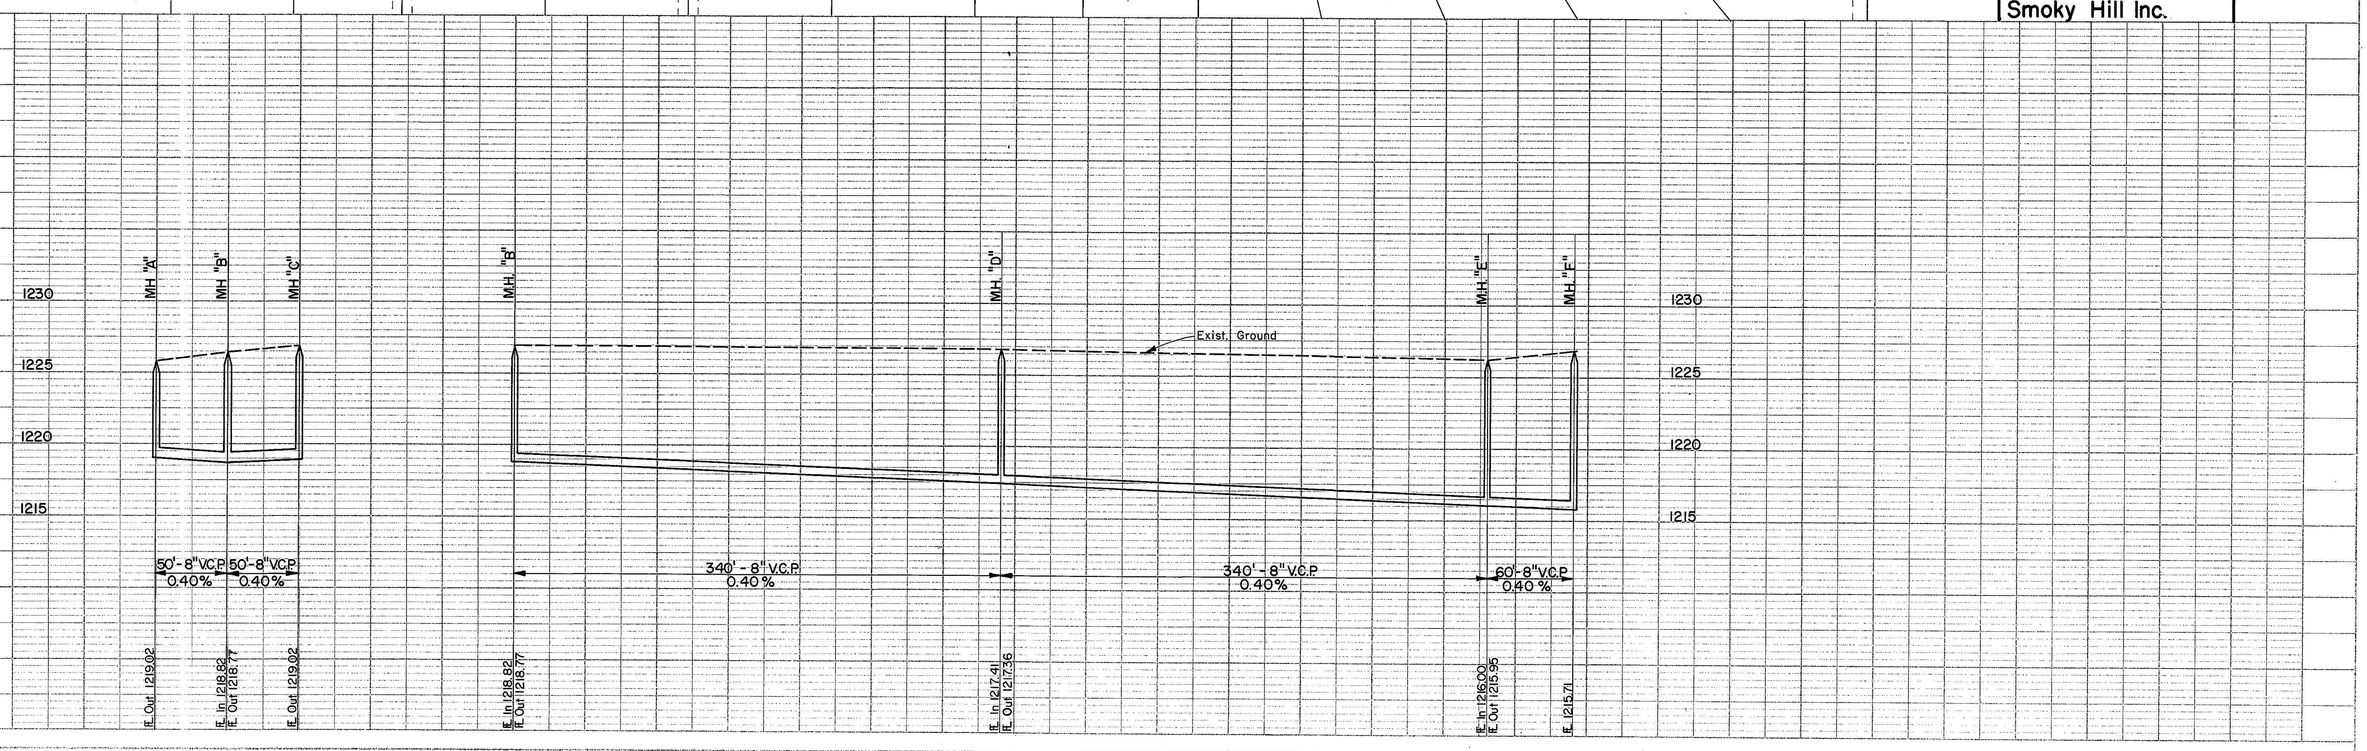

PLATE 1 PLAN-PROFILE A.P.W.A. & A.R.E. STANDARD
100-RAG MAPS—TRADE AND FIBERS IN U.S.A.
FEDERAL BERZON CO.