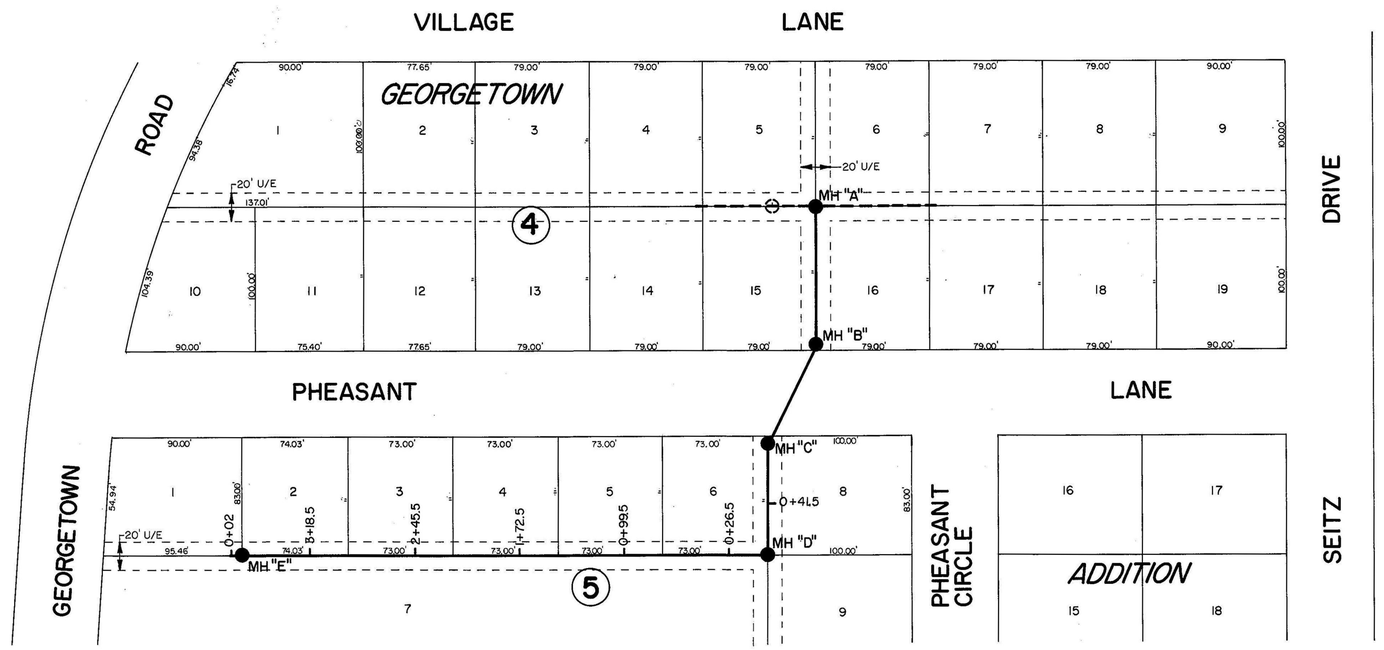

N

Scale 1"=50'

524

As – Builts Plans
Project No. 85-725
Wilson Const. Inc.
Comp. Date – 7/10/86

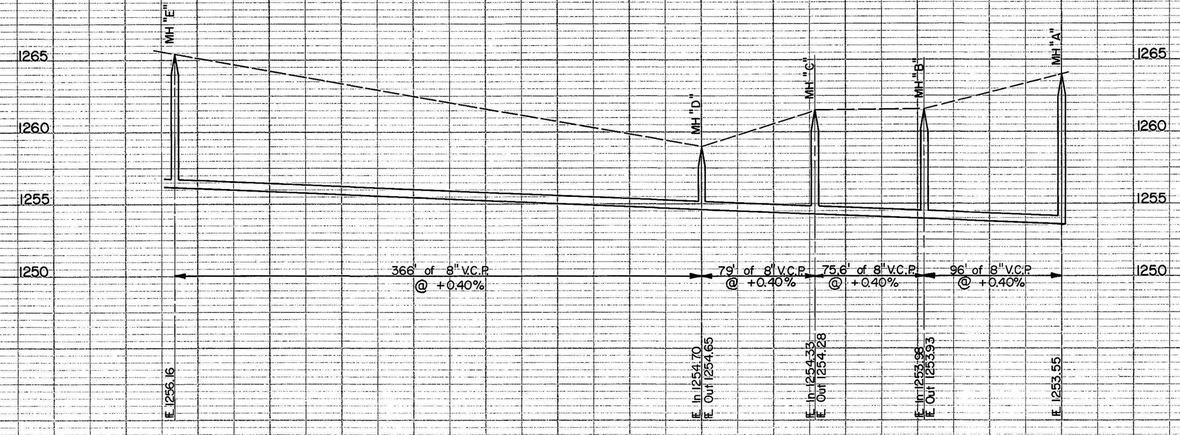

PLAN
SURVEYED
PLOTTED
ALIGNMENT CHECKED
ST. OF WAY CHECKED
BY
DATE
NOTE BOOK
NO.

PROFILE
SURVEYED
PLOTTED
GRADES CHECKED
B. M. NOTED
STRUCTURE NOTATIONS CHKD.
BY
DATE
NOTE BOOK
NO.

PLATE 1 PLAN-PROFILE C. P. R. R. R. L. STANDARD
MAP 340 PAPER—MADE AND PRINTED IN U.S.A.
HUGHES DIETZGEN CO.