525

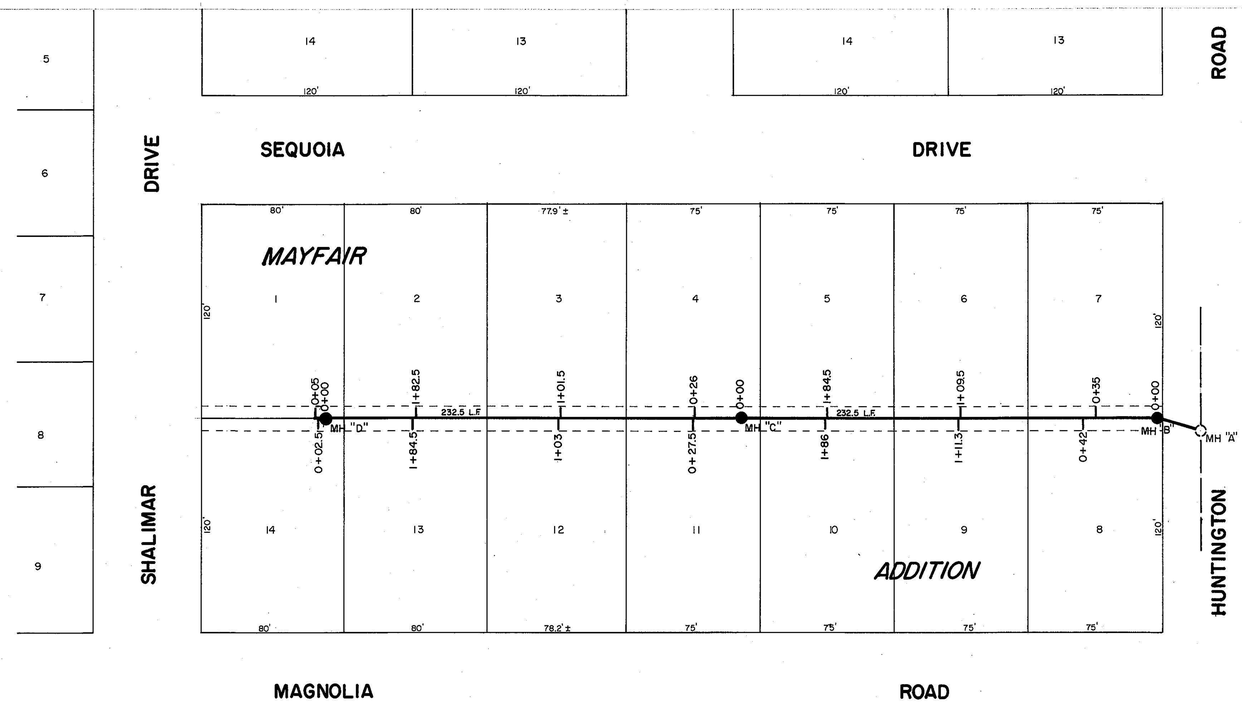

N

Scale 1" = 40'
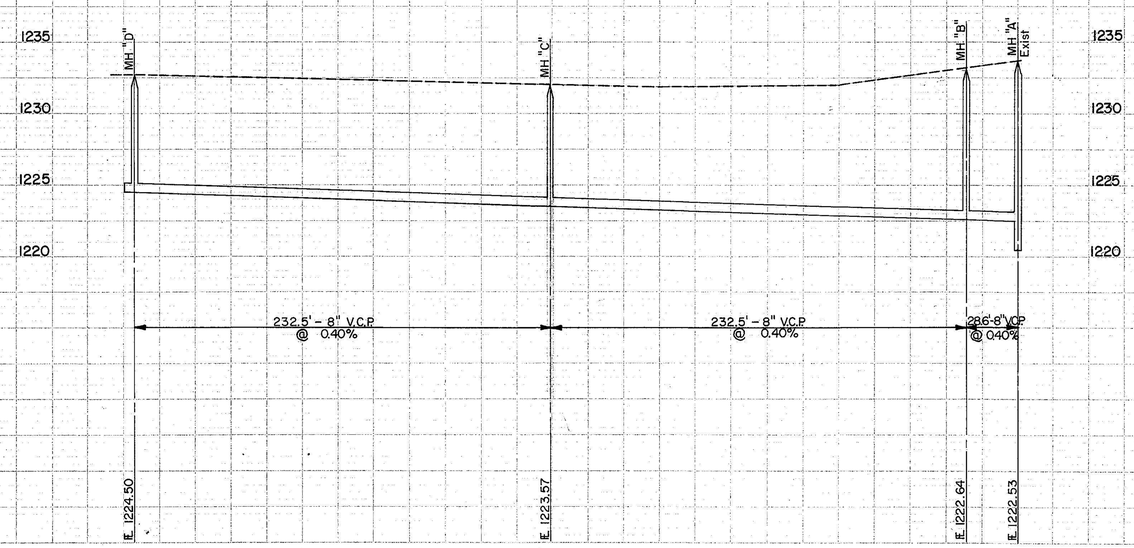
As-Built Plans
Project No. 85-725
Wilson Const. Inc.
Comp. Date - 7/10/86