526

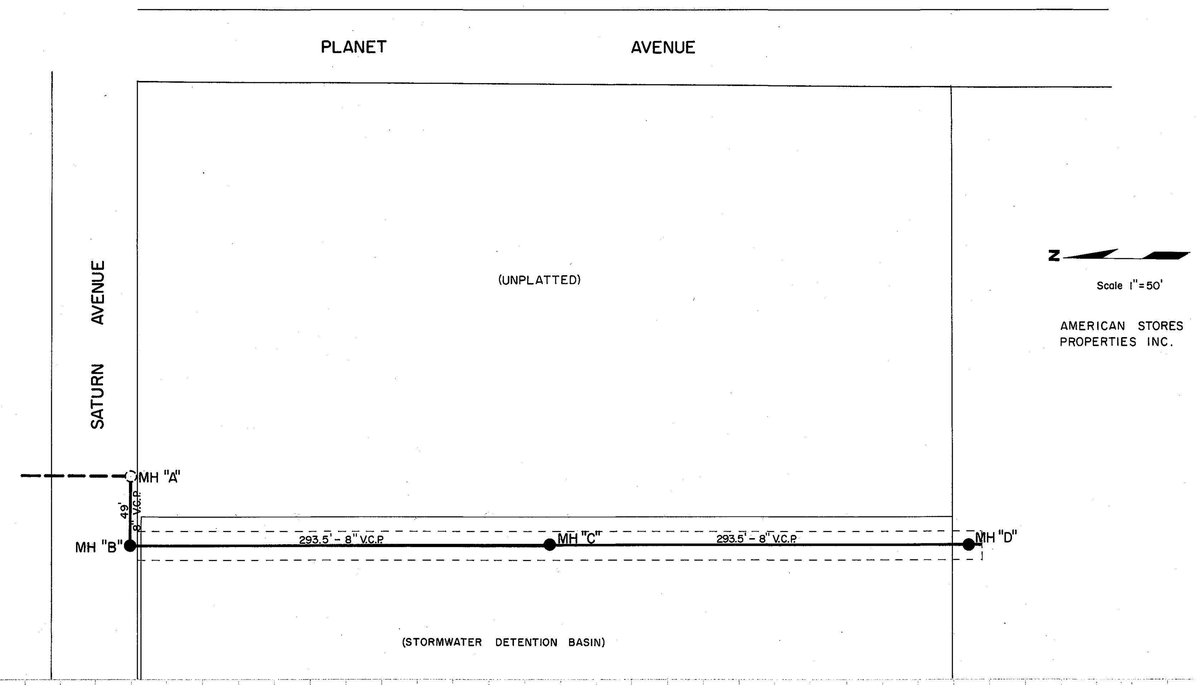

As-Built Plans
Project No. 85-725
Wilson Const. Inc.
Comp. Date - 7/10/86

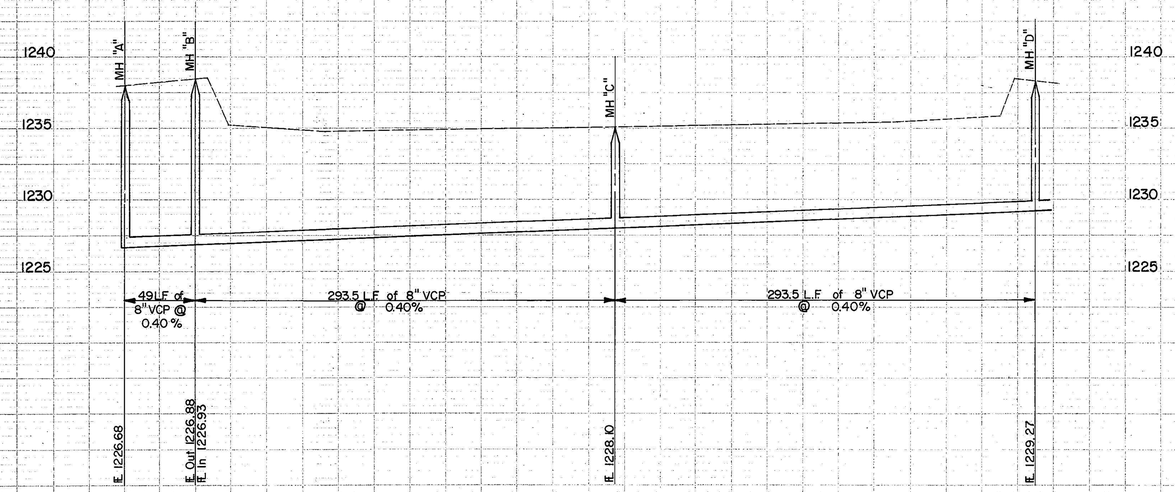

PLAN
PROFILE
NOTE BOOK: ACCEPTED
No.
DATE
BY
SURVEYED
PLOTTED
DRAWN
CHECKED
R.O.W. NOTED
STRUCTURE NOTATIONS CHECKED

