Scale 1"= 100'

528

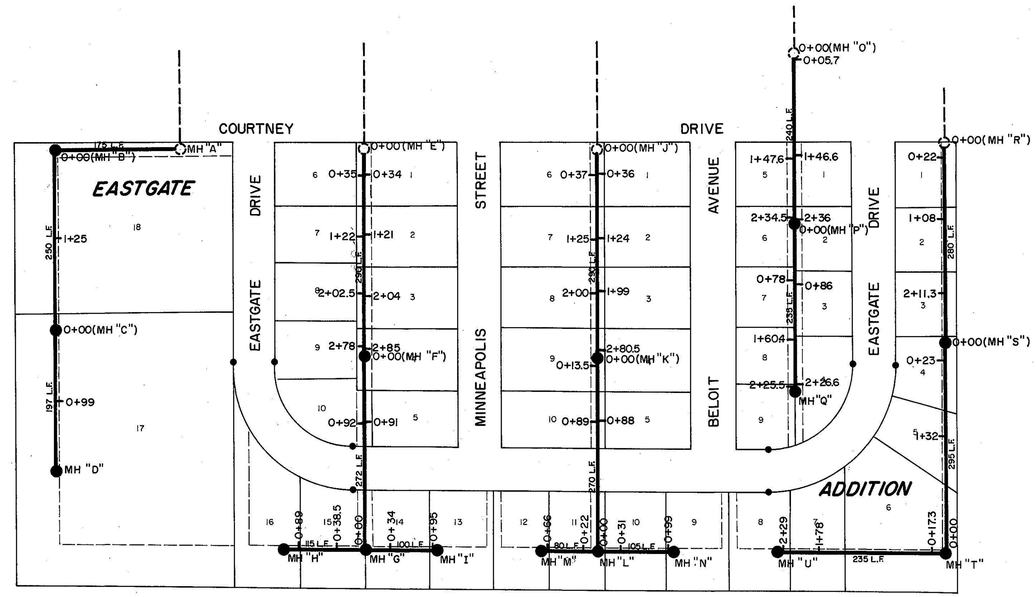

As-Built Plan
Project No. 85-725
Wilson Const. Inc.
Comp. Date - 7/10/86

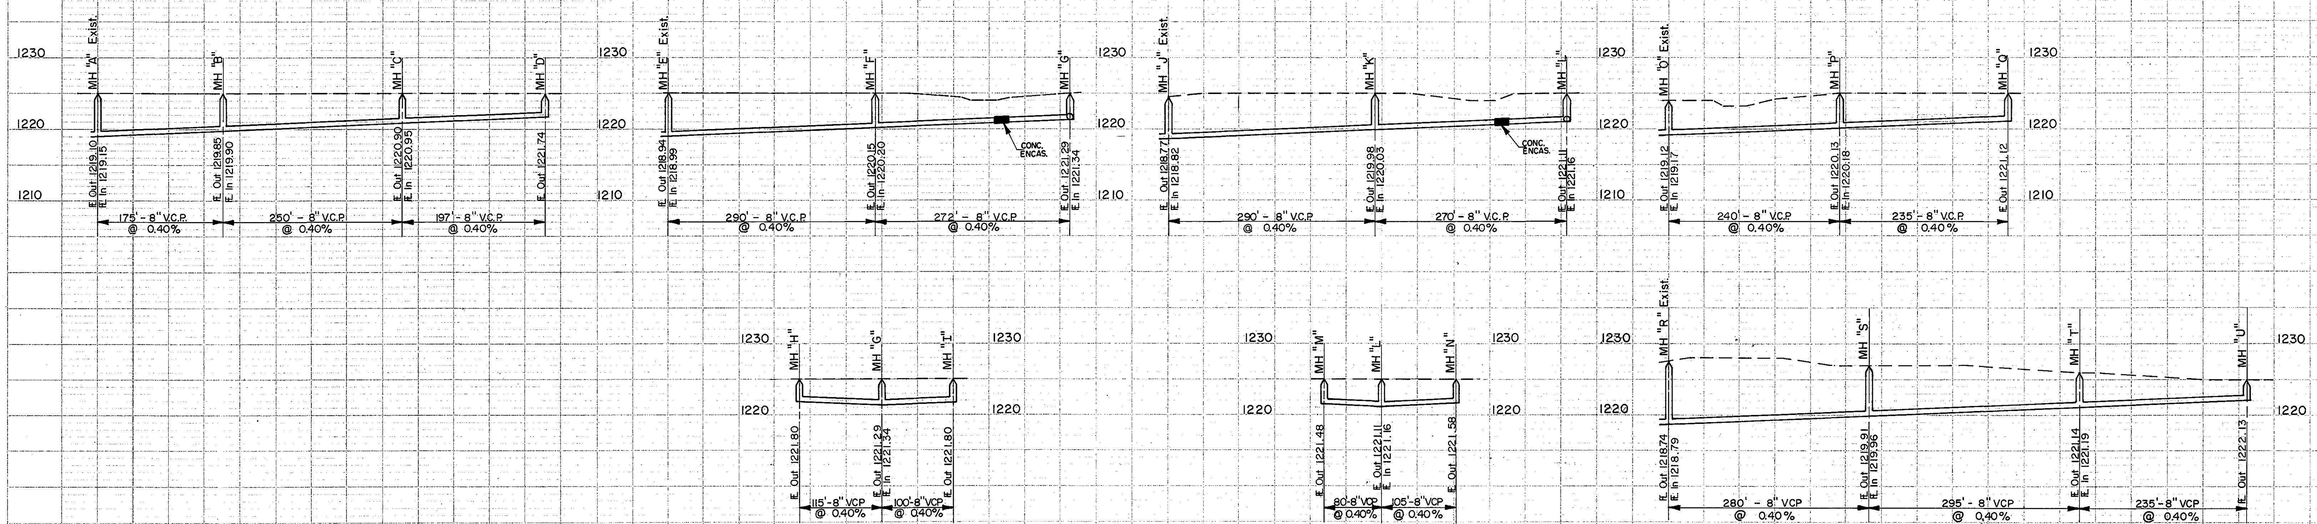

PLAN
SURVEYED
PLOTTED
NOTE BOOK: PLOTTING CHECKED
No.
DATE
BY

PROFILE
SURVEYED
PLOTTED
NOTE BOOK: PLOTTING CHECKED
E. & V.S. NOTED
No.
STRUCTURE NOTATIONS CHECKED
DATE
BY

GREAT STATE PRINTING DIV. 86000
PLATE 1-SINGLE PLAN AND PROFILE/FULL LINE
7/2/86/5000
PRINTED IN U.S.A.