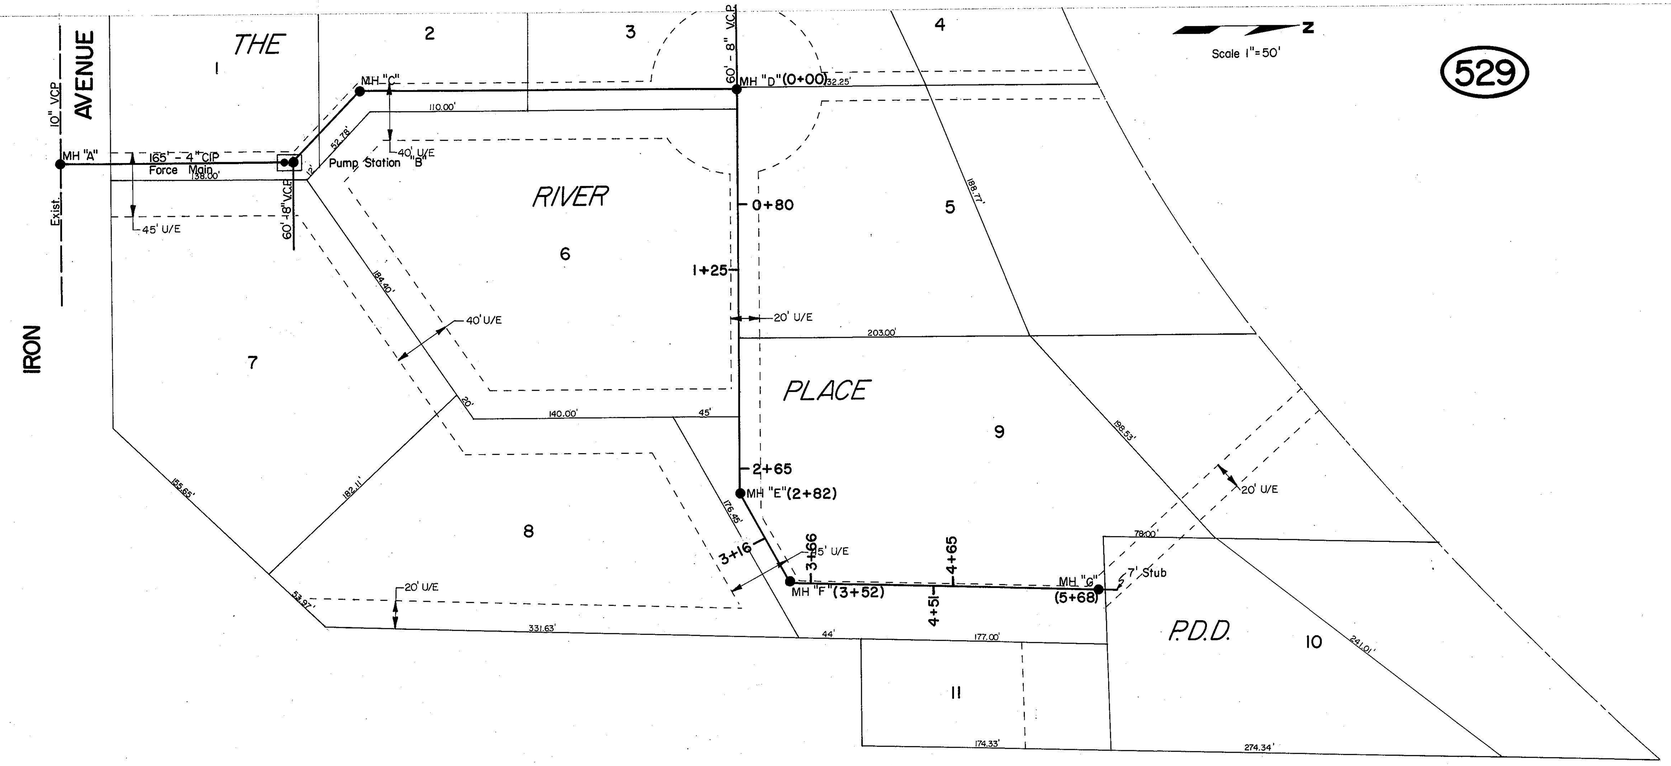

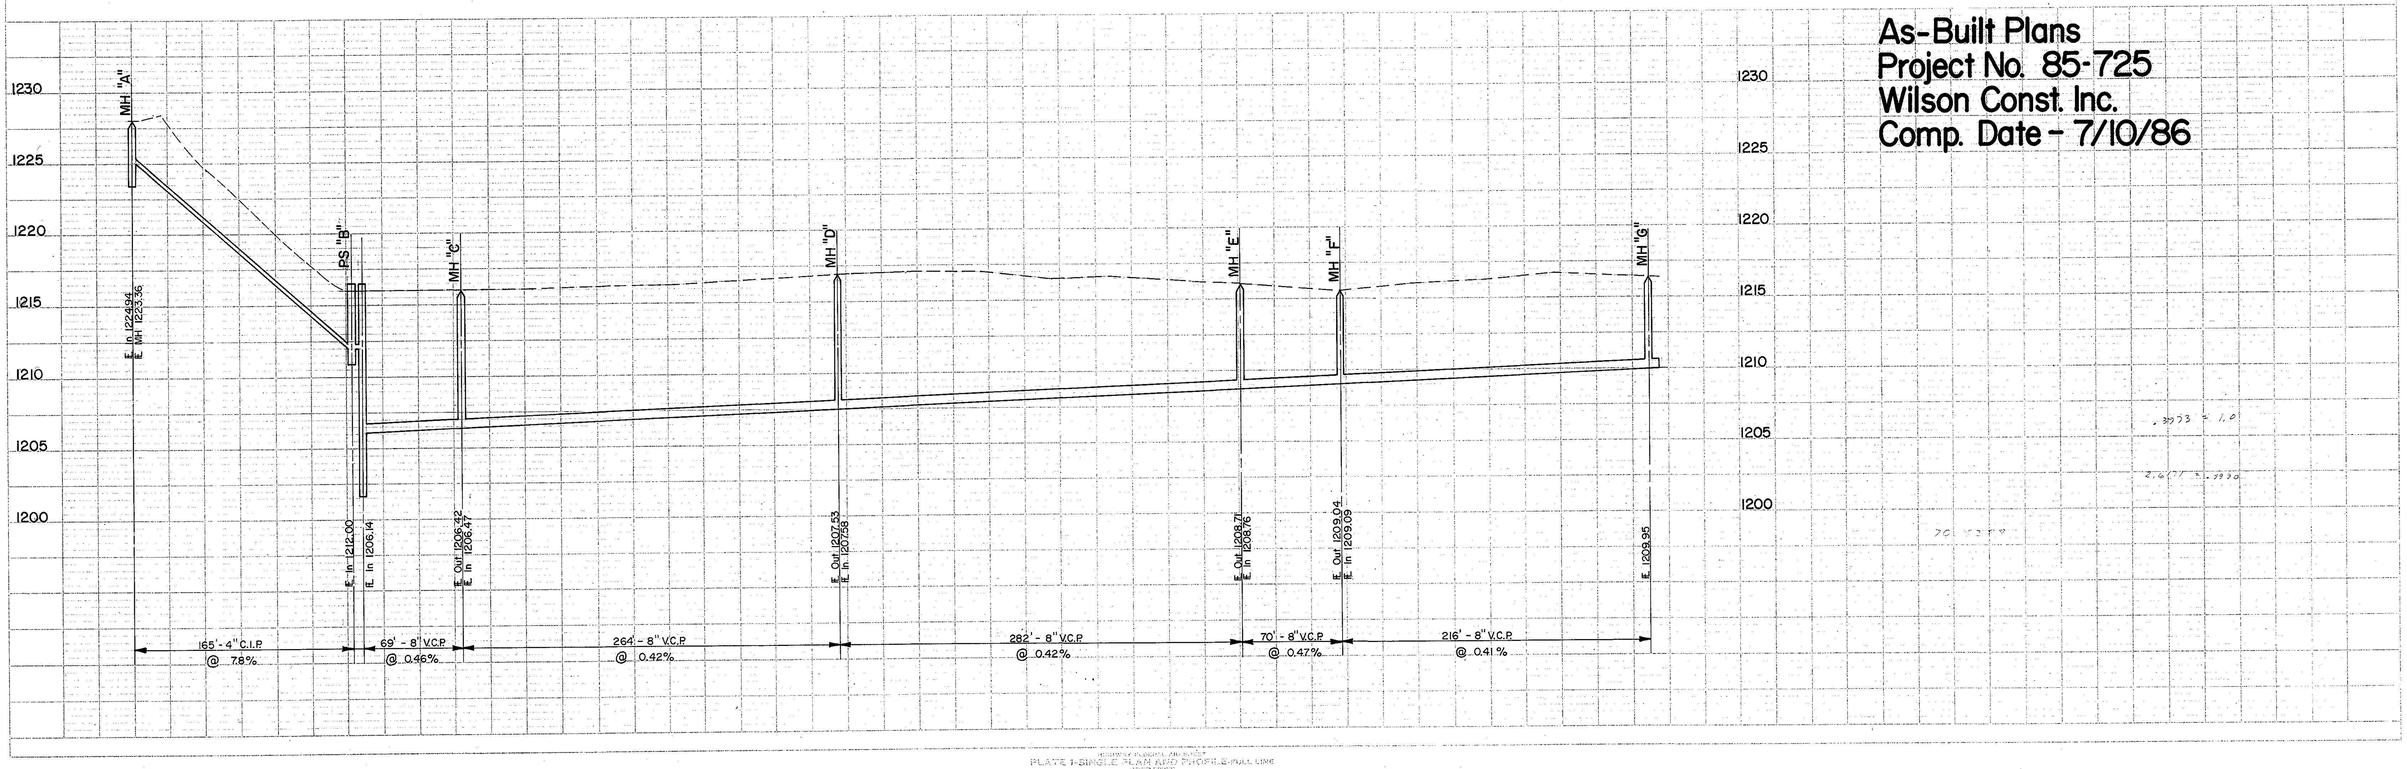

As-Built Plans
Project No. 85-725
Wilson Const. Inc.
Comp. Date - 7/10/86

PLATE 1-SINGLE PLAN AND PROFILE-FULL LINE