530

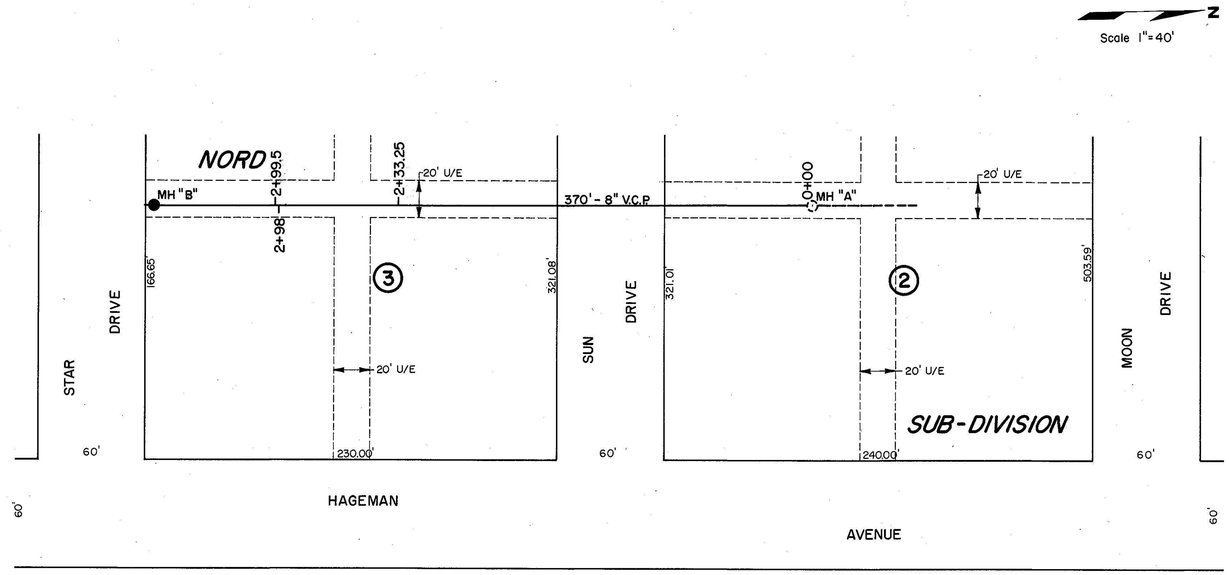

As-Built Plan
Project No. 85-725
Wilson Const. Inc.
Comp. Date - 7/10/86

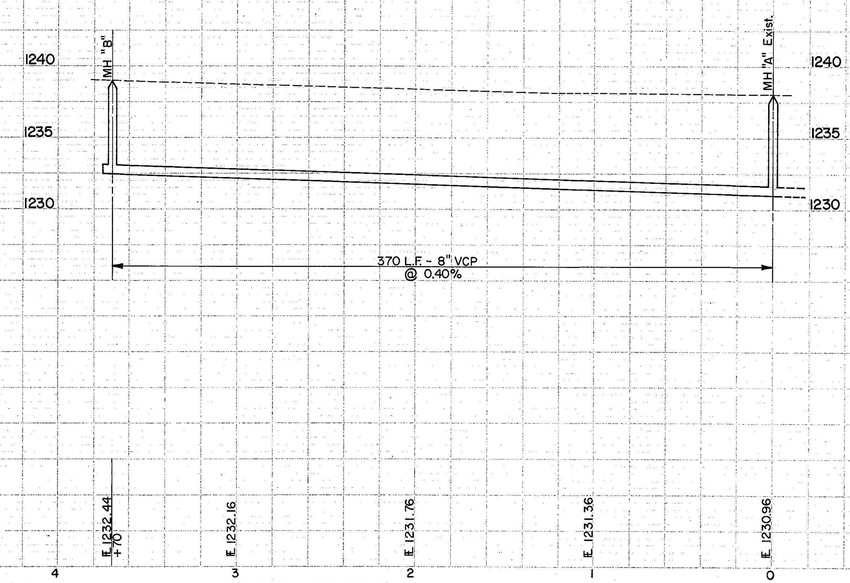

PLAN
NOTE BOOK
No.
SURVEYED
PLOTTED
COORDS. CHECKED
SL. OF WAY CHECKED
BY
DATE

PROFILE
NOTE BOOK
No.
SURVEYED
PLOTTED
GRADES CHECKED
B. M.'S NOTED
STRUCTURE MEASUREMENTS CHECKED
BY
DATE