532

AS-BUILT PLANS
PROJECT NO. 87-752
WILSON CONST.
COMP. DATE - 11/87

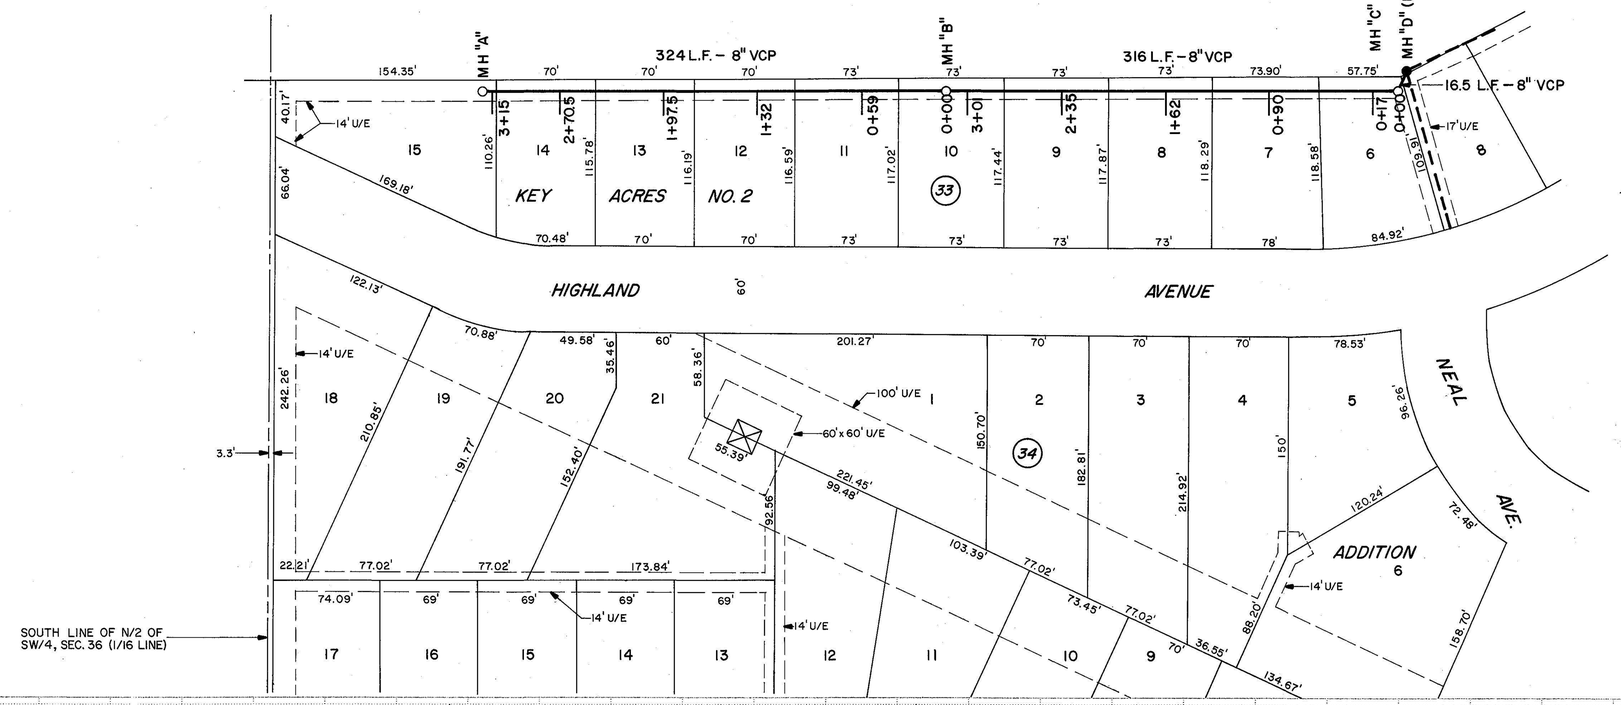

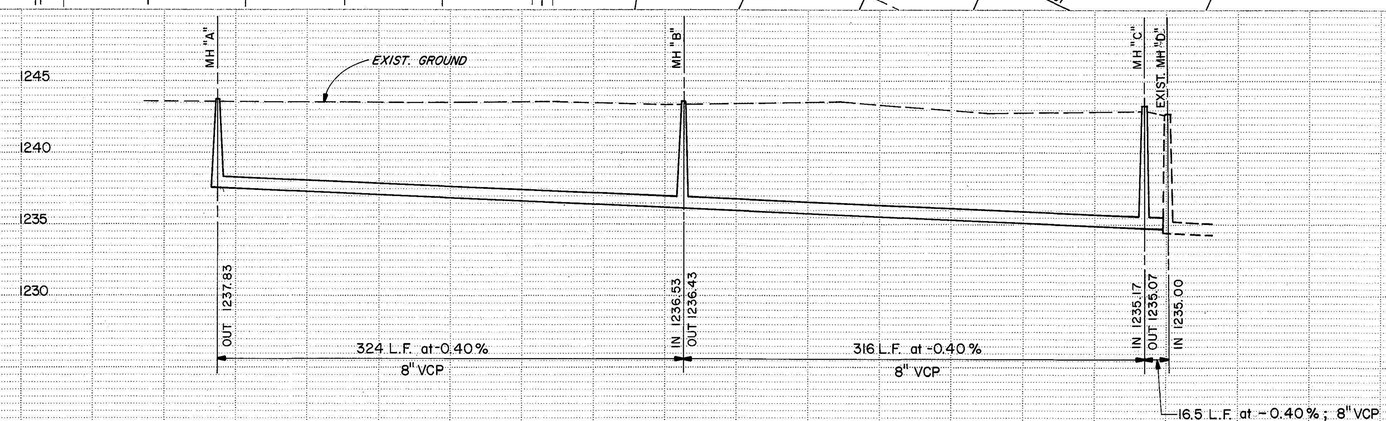

PLAN — SURVEYED, PLOTTED, ALIGNMENT CHECKED AT 1" = 50' — NOTE BOOK NO. — BY — DATE

PROFILE — SURVEYED, PLOTTED, GRADES CHECKED AT 1" = 10' — NOTE BOOK NO. — BY — DATE — STRUCTURE NO. AT MS CH. NO.