533

# AS-BUILT PLANS
# PROJECT NO. 87-752
# WILSON CONST.
# COMP. DATE 11/87

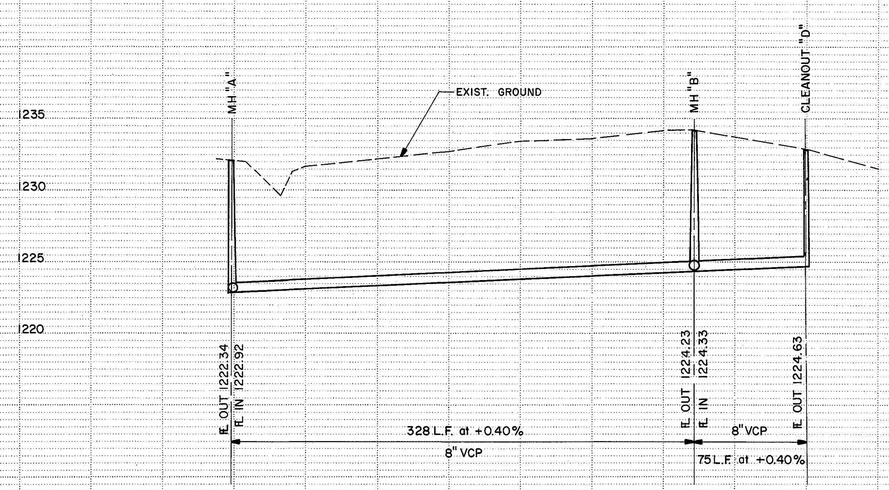


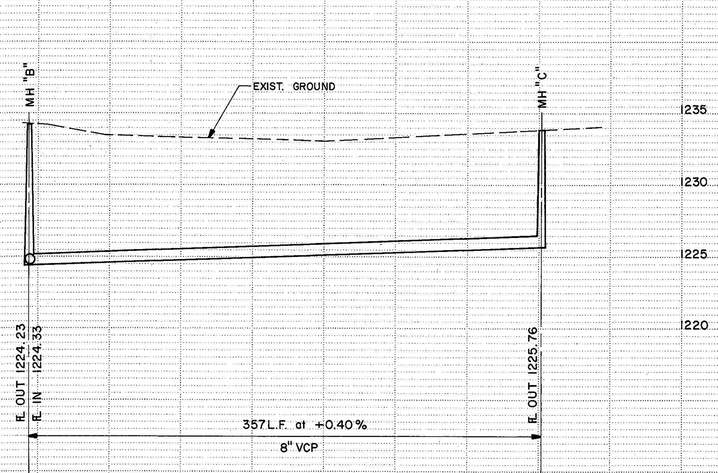


PLAN
SURVEYED
PLOTTED
NOTE BOOK ALIGNMENT CHECKED
NO. RT. OF WAY CHECKED
BY
DATE

PROFILE
SURVEYED
PLOTTED
NOTE BOOK GRADES CHECKED
NO. B.M. NOTE
STRUCTURE NOTATION CHKD.
BY
DATE